


- RAMP PAVING**
- LEGEND**
- (A) Concrete Pavement (Water Cement Ratio) 10"
  - (E) Monolithic Curb (Type A) 6"
  - (G) 4" Topsoil & Broadcast Seeding (Type 4)

Note \*  
For "Partial Section for Retaining Wall" and additional information, see "Typical Sections" Sheets No. R1 and R2.

CURVE KS-N5		CURVE KS-N6	
PT.		PT.	
N.	475, 174.127	N.	475, 278.589
E.	2,208, 251.924	E.	2,208, 273.742
D =	7°35'31"	D =	8°09'55"
R =	4°00'00"	R =	3°56'52"
T =	1,432.39'	T =	1,451.39'
L =	95.04'	L =	103.60'
			206.84'

Bench Mark #9  
Chiseled "I" on northeast corner of 2nd inlet on south side of Westgrove Drive, 500' west of Dallas Parkway. Elev. 620.80

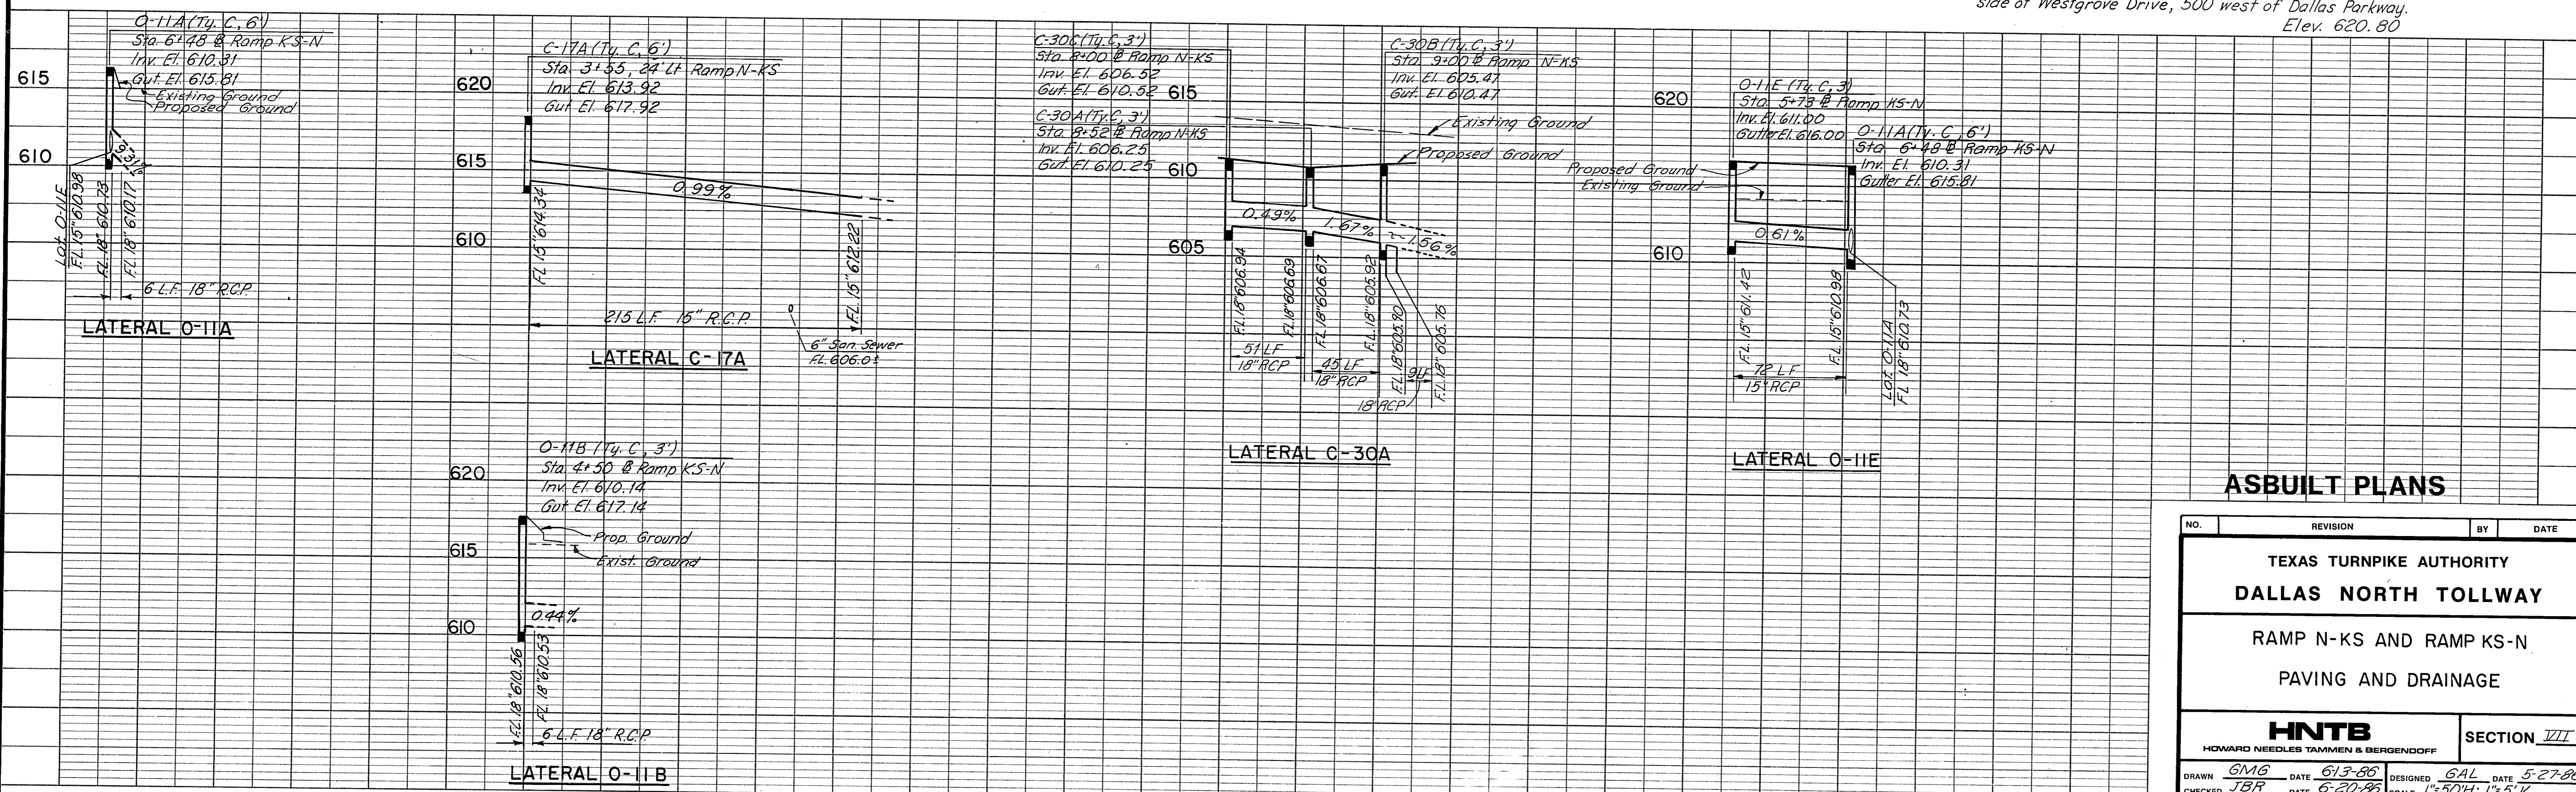

**ASBUILT PLANS**

NO.	REVISION	BY	DATE
TEXAS TURNPIKE AUTHORITY <b>DALLAS NORTH TOLLWAY</b> RAMP N-KS AND RAMP KS-N PAVING AND DRAINAGE			
<b>HNTB</b> <small>HOWARD NEEDLES TAMMEN &amp; BERGENDOFF</small>		SECTION VII	
DRAWN <u>GMB</u> DATE <u>6-13-86</u> CHECKED <u>IBR</u> DATE <u>6-20-86</u>	DESIGNED <u>GAL</u> DATE <u>5-27-86</u> SCALE <u>1"=50'; 1"=5'</u>		
CONTRACT NO. <u>DNT-115</u> SHEET <u>R18B</u> OF <u>R85</u>			