


615

610

605

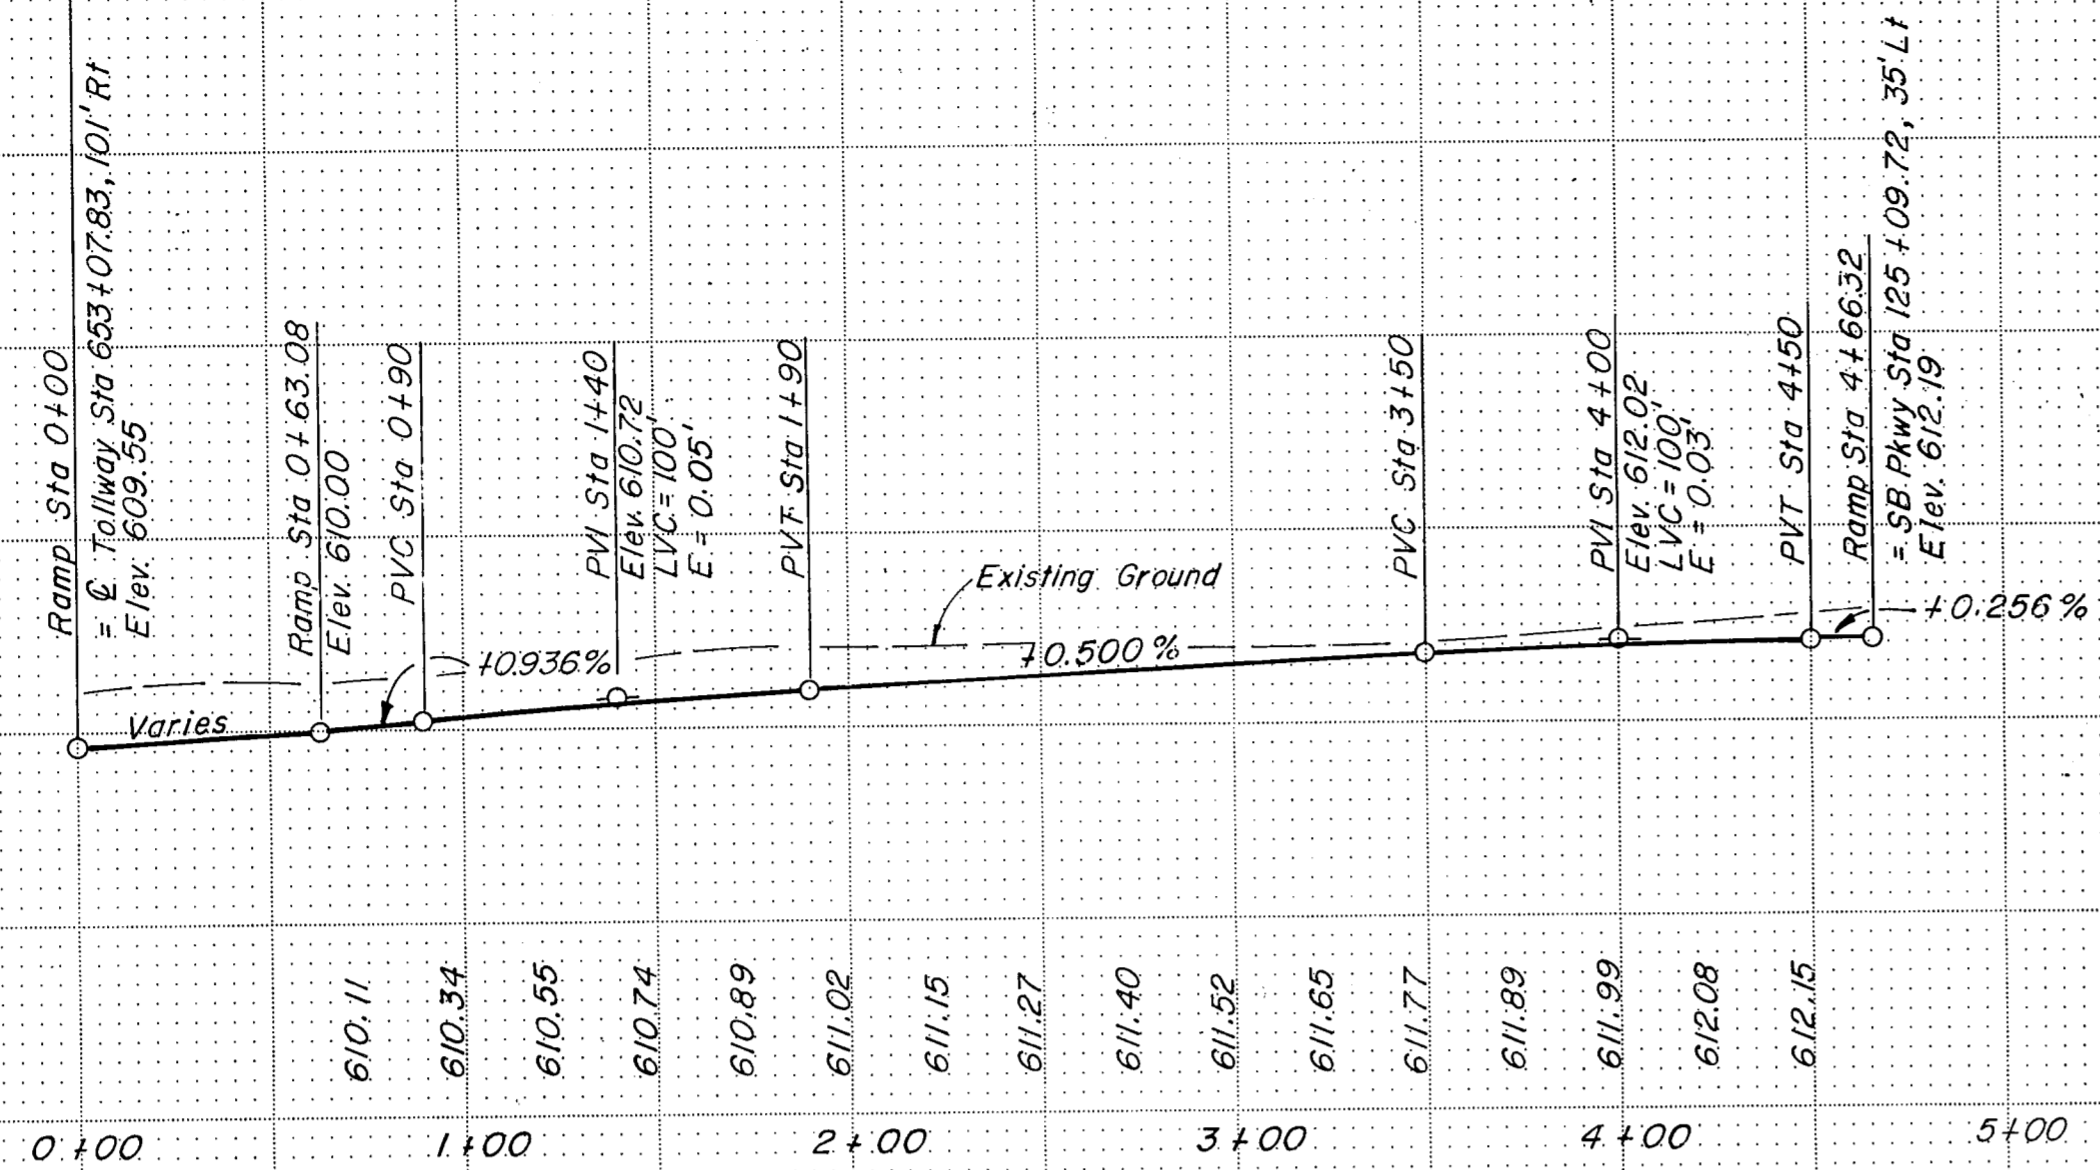


RAMP S-KS

615

610

605

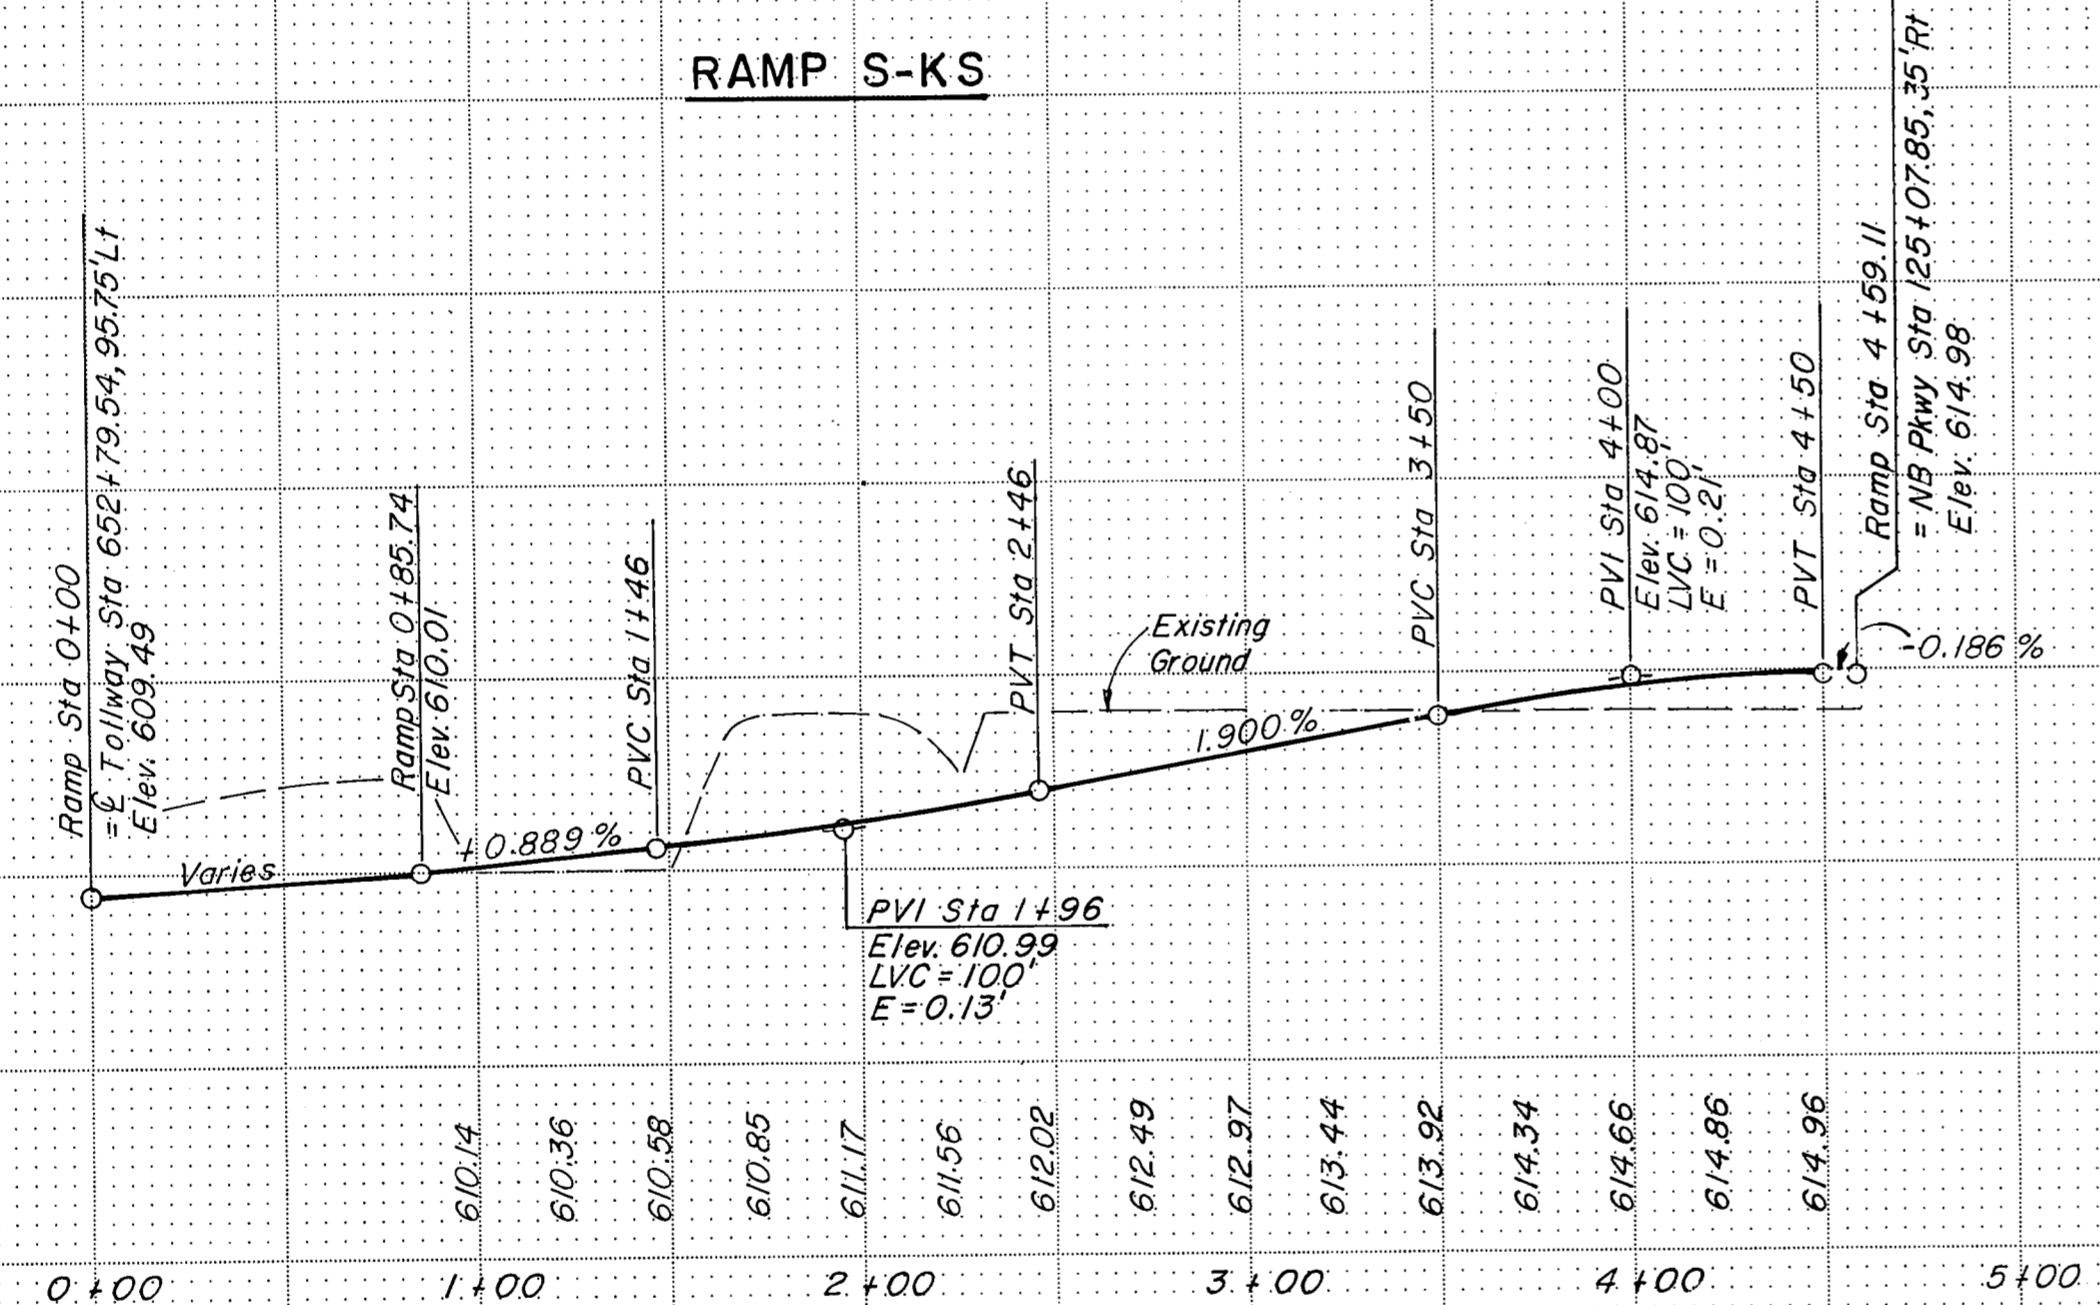

RAMP KS-S

NOTE: See Paving Plan Sheets R27 And R28 For Additional Elevations

ASBUILT PLANS

TEXAS TURNPIKE AUTHORITY
DALLAS NORTH TOLLWAY

RAMP PROFILES

Gibbs & Hill, Inc.

MADE MGB DATE 4/24/84 TRACED MAV DATE 4/26/84
CHECKED DWC DATE 7/28/84 SCALE 1"=50' Hor 1"=5' Vert

CONTRACT NO. DNT-115 SHEET R25 OF R85