


- Notes:
1. All pavement contours shown are finished top of pavement elevations.
 2. See Standard Drawings for joints and joint spacing.

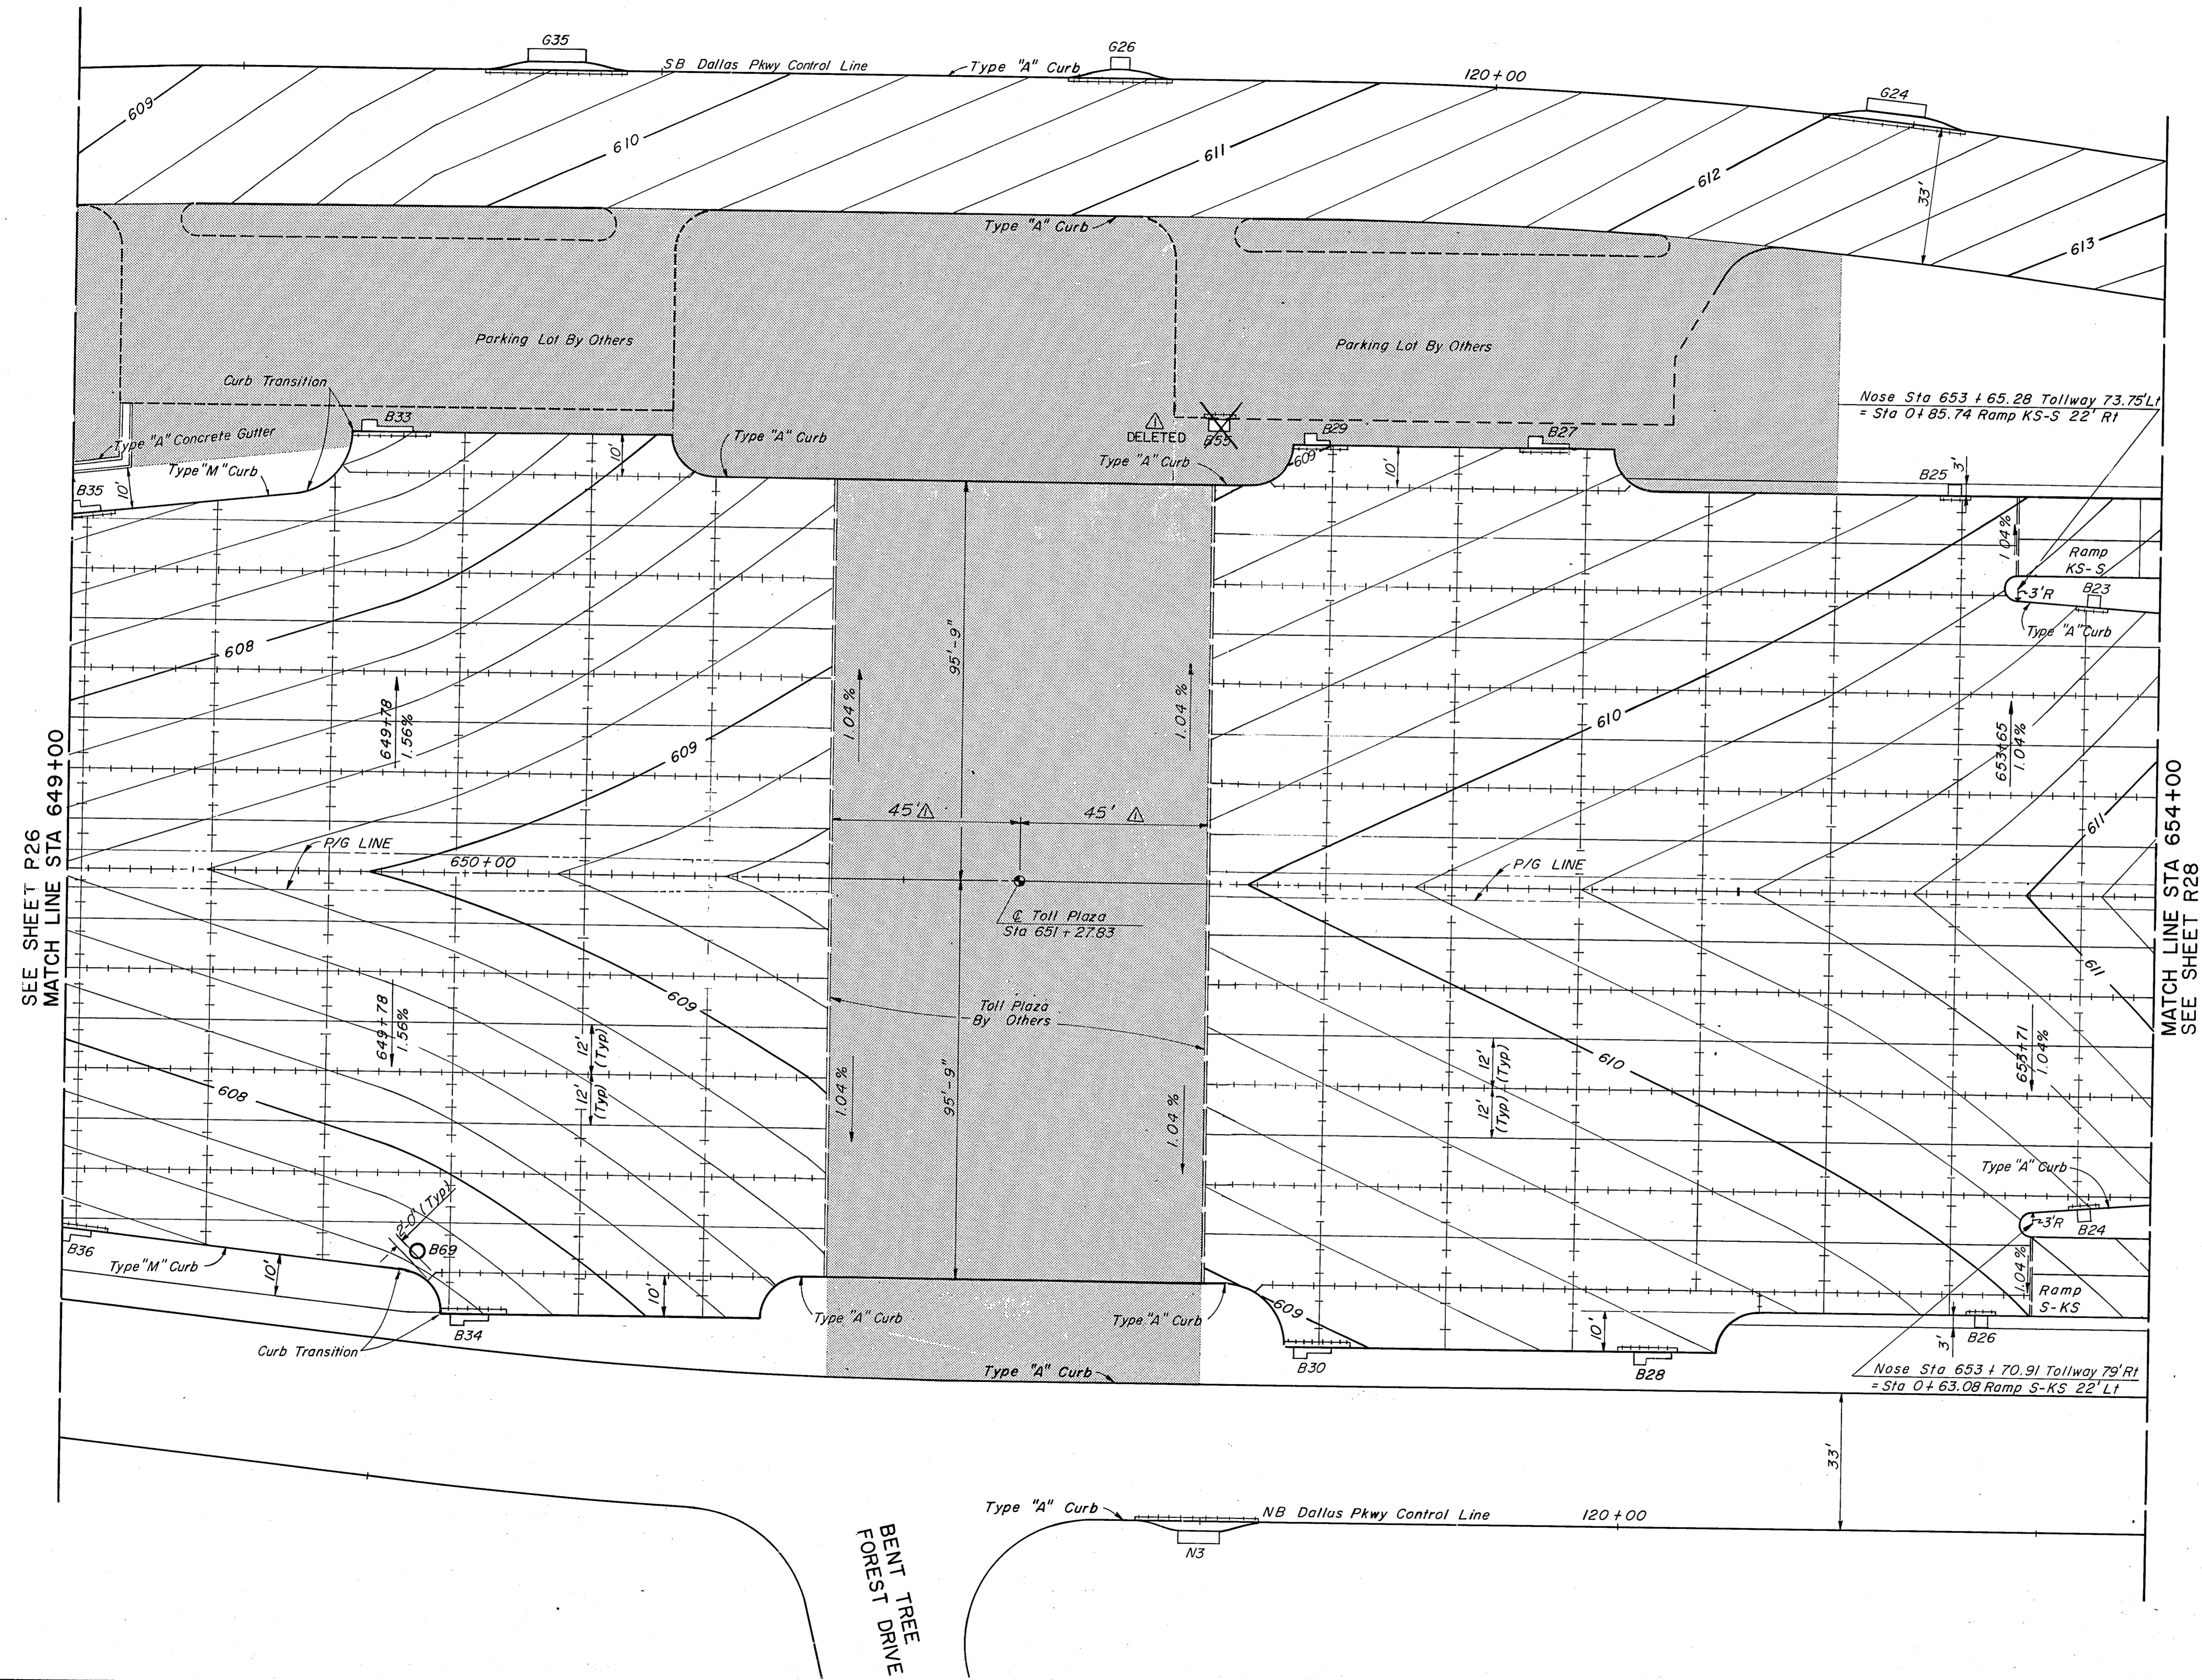

SEE SHEET P26
MATCH LINE STA 649+00

MATCH LINE STA 654+00
SEE SHEET R28

- LEGEND**
- ++++ Longitudinal Construction Joint (LC)
 - Sawed Longitudinal Joint (SL)
 - ==== Transverse Expansion Joint (E)
 - ++++ Transverse Contraction Joint (SC)
 - ▨ Building Project Limits

ASBUILT PLANS

NO.	AS BUILT PLANS	PJ	1-11-88
	REVISION	BY	DATE

TEXAS TURNPIKE AUTHORITY
DALLAS NORTH TOLLWAY

PAVING PLAN
TOLL PLAZA AREA

Gibbs & Hill, Inc.
ENGINEERS DESIGNERS CONSTRUCTORS
DALLAS

SECTION VII

DRAWN	AELT	DATE	5/12/83	DESIGNED	MGB	DATE	5/5/83
CHECKED	DWC	DATE	5/14/84	SCALE	1" = 20'		

CONTRACT NO. DNT-115 SHEET R27 OF R85

BENT TREE
FOREST DRIVE