


AIRPORT PARKWAY



- Notes:
1. All pavement contours shown are finished top of pavement contours.
  2. See Standard drawings for joints and joint spacing.

SEE SHEET R27  
MATCH LINE STA 654+00

END STA 660+00

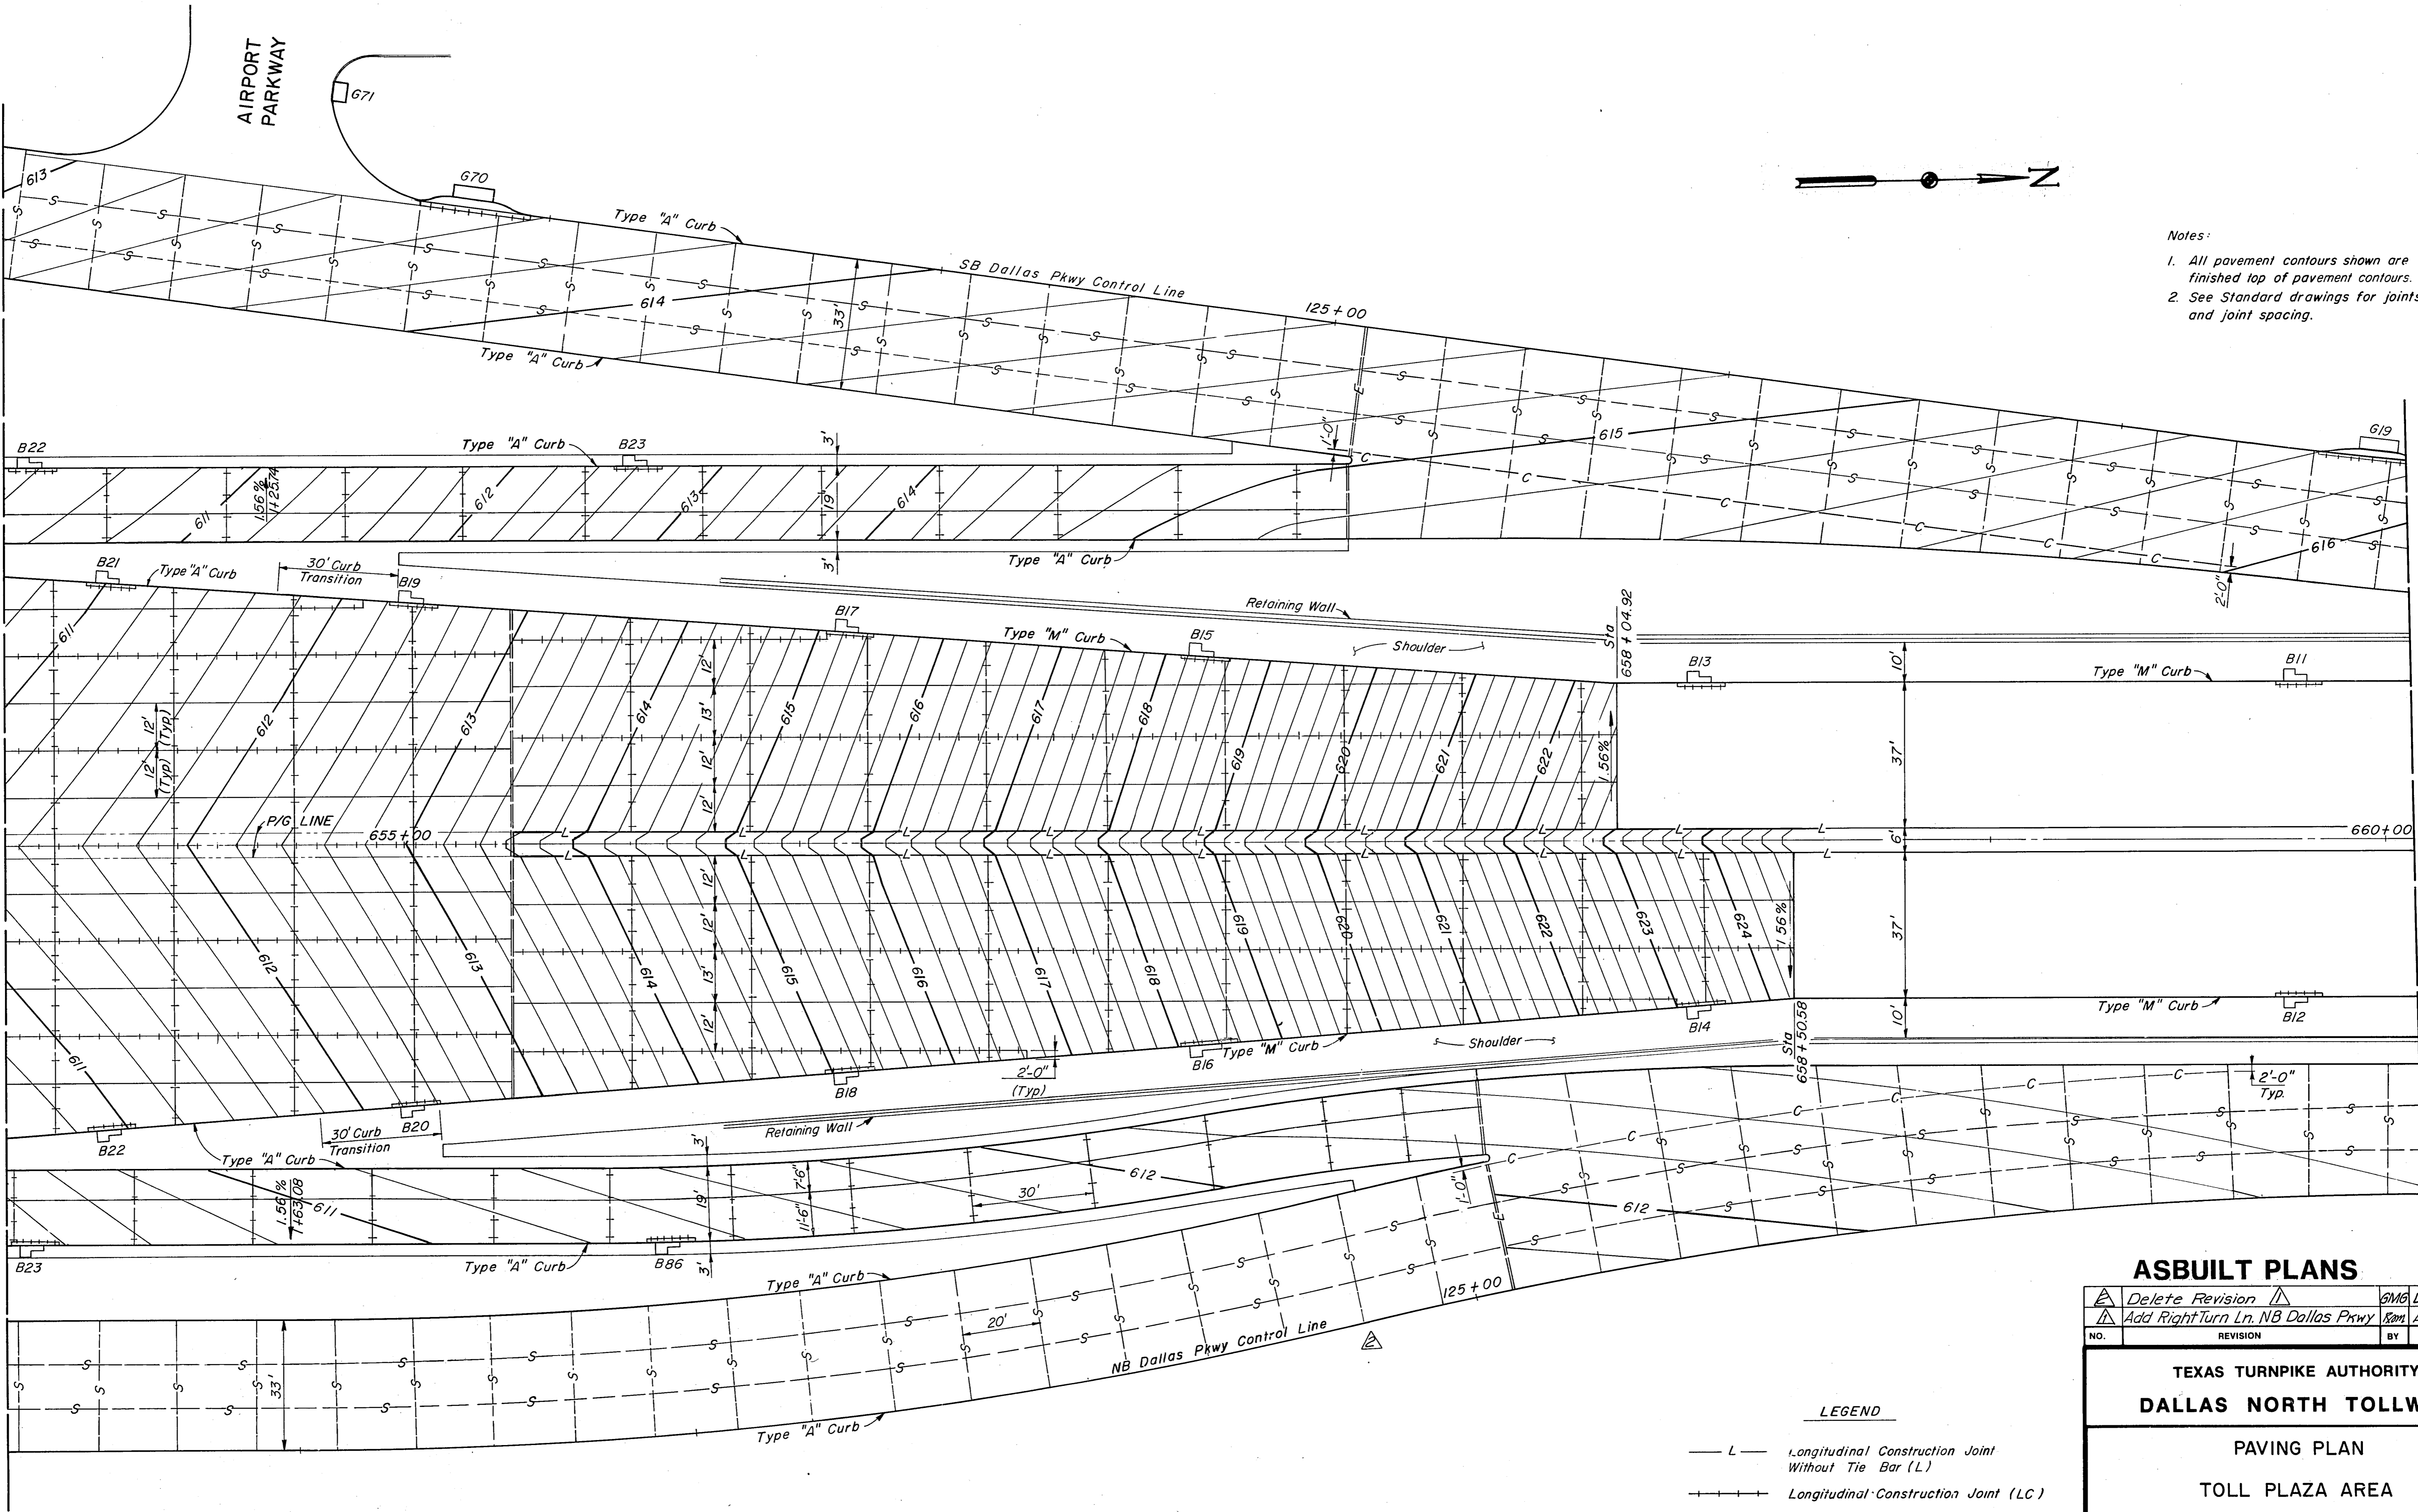

LEGEND

- L — Longitudinal Construction Joint Without Tie Bar (L)
- ++++ Longitudinal Construction Joint (LC)
- ===== Sawed Longitudinal Joint (SL)
- == E == Transverse Expansion Joint (E)
- ++++ Transverse Contraction Joint (SC)
- S --- Sawed Dummy Joint (S)
- C --- Construction Joint (C)

ASBUILT PLANS

△ Delete Revision	△ Add Right Turn Ln. NB Dallas Pkwy	6MG	Dec. 31, 1985
NO.	REVISION	BY	DATE

TEXAS TURNPIKE AUTHORITY  
DALLAS NORTH TOLLWAY

PAVING PLAN  
TOLL PLAZA AREA

**Gibbs & Hill, Inc.**  
ENGINEERS DESIGNERS CONSTRUCTORS  
DALLAS

SECTION VII

DRAWN AELT	DATE 5/12/83	DESIGNED MGB	DATE 5/6/83
CHECKED DWG	DATE 5/17/84	SCALE 1" = 20'	

CONTRACT NO. DNT-115 SHEET R28 OF R85