


NOTES:
 1. All curb shall be Type "A".
 2. All pavement contours shown are finished top of pavement elevations.

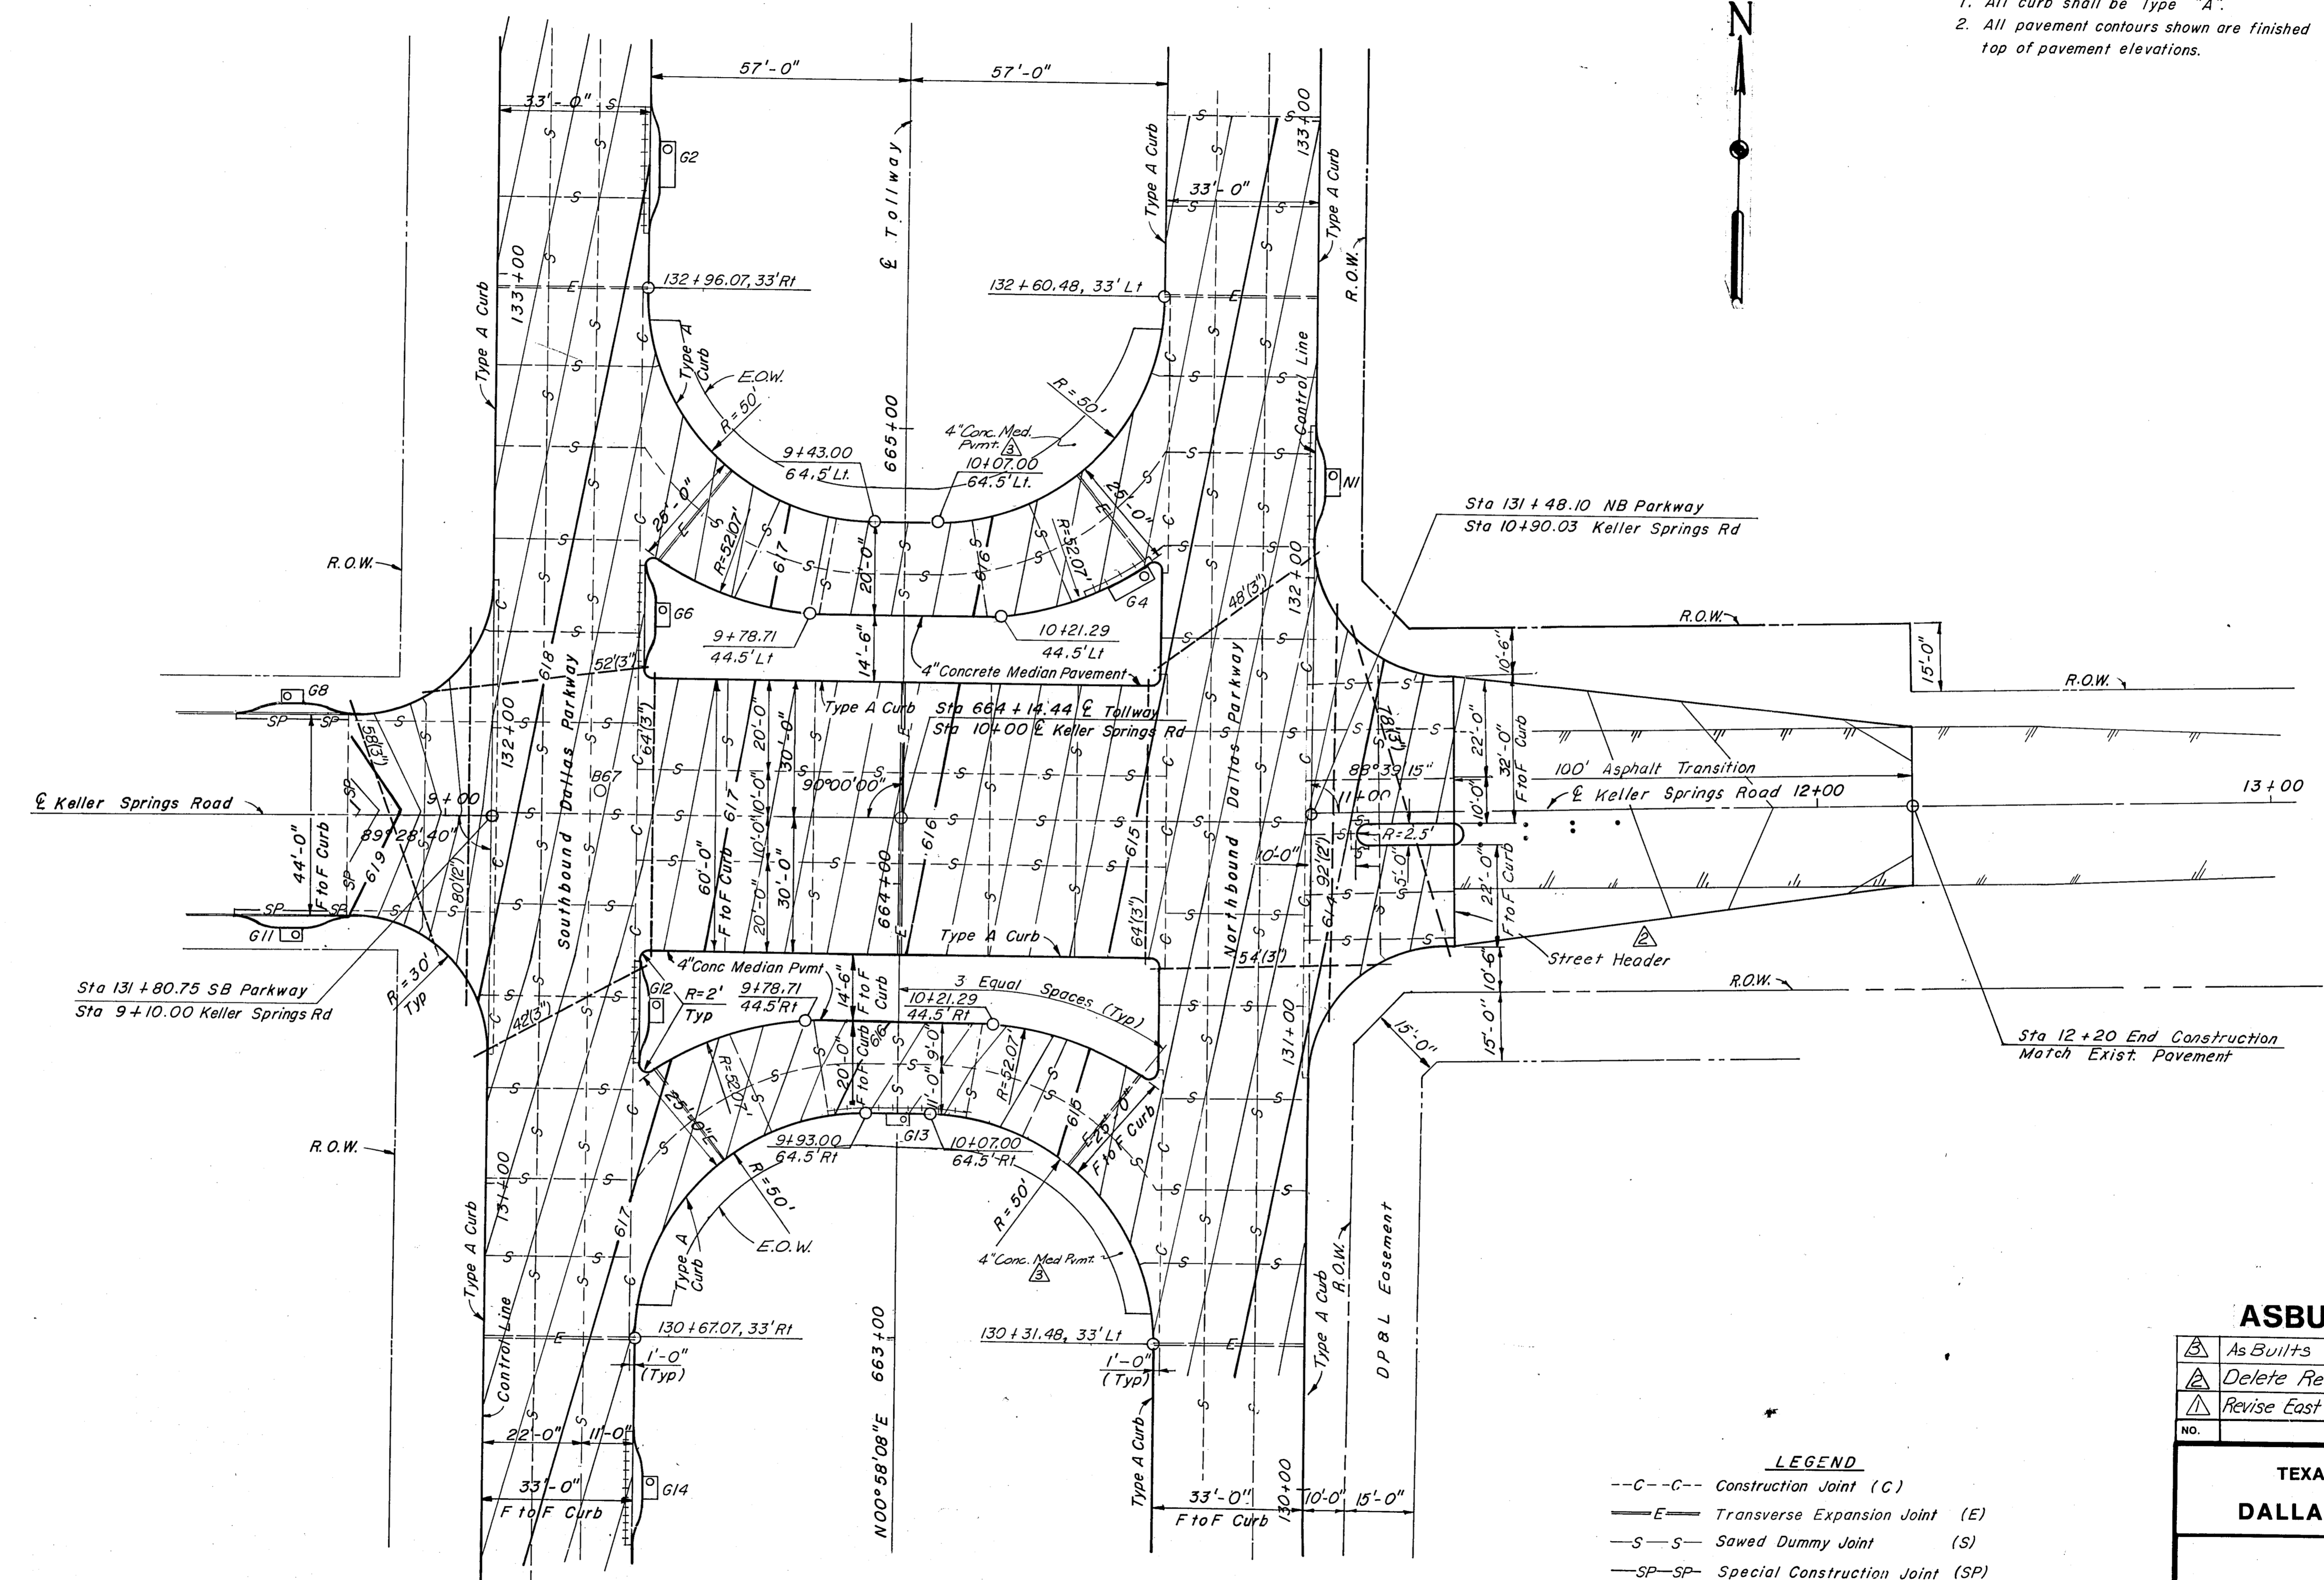

LEGEND
 -C-C- Construction Joint (C)
 -E- Transverse Expansion Joint (E)
 -S-S- Sawed Dummy Joint (S)
 -SP-SP- Special Construction Joint (SP)
 --- PVC Conduit

ASBUILT PLANS

As Built	PJ	3-8-88
Delete Revision	GMB	12-31-85
Revise East NBDP & Keller Springs	WAP	7-15-85
NO.	REVISION	BY DATE

TEXAS TURNPIKE AUTHORITY
DALLAS NORTH TOLLWAY

PAVING PLAN
 KELLER SPRINGS ROAD

Gibbs & Hill, Inc.
 ENGINEERS DESIGNERS CONSTRUCTORS
 DALLAS

SECTION VII

DRAWN	VER	DATE 4-4-83	DESIGNED	DWC	DATE 4-1-83
CHECKED	DWC	DATE 4-5-83	SCALE	1" = 20'	

CONTRACT NO. DNT-115 SHEET R 29 OF R 85