


RAMP KS-N

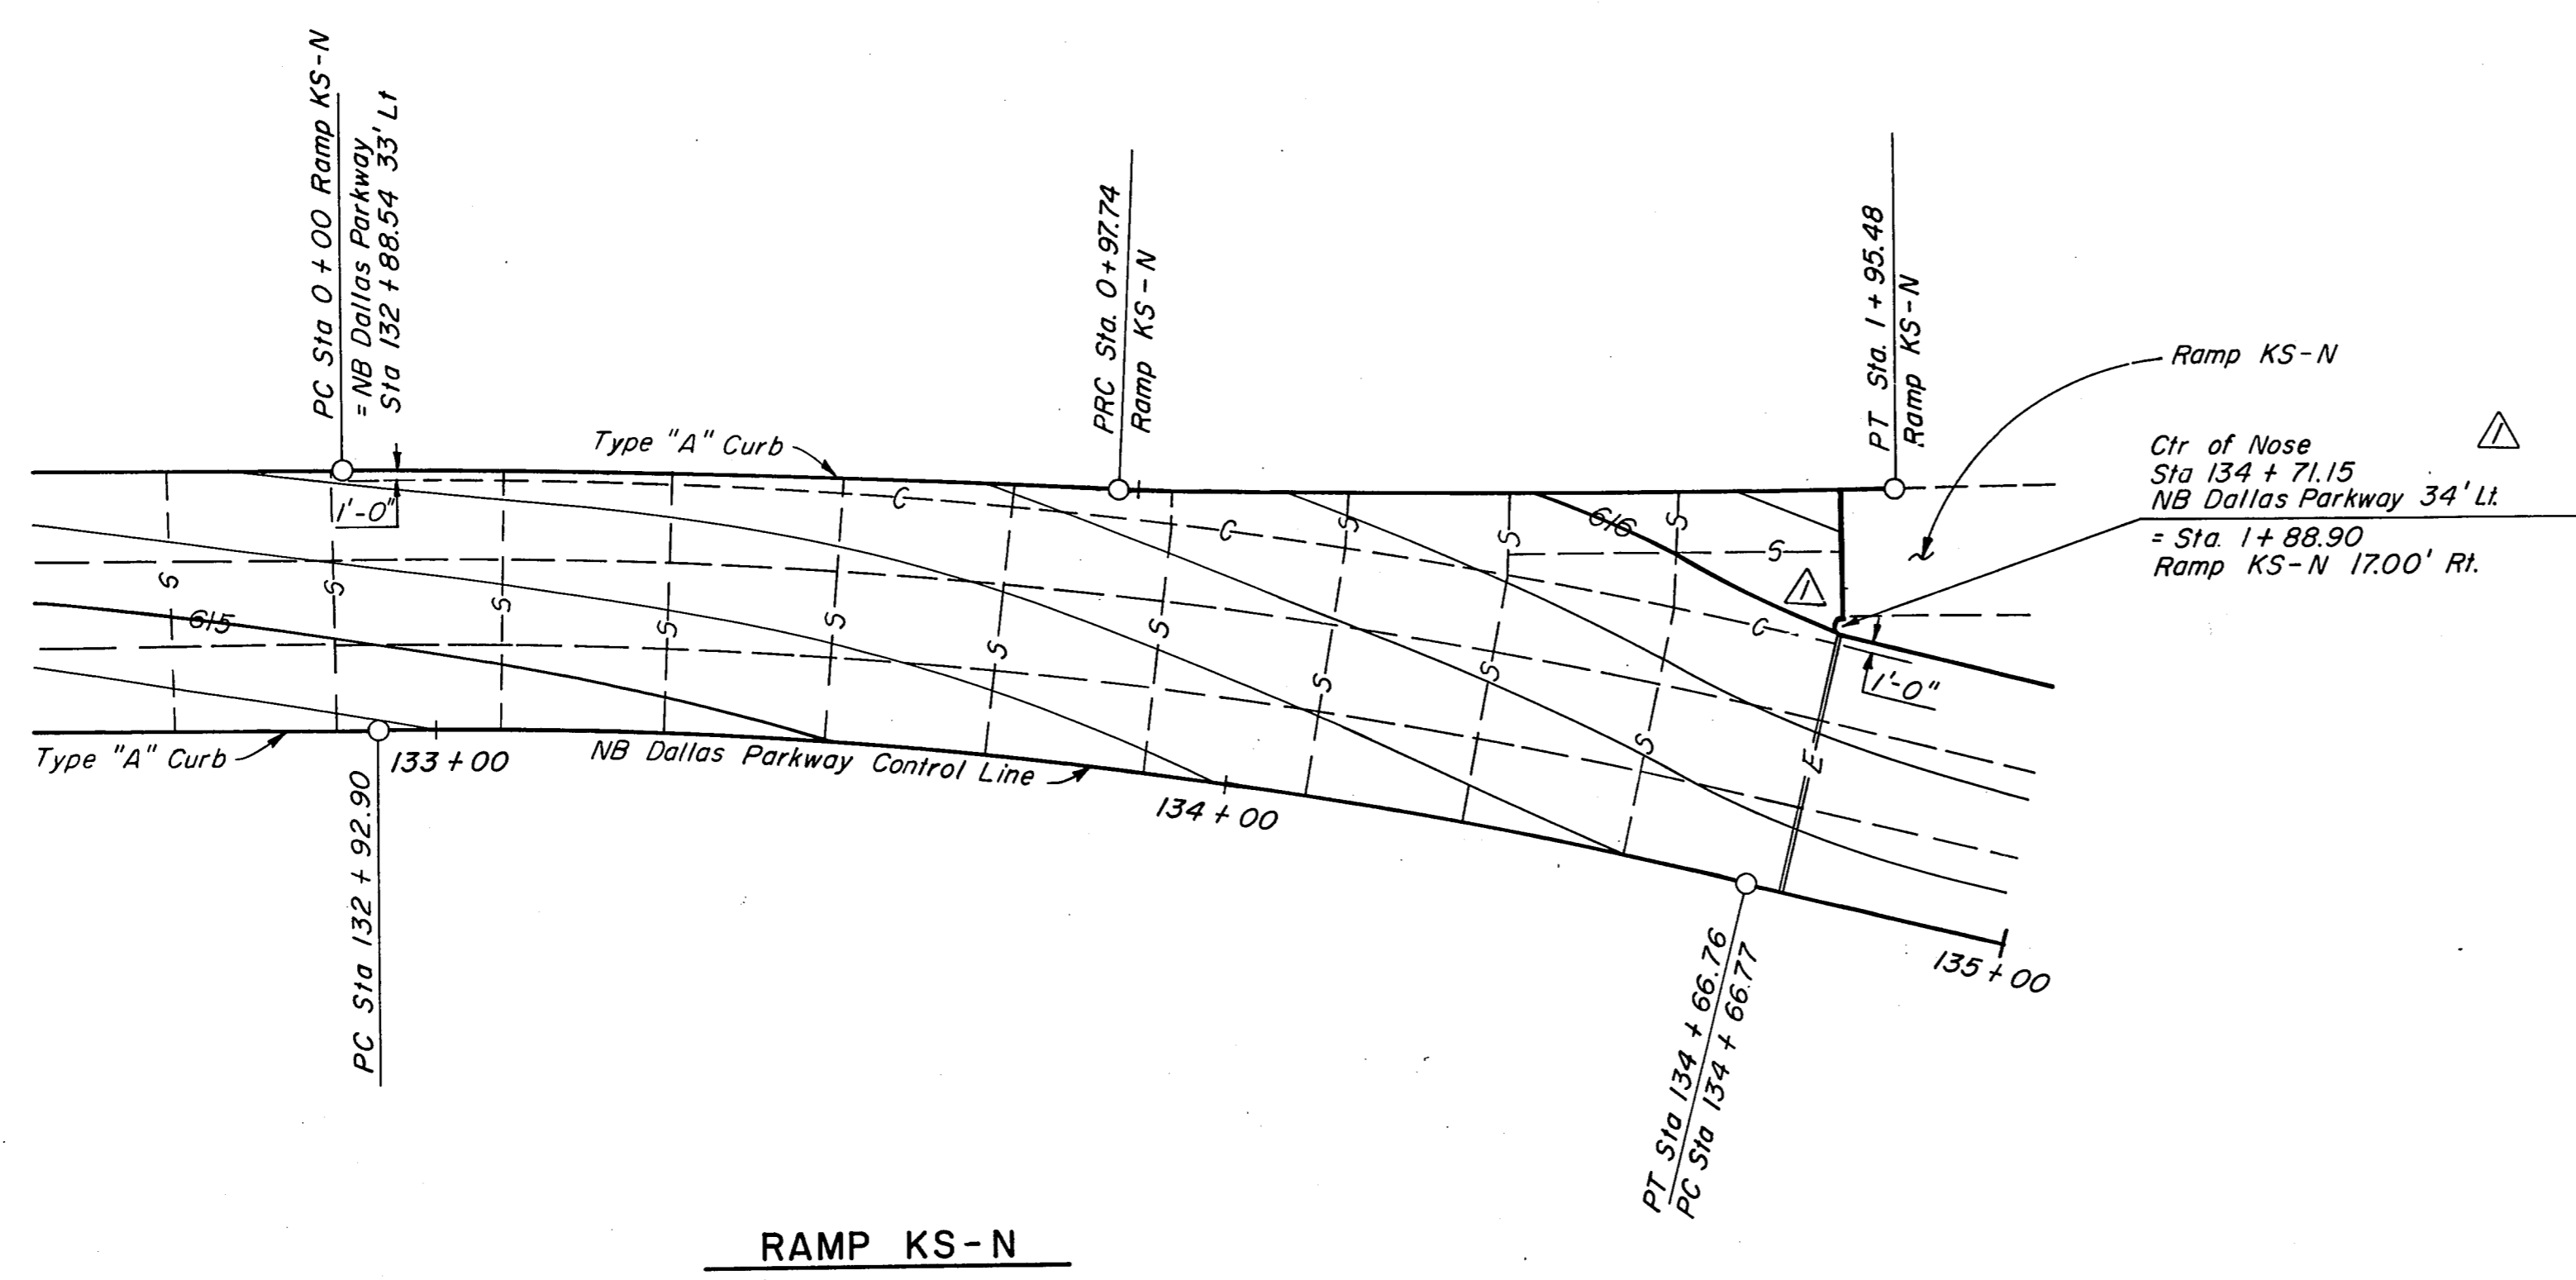

RAMP KS-N

LEGEND

+++++	Longitudinal Construction Joint (LC)
=====	Sawed Longitudinal Joint (SL)
==E==	Transverse Expansion Joint (E)
++ + ++	Transverse Contraction Joint (SC)
---S---	Sawed Dummy Joint (S)
-----L-----	Longitudinal Construction Joint w/o Tie Bar(L)
---C---	Construction Joint (C)

ASBUILT PLANS

1	Revise Ramp	GMB	7-01-86
NO.	REVISION	BY	DATE
TEXAS TURNPIKE AUTHORITY DALLAS NORTH TOLLWAY			
PAVING PLAN RAMP KS-N			
Gibbs & Hill, Inc. ENGINEERS DESIGNERS CONSTRUCTORS DALLAS			SECTION VII
DRAWN	AELT	DATE	4/18/84
CHECKED	DWC	DATE	5/4/84
DESIGNED	MGB	DATE	4/16/84
SCALE	1" = 20'		
CONTRACT NO. DNT-115 SHEET R30 OF R85			