


RAMP N - KS

LEGEND

- Longitudinal Construction Joint (LC)
- Sawed Longitudinal Joint (SL)
- == E == Transverse Expansion Joint (E)
- Transverse Contraction Joint (SC)
- S — Sawed Dummy Joint (S)
- L — Longitudinal Construction Joint w/ Tie Bar (L)
- C — Construction Joint (C)

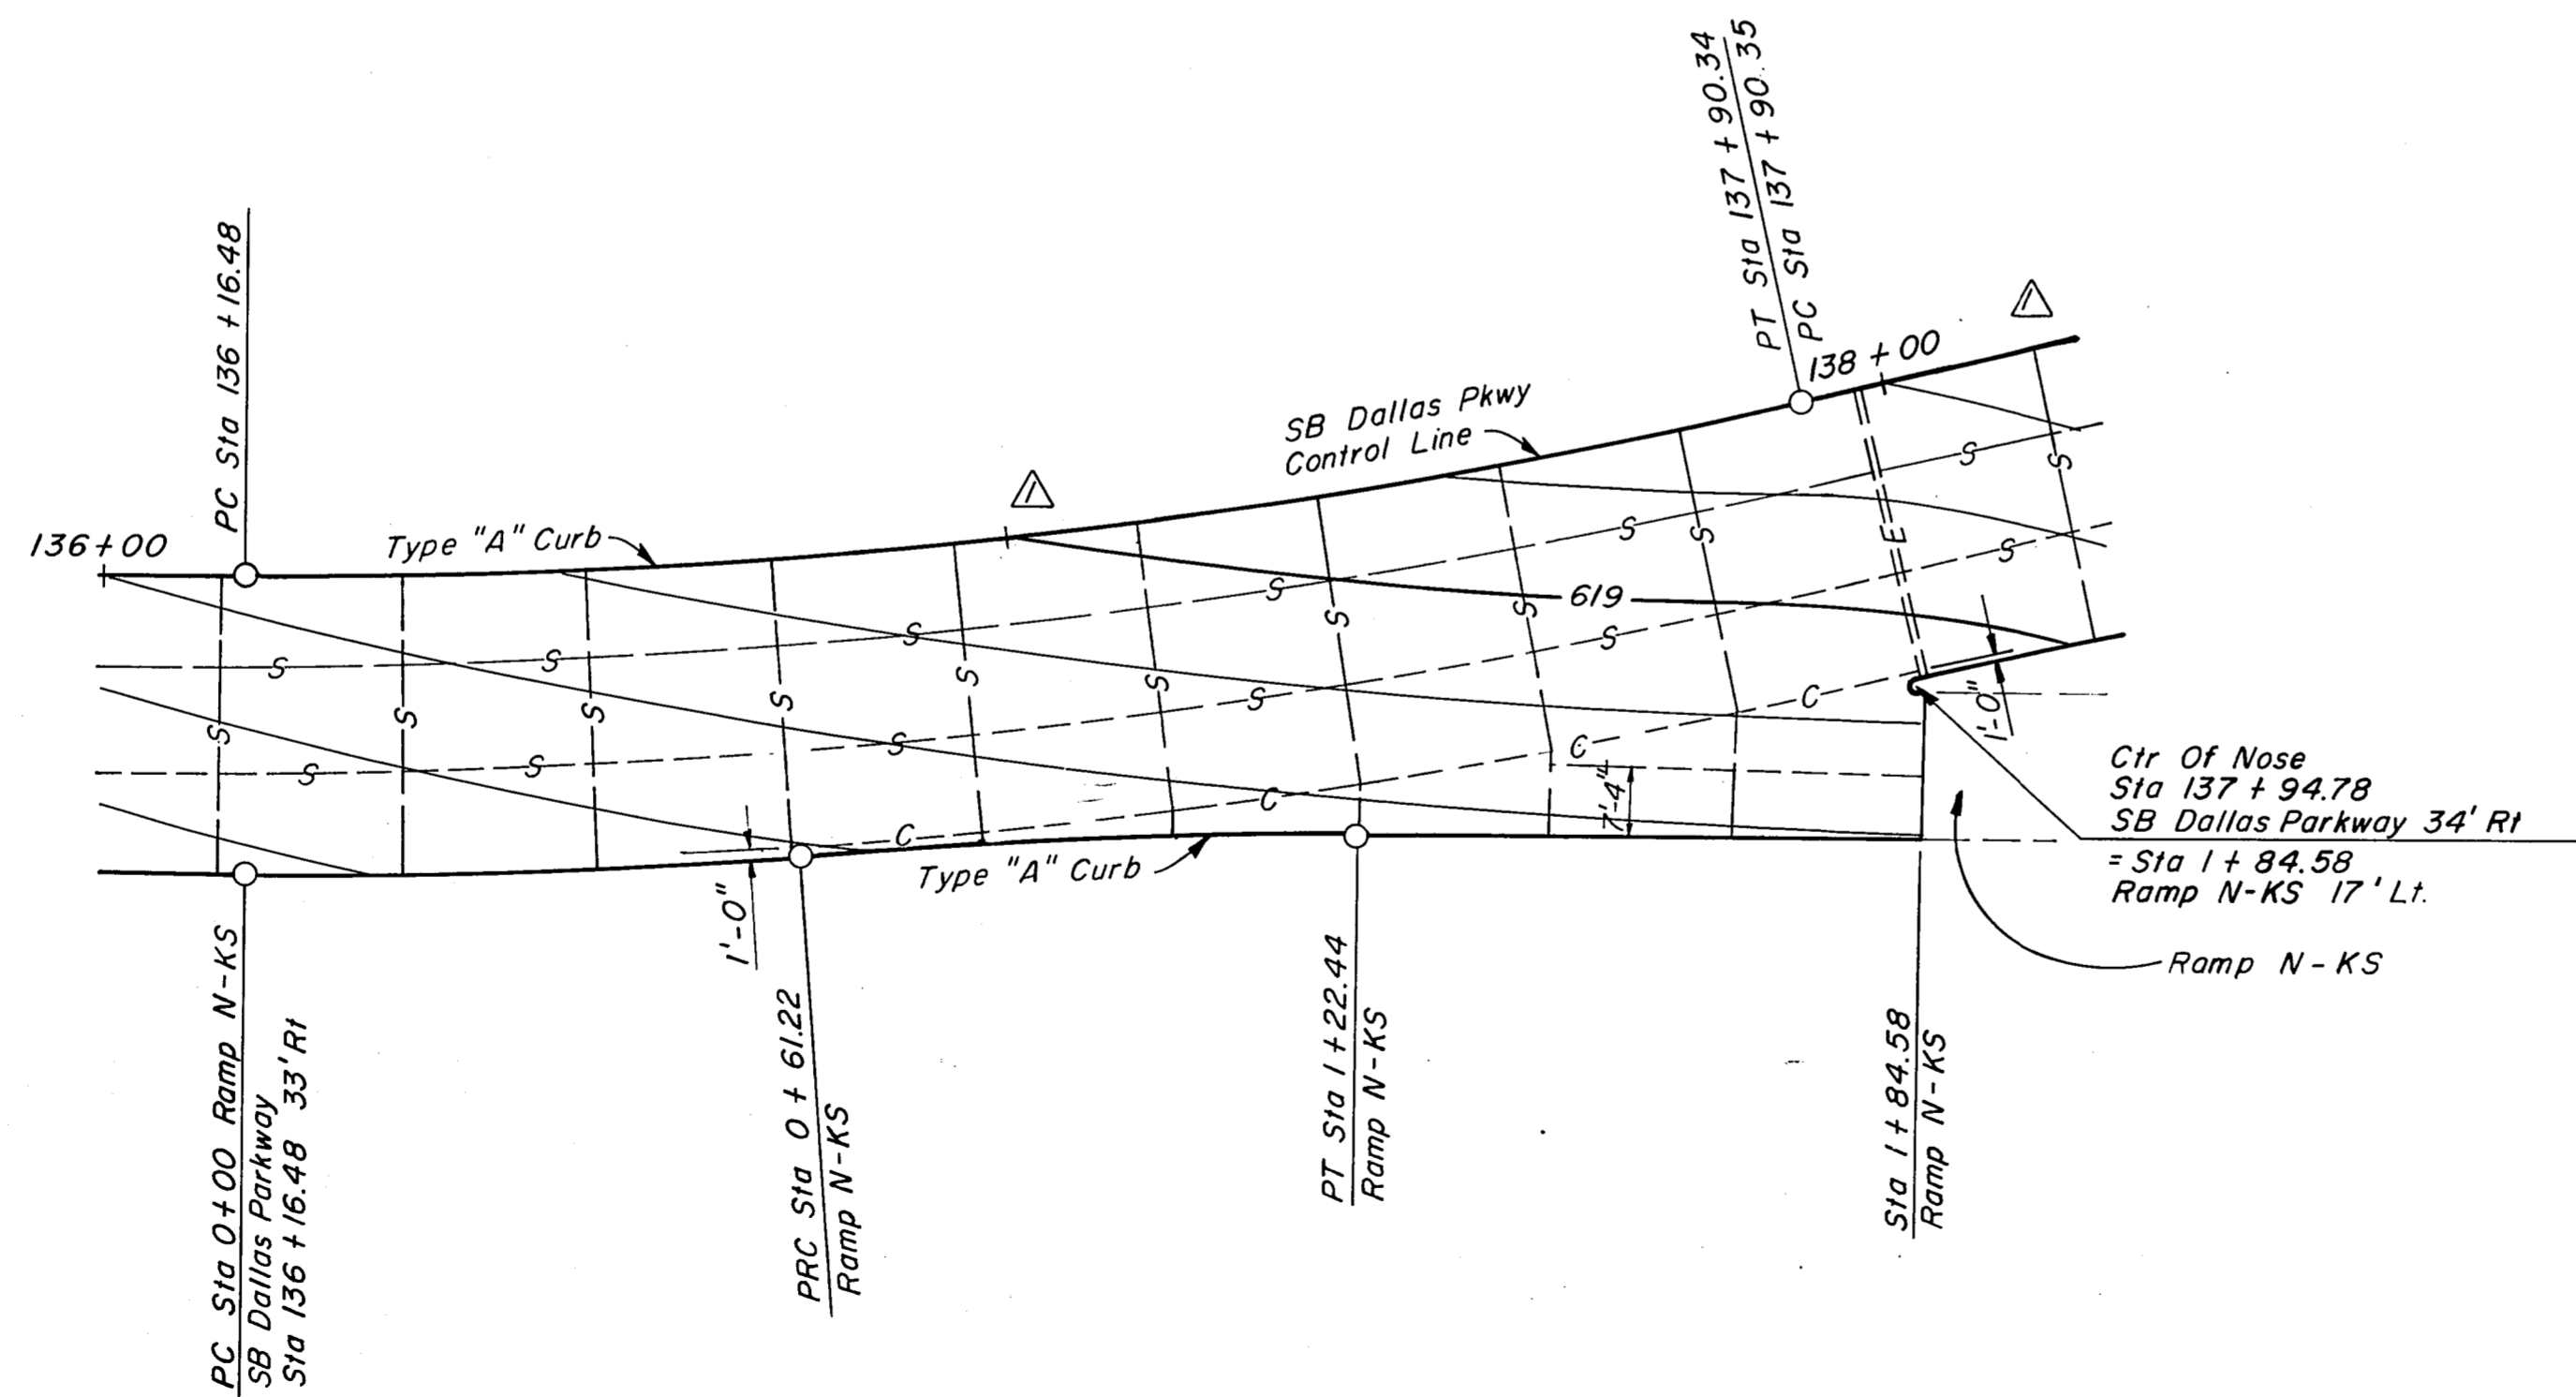

RAMP N - KS

ASBUILT PLANS

△	Revise Ramp	GMG	7-01-86
△	Inlets H1 & H2 Deleted	MGB	2-8-85
NO.	REVISION	BY	DATE

TEXAS TURNPIKE AUTHORITY
DALLAS NORTH TOLLWAY

PAVING PLAN
RAMP N - KS

Gibbs & Hill, Inc.
ENGINEERS DESIGNERS CONSTRUCTORS
DALLAS

SECTION VII

DRAWN	AELT	DATE	4/17/84	DESIGNED	MGB	DATE	4/12/84
CHECKED	DWC	DATE	5/4/84	SCALE	1" = 20'		

CONTRACT NO. DNT-115 SHEET R31 OF R85