


NOTES:
 1. All curb shall be Type "A".
 2. All pavement contours shown are finished top of pavement elevations.

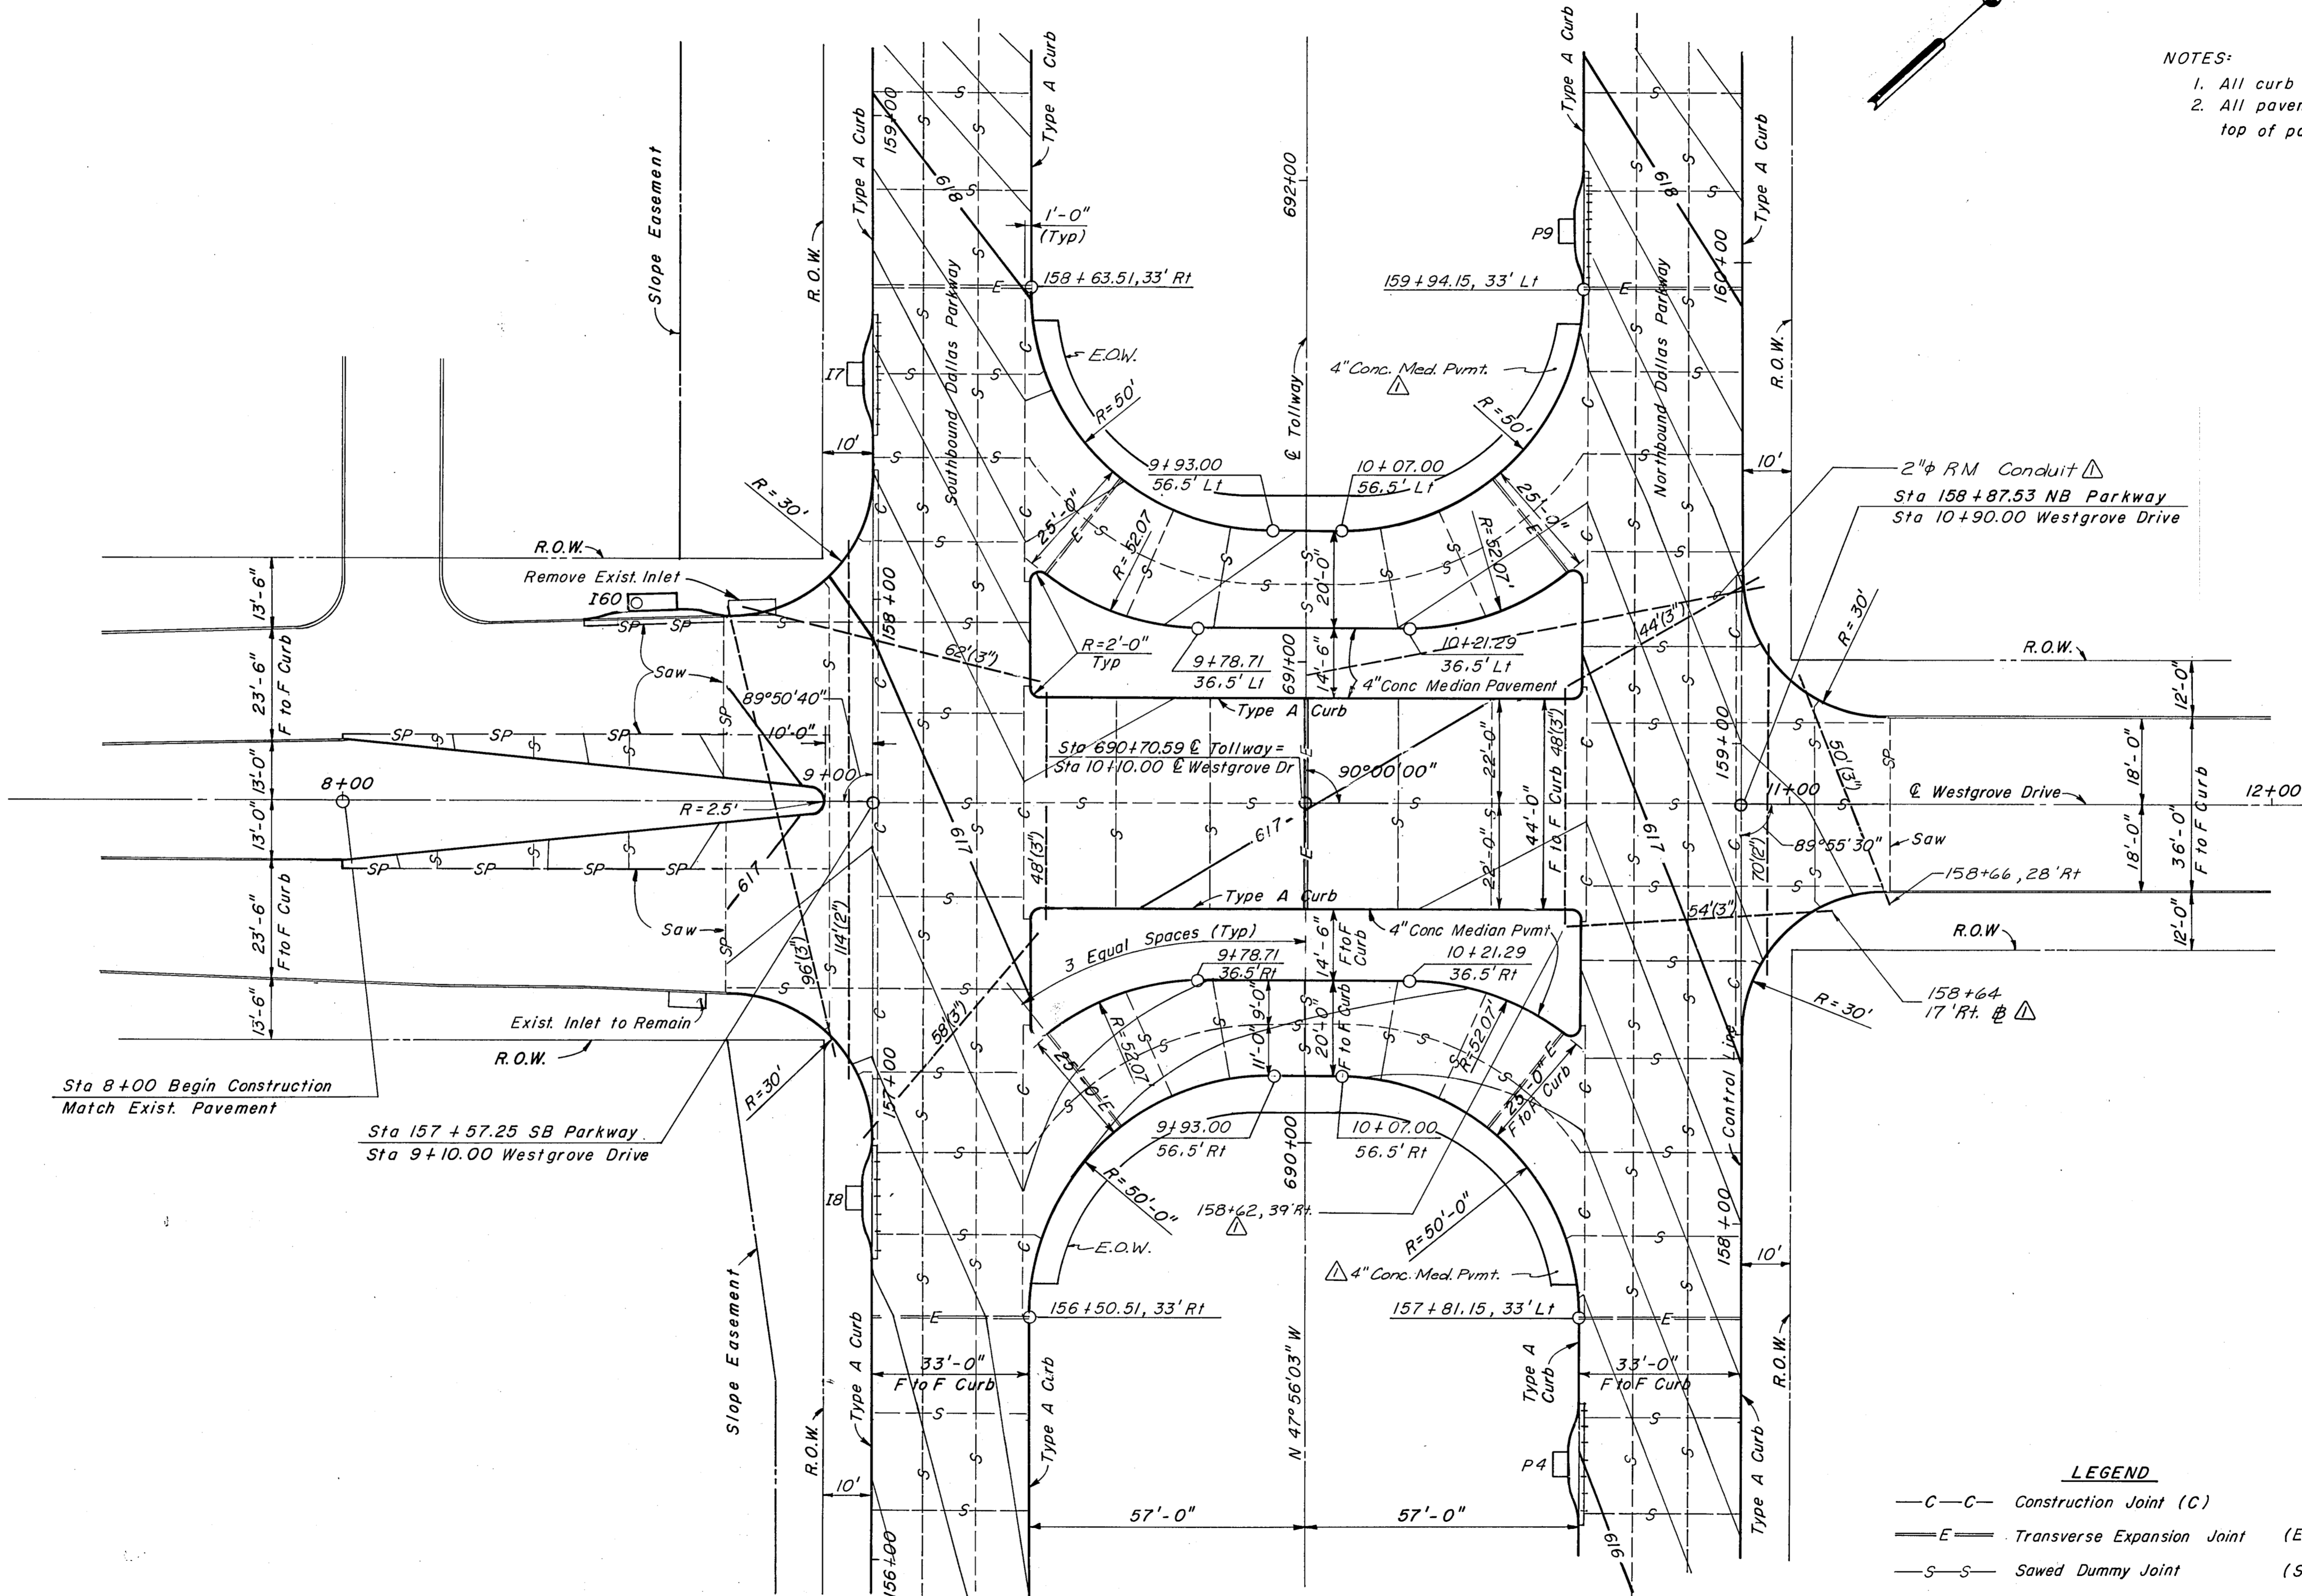

Sta 8+00 Begin Construction
 Match Exist. Pavement

Sta 157+57.25 SB Parkway
 Sta 9+10.00 Westgrove Drive

LEGEND
 —C—C— Construction Joint (C)
 —E—E— Transverse Expansion Joint (E)
 —S—S— Sawed Dummy Joint (S)
 —SP—SP— Special Construction Joint (SP)
 - - - - - PVC Conduit

ASBUILT PLANS

NO.	As Builts	REVISION	BY	DATE
				3-8-88

TEXAS TURNPIKE AUTHORITY
 DALLAS NORTH TOLLWAY
 PAVING PLAN
 WESTGROVE DRIVE

Gibbs & Hill, Inc.
 ENGINEERS DESIGNERS CONSTRUCTORS DALLAS

SECTION VII

DRAWN CJB DATE 4/4/83 DESIGNED DWC DATE 4/1/83
 CHECKED DWC DATE 4/5/83 SCALE 1" = 20'

CONTRACT NO. DNT-115 SHEET R 32 OF R 85