


635
630
625
620
640
635
630
635
630
635
630
625

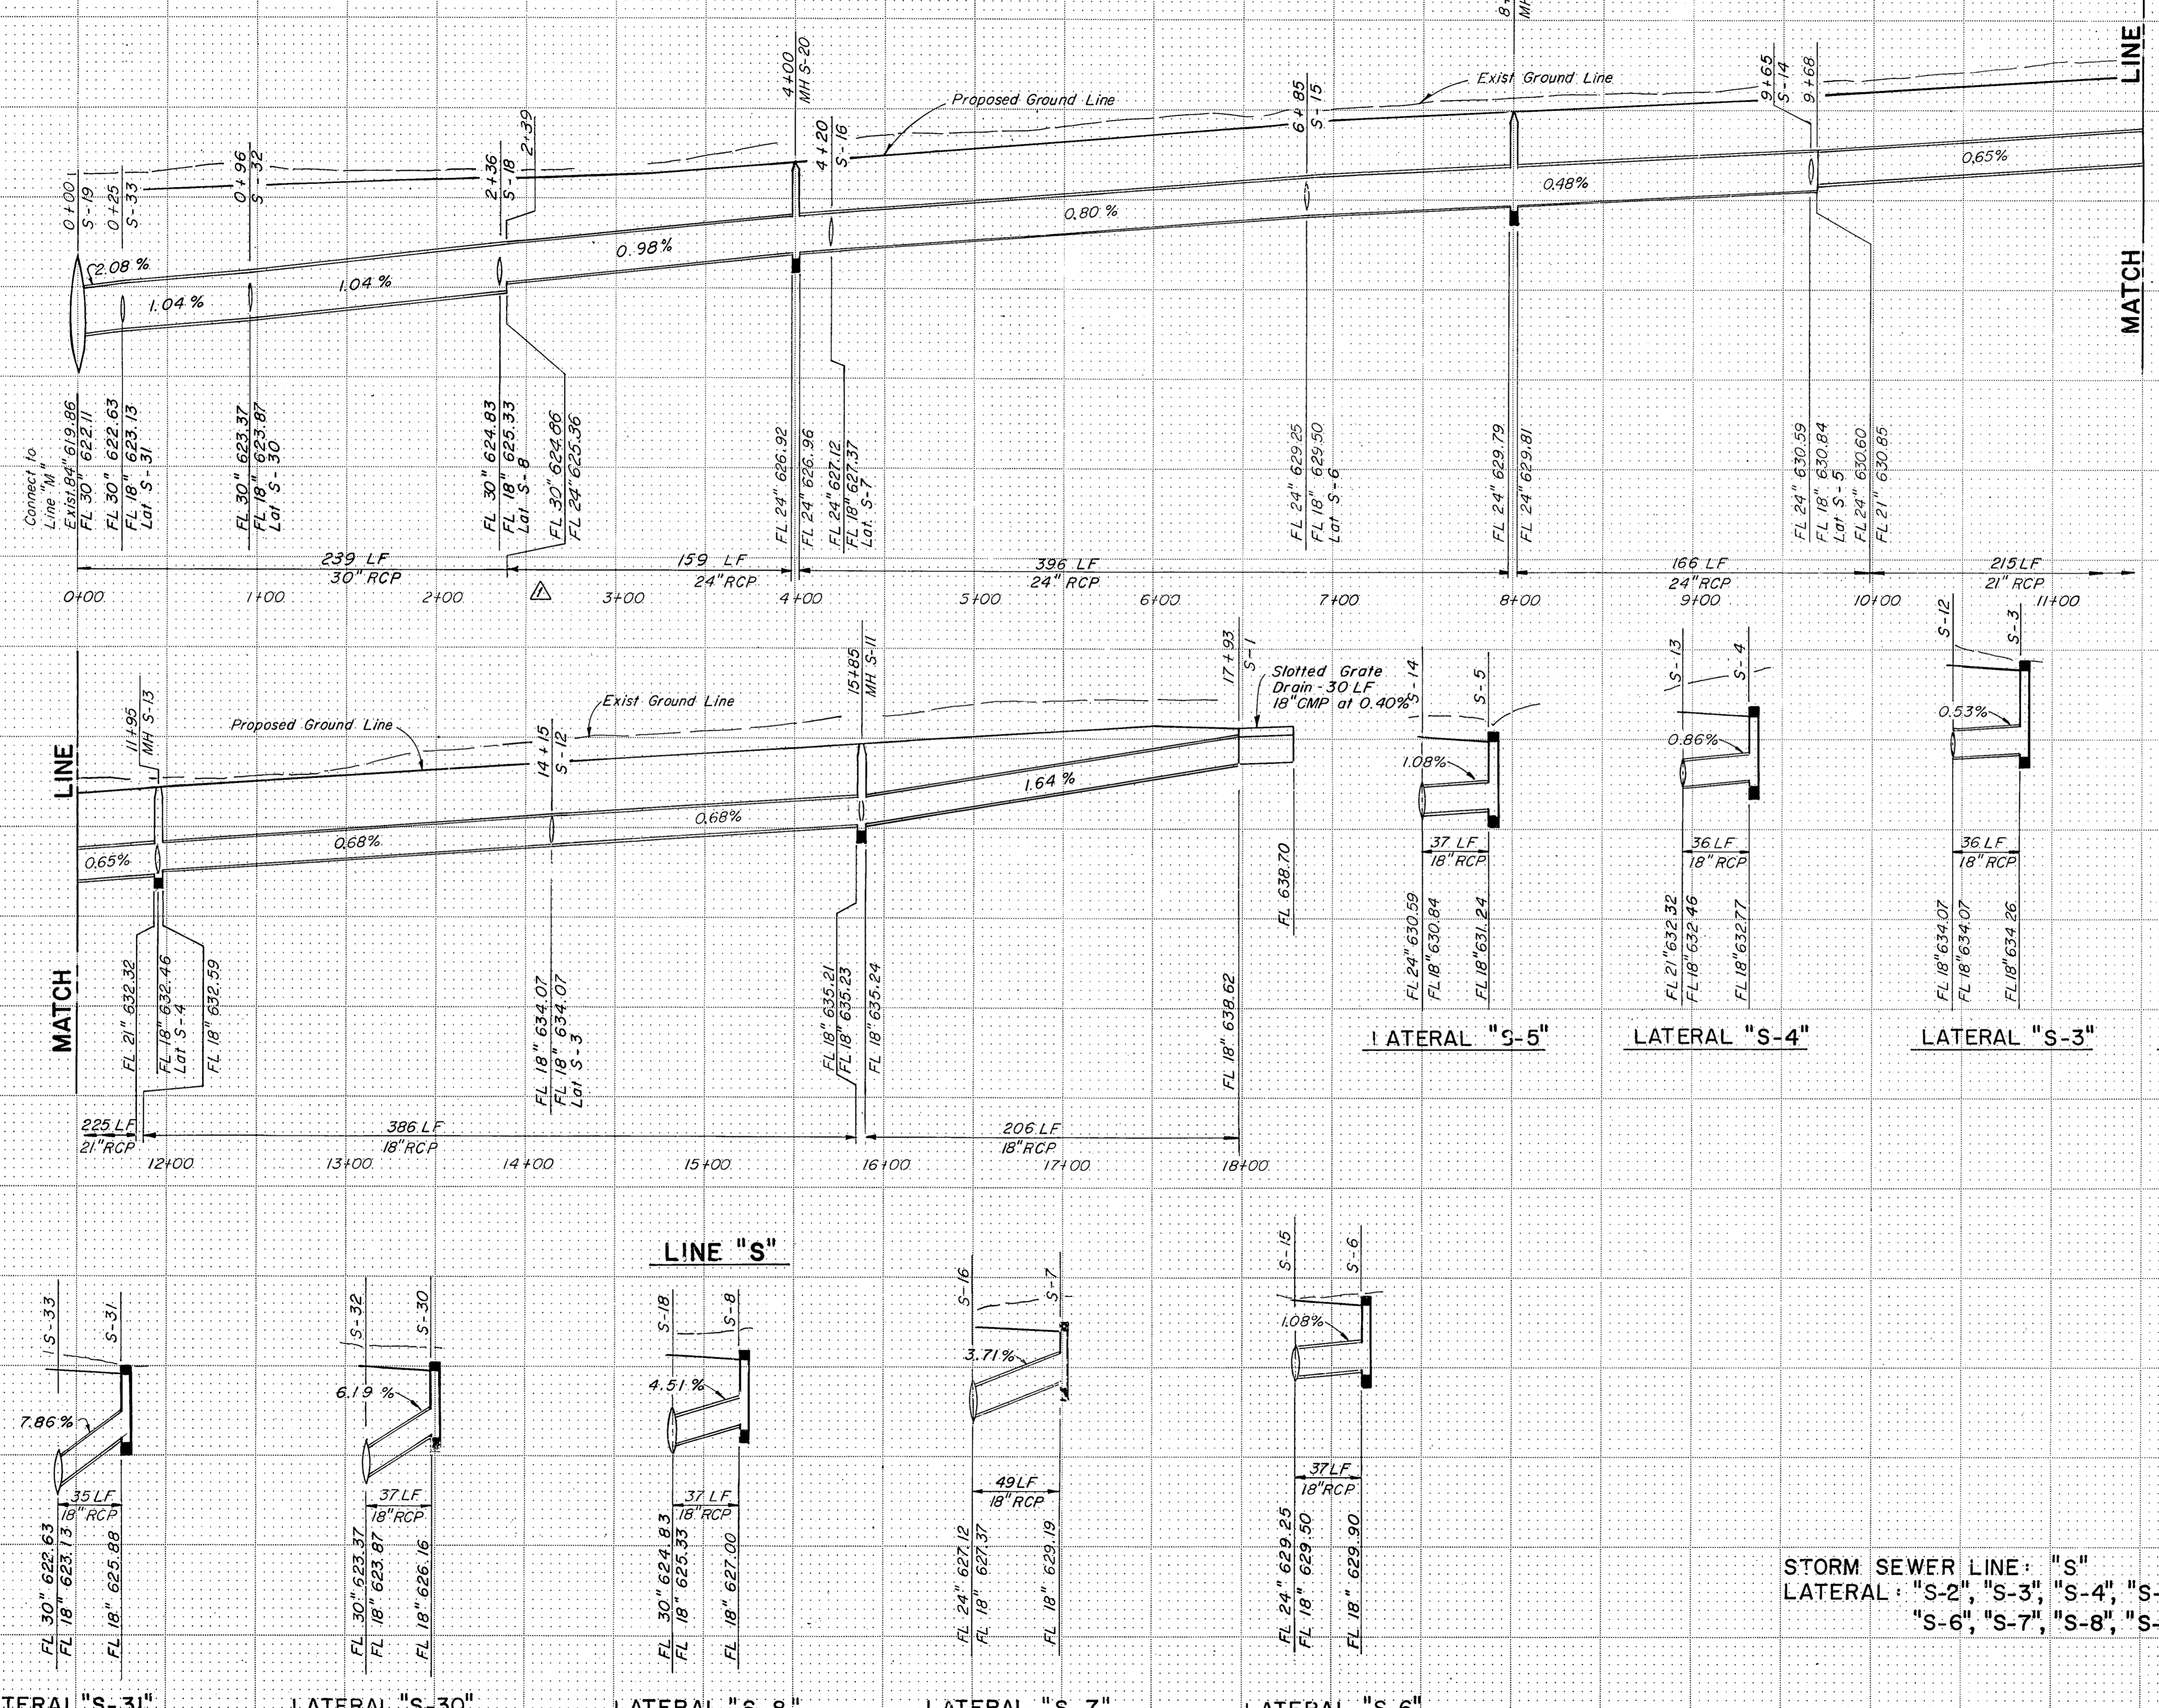

LATERAL "S-31"

LATERAL "S-30"

LATERAL "S-8"

LATERAL "S-7"

LATERAL "S-6"

LATERAL "S-5"

LATERAL "S-4"

LATERAL "S-3"

LATERAL "S-2"

STORM SEWER LINE: "S"
LATERAL: "S-2", "S-3", "S-4", "S-5",
"S-6", "S-7", "S-8", "S-30", "S-31"

ASBUILT PLANS

Gen. Trinity Mills/Briargrove - Line "S" GRB 10/05	
NO.	DATE
REVISION	BY
TEXAS TURNPIKE AUTHORITY DALLAS NORTH TOLLWAY	
STORM SEWER PROFILES	
Gibbs & Hill, Inc.	
MADE AELT DATE 12/83	TRACED GWK DATE 12/83
CHECKED REW DATE 4/84	SCALE 1"=50'H 1"=5' V
CONTRACT NO. DNT-115 SHEET R66 OF R85	