


LATERAL "B-3"

LATERAL "B-4"

NOTE: FOR CLASS OF PIPE SEE SHEET NO. 43

- LATERAL "B-3"
- LATERAL "B-4"
- LATERAL "B-4b"
- LATERAL "B-5a"
- LATERAL "B-5b"
- LATERAL "B-5c"

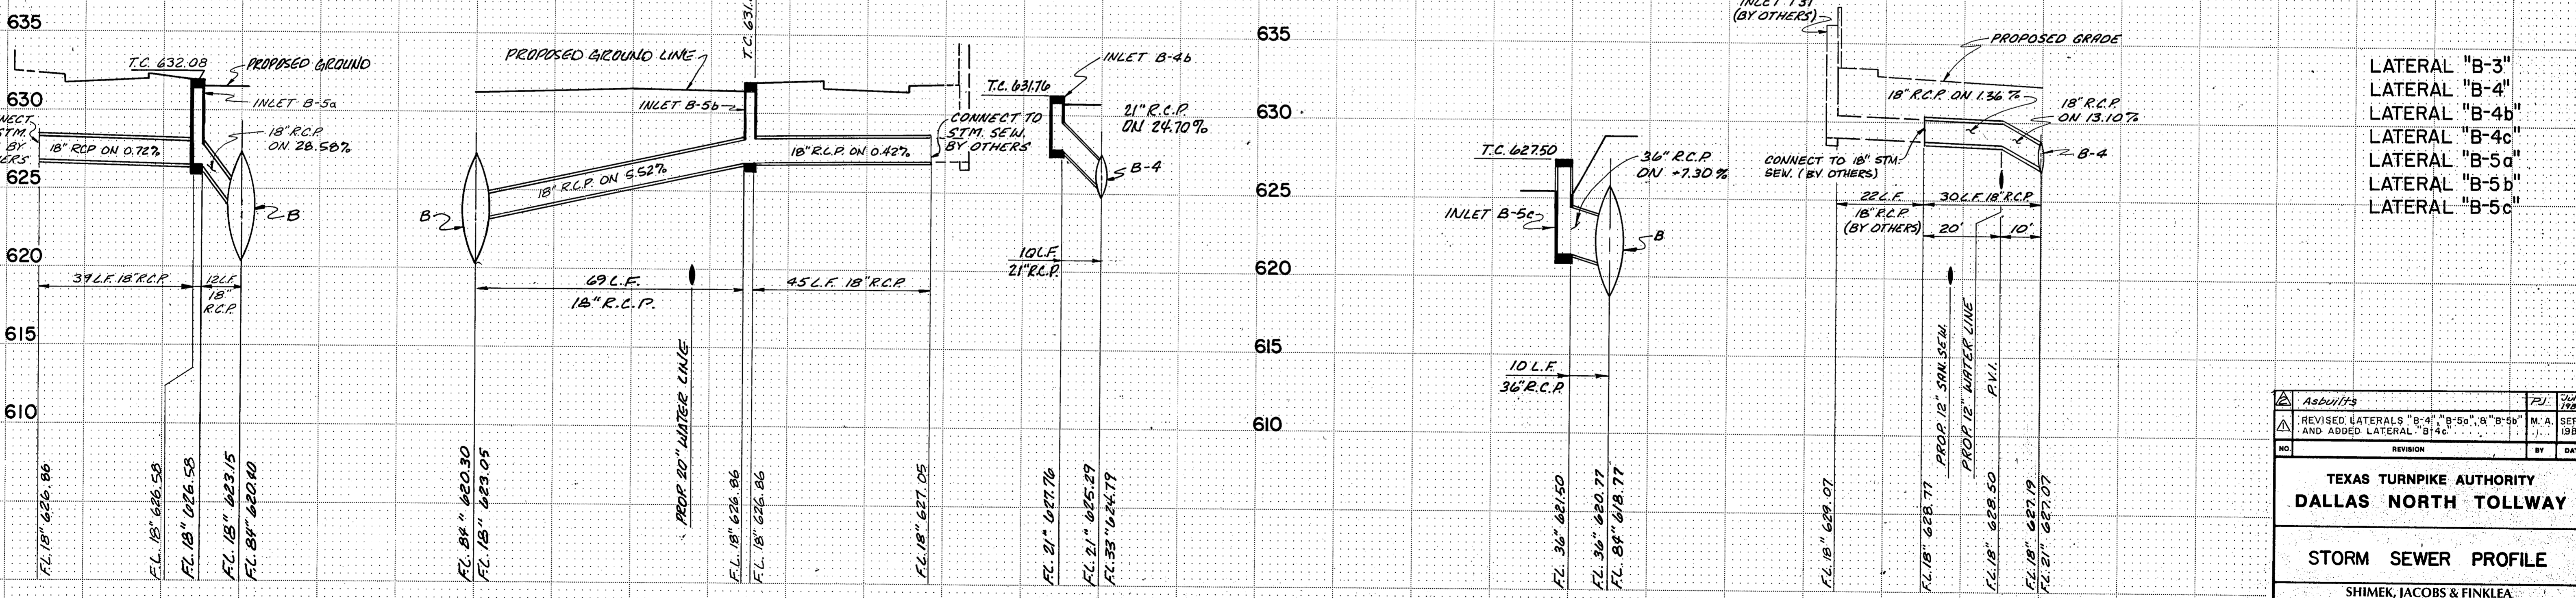

LATERAL "B-5a"

LATERAL "B-5b"

LATERAL "B-4b"

LATERAL "B-5c"

LATERAL "B-4c"

AS BUILT PLANS

Asbuilt	REVISED	DATE	BY
NO.	REVISION	DATE	BY
TEXAS TURNPIKE AUTHORITY DALLAS NORTH TOLLWAY STORM SEWER PROFILE			
SHIMEK, JACOBS & FINKLEA CONSULTING ENGINEERS DALLAS, TEXAS			
MADE	E.W.H.	DATE	5-83
CHECKED	M.A.	DATE	5-83
SCALE		1"=20' HOR. 1"=5' VERT.	
CONTRACT NO.		DNT 116 SHEET 47 OF 96	