


8" Water Line Curve Data

Curve No.	Δ	R	T	L
1.	5°32'08"	972.93	470.4	940.0
2.	4°48'32"	1457.39	61.20	122.32
3.	6°36'15"	598.96	34.56	69.04

Note: Relocation Of Standpipe @ BL Sta. 82+60 To Be Subsidiary To Other Items.

Bench Mark: Top Of Belt In N.W. Cor. Of Base Plate For Parking Lot Light Standard, 143' East Sta. 609+26.5 Elev. 630.76

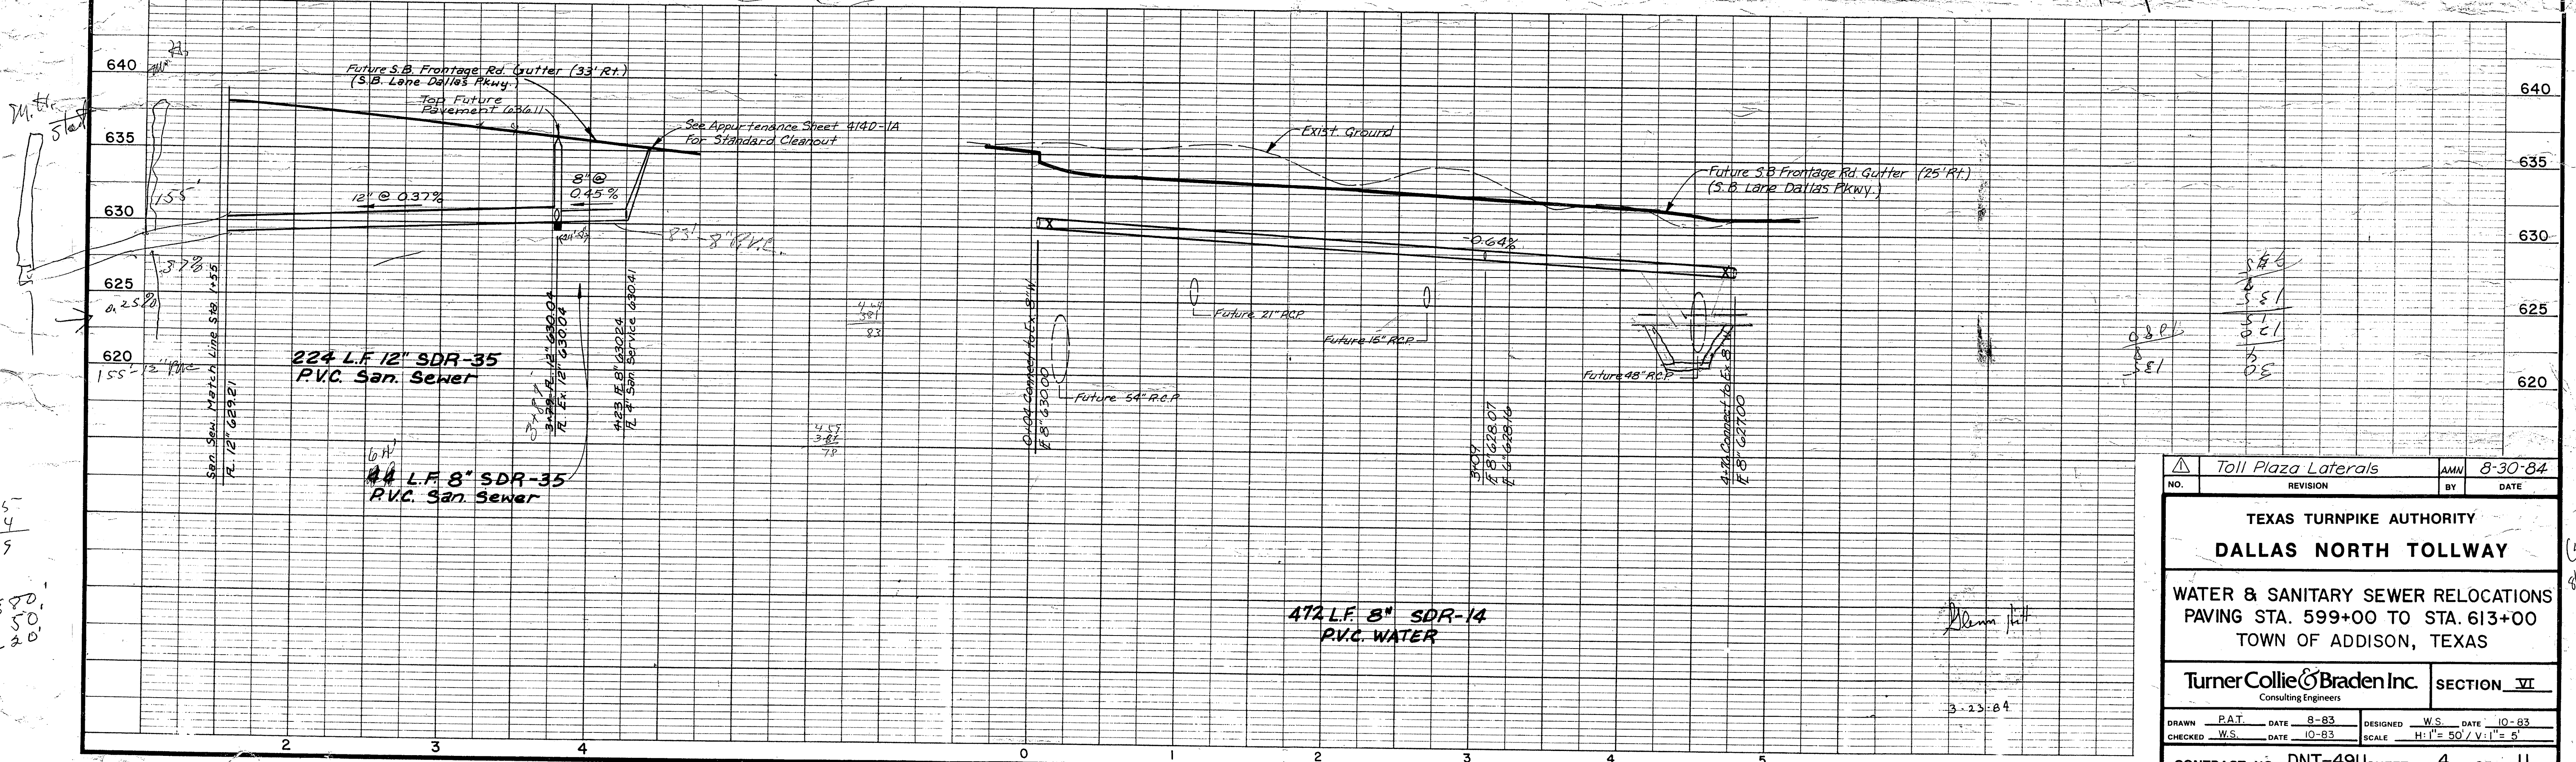

NO.	REVISION	BY	DATE
	Toll Plaza Laterals	AMN	8-30-84

TEXAS TURNPIKE AUTHORITY
DALLAS NORTH TOLLWAY

WATER & SANITARY SEWER RELOCATIONS
PAVING STA. 599+00 TO STA. 613+00
TOWN OF ADDISON, TEXAS

TurnerCollie & Braden Inc. SECTION VII
Consulting Engineers

DRAWN	PAT	DATE	8-83	DESIGNED	W.S.	DATE	10-83
CHECKED	W.S.	DATE	10-83	SCALE	H:V = 50' : 1" = 5'		

CONTRACT NO. DNT-49U SHEET 4 OF 11

155+
234
575

Copy made
8/24/89

Drum Pitt

3-23-84