


CAUTION !!

CONTRACTOR IS TO CONTACT TEXAS ONE-CALL SYSTEM (1-800-245-4545) OR OTHER UTILITY LOCATING SERVICES AT LEAST 48 HOURS PRIOR TO CONSTRUCTION ACTIVITIES. STANTEC IS NOT RESPONSIBLE FOR KNOWING ALL EXISTING UTILITIES IN THE PROJECT AREA NOR FOR DEPICTING THE EXACT LOCATIONS OF UTILITIES ON THESE DRAWINGS.

SITE LEGEND

PROPOSED FIRE LANE, ACCESS, AND UTILITY EASEMENT (REFER TO SHEET C2.3 FOR STRIPING DETAIL)

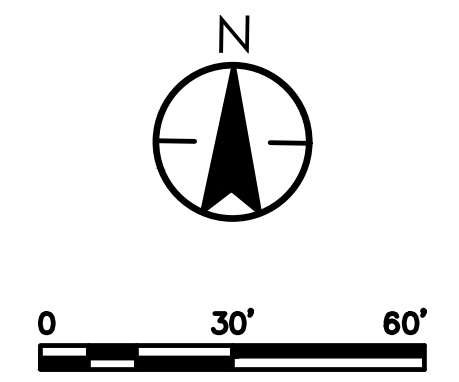

PROJECT RECORD

To the best of North Texas Contracting, Inc. belief and knowledge the as-built conditions shown on this drawing constitute an accurate and complete depiction of the manner in which this portion of the work was actually installed.

North Texas Contracting, Inc.
7/16/18
Carson Collier, Project Manager

BENCHMARKS:
REFERENCE BENCHMARK:
 TOWN OF ADDISON CONTROL POINT NO. 00A-14 LOCATED 1,730' SOUTH EAST FROM THE INTERSECTION OF LANDMARK PLACE AND LANDMARK BOULEVARD THEN 40.6' WEST OF STREET SIGN, 8.15' NORTH OF CHAINLINK FENCE AND 70.5' EAST OF STREET SIGN. ELEVATION = 623.19'

SITE BENCHMARK:
 3-1/4" ALUMINUM DISK IN STAMPED "STANTEC" FOUND LOCATED APPROXIMATELY 1000' WEST FROM THE CENTERLINE OF THE SOUTHBOUND SERVICE ROAD OF THE DALLAS NORTH TOLLWAY, APPROXIMATELY 730' SOUTH FROM THE CENTERLINE OF LANDMARK BOULEVARD. POINT ALSO BEING THE SOUTHWEST CORNER OF SUBJECT TRACT. ELEVATION = 616.60'

CITY OF DALLAS FILE NO: 311T-9310

Stantec

12222 Meiri Drive, Suite 400
Dallas TX 75244
www.stantec.com
TBE # 14324
TBEIS # 1019429

DATE	BY	REVISION
18.03.19	JAM	18.03.19
17.08.01	JAM	17.08.01
17.07.27	JAM	17.07.27
17.06.29	JDS	17.06.29
17.04.28	JAM	17.04.28
17.04.28	JDS	17.04.28
	By	Appd.
	YYMMDD	YYMMDD

ISSUED

Client/Project
CAWLEY PARTNERS

Cawley - Fourteen555
14555 DALLAS PARKWAY
TOWN OF ADDISON, DALLAS COUNTY, TEXAS

Permit-Seal

Project Number: 222210632
File Name: 10632dim.dwg

JOB	JAM	JAM	18.03.19
Dwn.	Chkd.	Dsgn.	YYMMDD

Drawing No. **C2.2**

Revision Sheet

C2.2

V:\2222\cawley\222210632\caw\caw\sheet\10632dim.dwg
 2018/03/16 10:51:14 AM by J. Carson Collier

ORIGINAL SHEET - AN3 D