



DISCLAIMER: The use of this standard is governed by the "Texas Engineering Practice Act". No warranty of any kind is made by TxDOT for any purpose whatsoever. TxDOT assumes no responsibility for the conversion of this standard to other formats or for incorrect results or damages resulting from its use.


DATE: FILE:

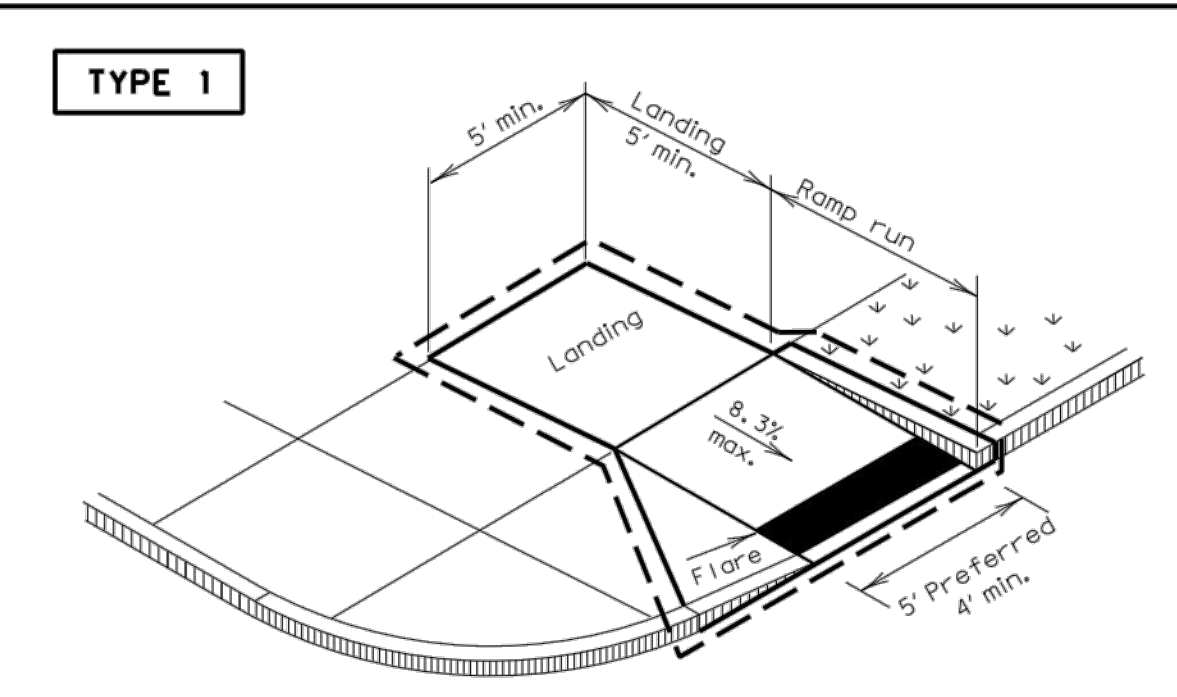


PERPENDICULAR CURB RAMP

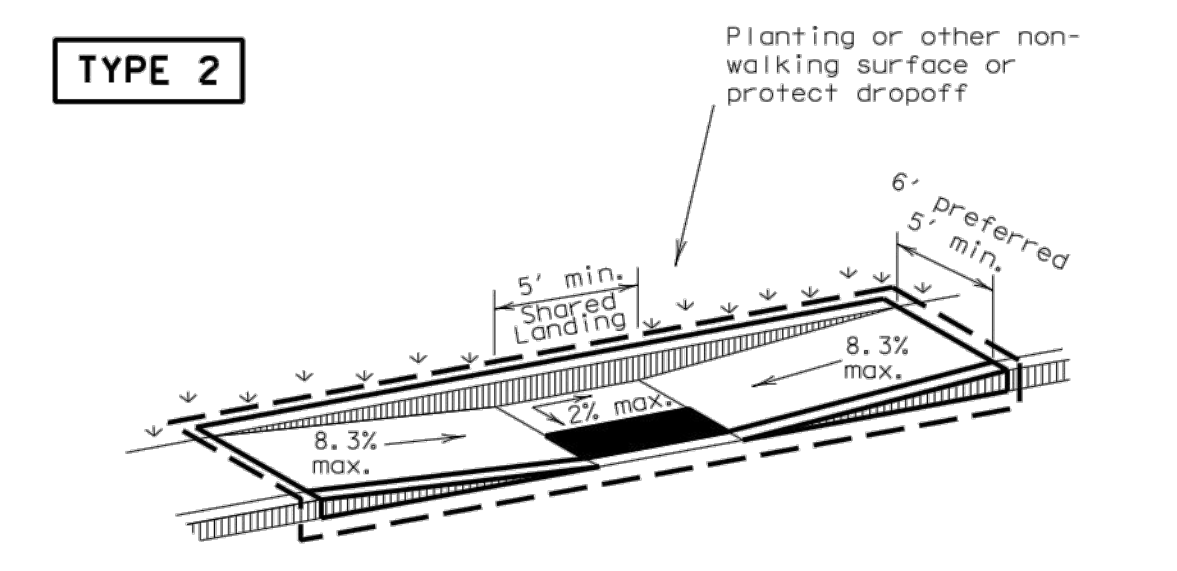

PARALLEL CURB RAMP
(Use only where water will not pond in the landing.)

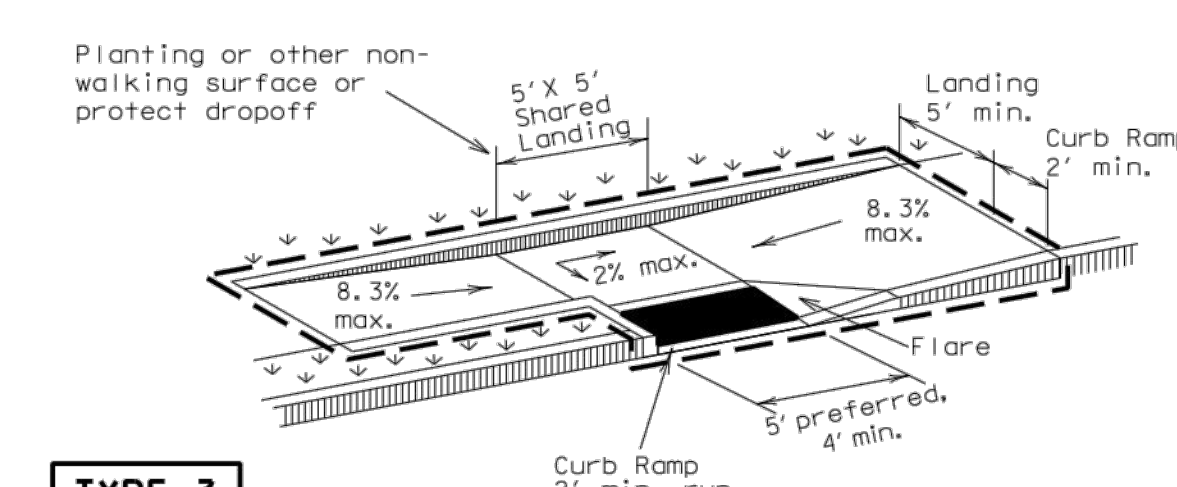


TYPE 3

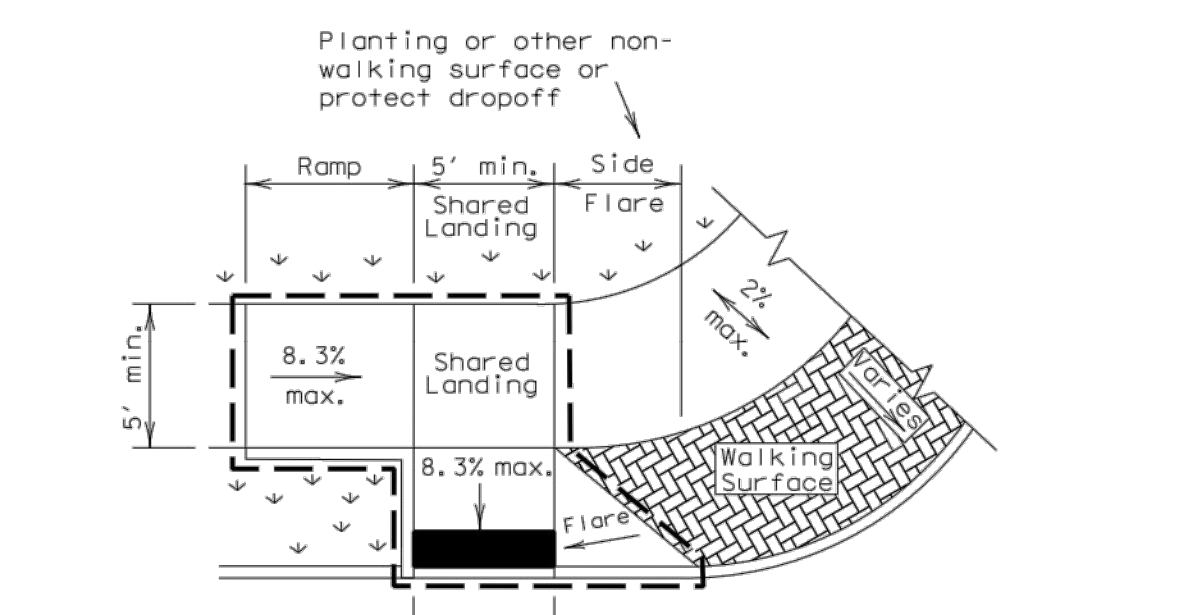


TYPE 6

COMBINATION CURB RAMPS

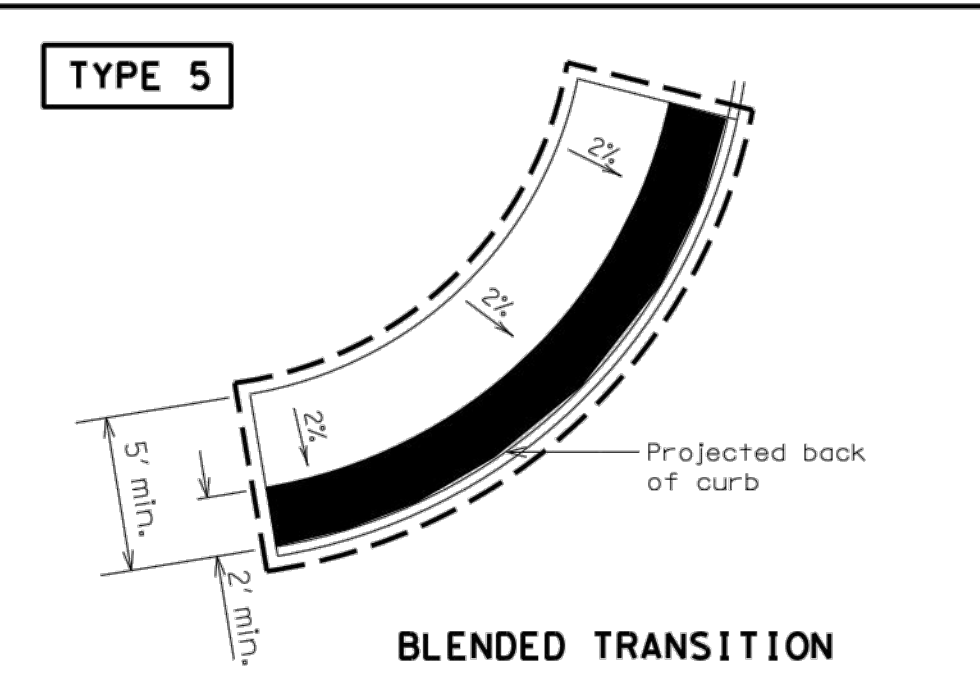


BLENDED TRANSITION

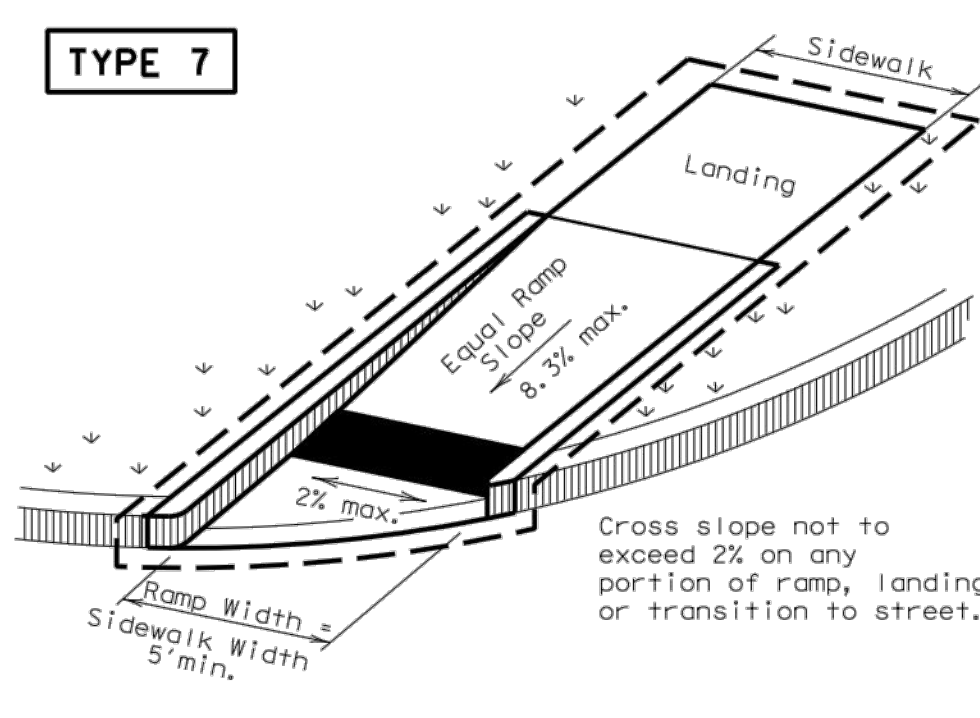

TYPE 7


(Sidewalk set back from curb)

DIRECTIONAL RAMPS WITHIN RADIUS

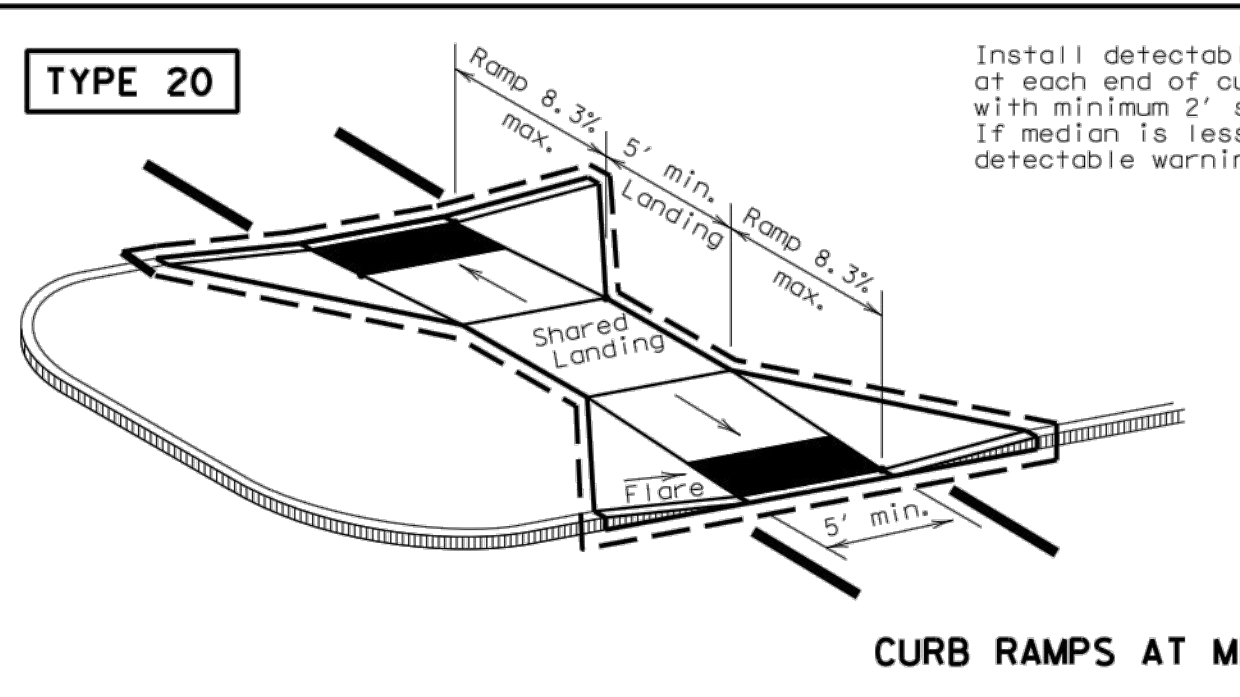


CURB RAMPS AT MEDIAN ISLANDS

Install detectable warning surface at each end of cut-through ramp with minimum 2' smooth surface between. If median is less than 6' wide, eliminate detectable warning surfaces.

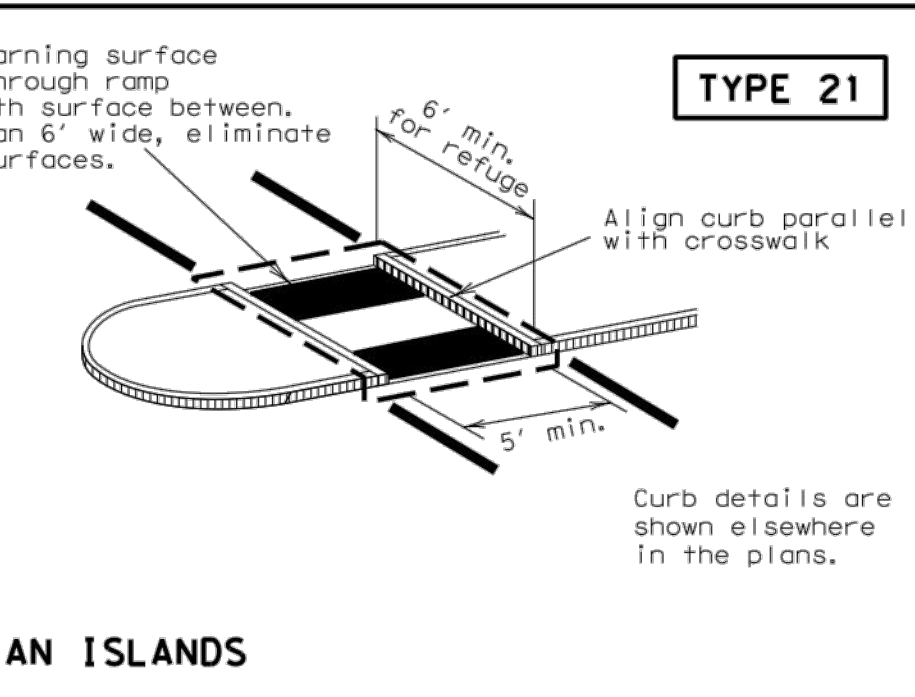


TYPE 21

Curb details are shown elsewhere in the plans.

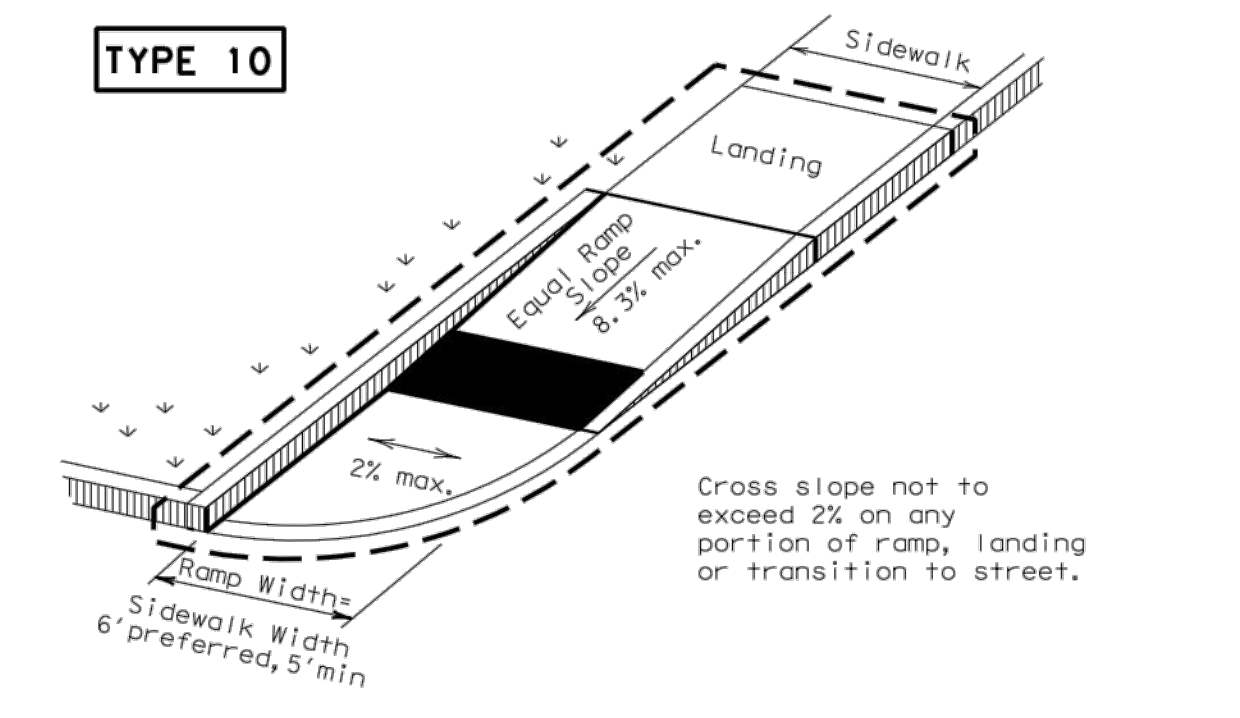


TYPE 10

(Sidewalk adjacent to curb)

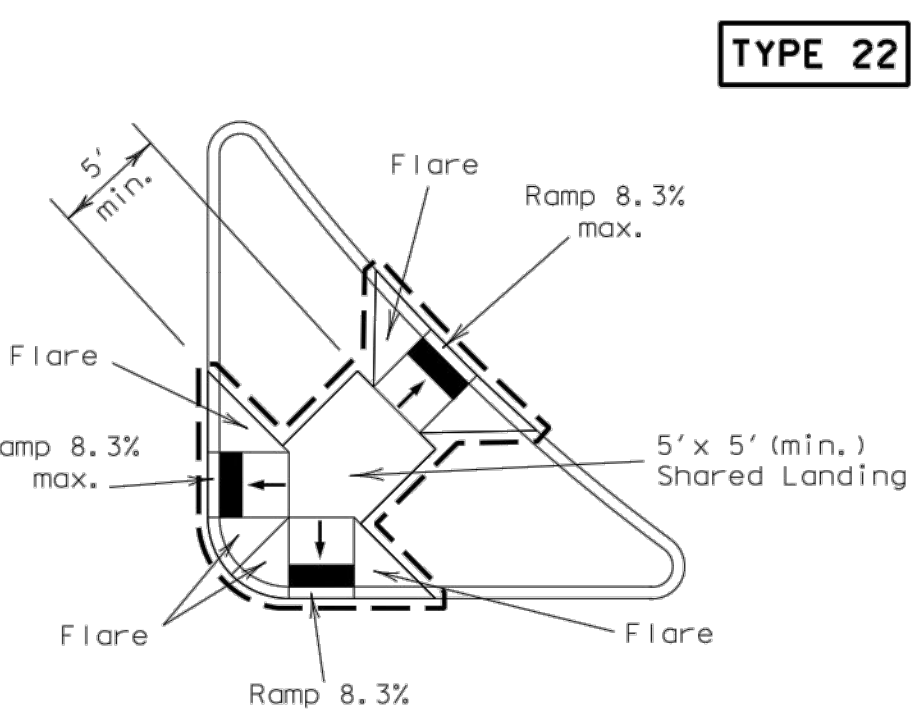

TYPE 22

COMBINATION ISLAND RAMPS

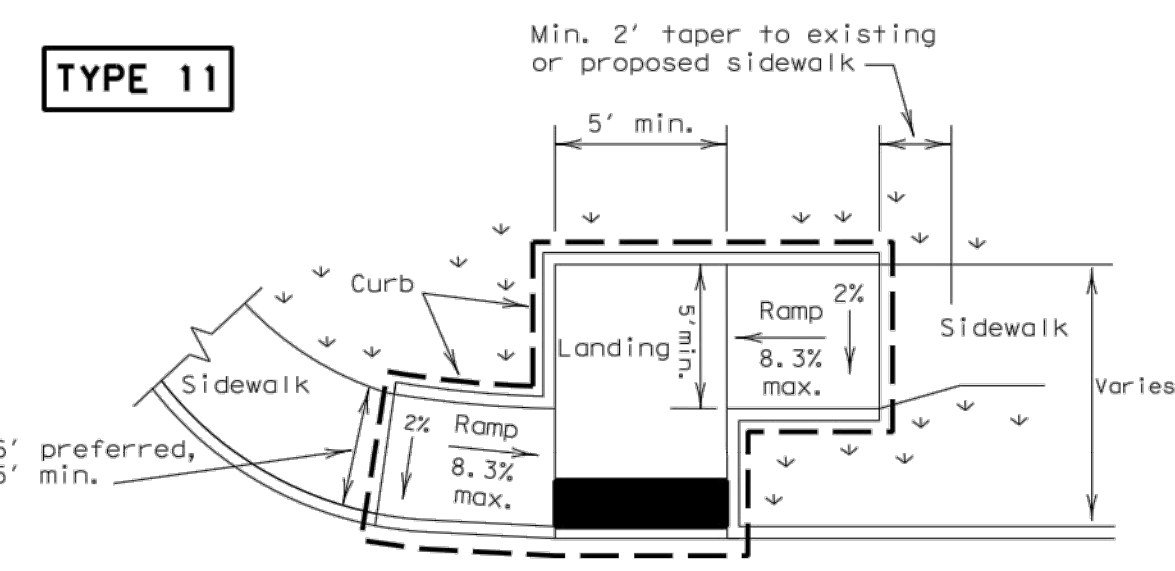

TYPE 11

OFFSET PARALLEL CURB RAMP

NOTES / LEGEND:

See General Notes on sheet 2 of 4 for more information.

Denotes planting or non-walking surface not part of pedestrian circulation path.

--- Ramp Limits of Payment
 ■ Detectable Warning Surface

SHEET 1 OF 4

PEDESTRIAN FACILITIES CURB RAMPS

PED-12A

| | | | | |
|--------------------|-----------|--------|-----------|---------|
| FILE: ped12a.dgn | DW: TxDOT | CR: RM | DW: TxDOT | CR: VP |
| © TxDOT March 2002 | CONT | SECT | JOB | HIGHWAY |
| REVISONS | | | | |
| VP June 13, 2012 | DIST | COUNTY | SHEET NO. | |

Texas Department of Transportation
 Design Division Standard

| | | |
|-------------|--------|----------|
| DESIGNED BY | JAM | 18.03.18 |
| CHECKED BY | JAM | 17.08.01 |
| APPROVED BY | JAM | 17.07.27 |
| DATE | JAM | 17.06.29 |
| BY | JAM | 17.06.28 |
| APP'D | YYMMDD | |
| BY | YYMMDD | |


PROJECT RECORD

To the best of North Texas Contracting, Inc. belief and knowledge the as-built conditions shown on this drawing constitute an accurate and complete depiction of the manner in which this portion of the work was actually installed.

North Texas Contracting, Inc.
 7/16/18
 Carson Collier, Project Manager

Client/Project
CRAWLEY PARTNERS
 Crowley - Fourteen55
 14555 DALLAS PARKWAY
 TOWN OF ADDISON, DALLAS COUNTY, TEXAS

Title
 PED12A (1)

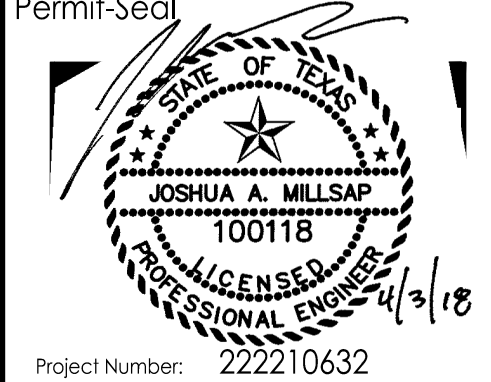

Project Number: 222210632
 File Name: 10632pvp.dwg

| | | | |
|------------------|-------|-------|----------|
| JDB | JAM | JAM | 18.03.19 |
| Dwn. | Chkd. | Dsgn. | YYMMDD |
| Drawing No. C6.4 | | | |
| Revision Sheet | | | |

CITY OF DALLAS FILE NO: 3117-9310