


23
303
15J
for Rd
M.F. - 5
Back driving Home
Sign on right side of Building
Public
1.5.R.




- GENERAL NOTES**
1. Fire Hydrants shall be Mueller "Centurion Hydrants", N.S.T. Threads, and 4" Steamer connection.
 2. Gate Valves shall be Mueller Brand.
 3. 24 hours prior to construction a pre-construction meeting must be held for proper co-ordination with officials from the Town of Addison.

EX. 24" R.C.P. TO BE REMOVED UPON CONSTR. OF TOLLWAY

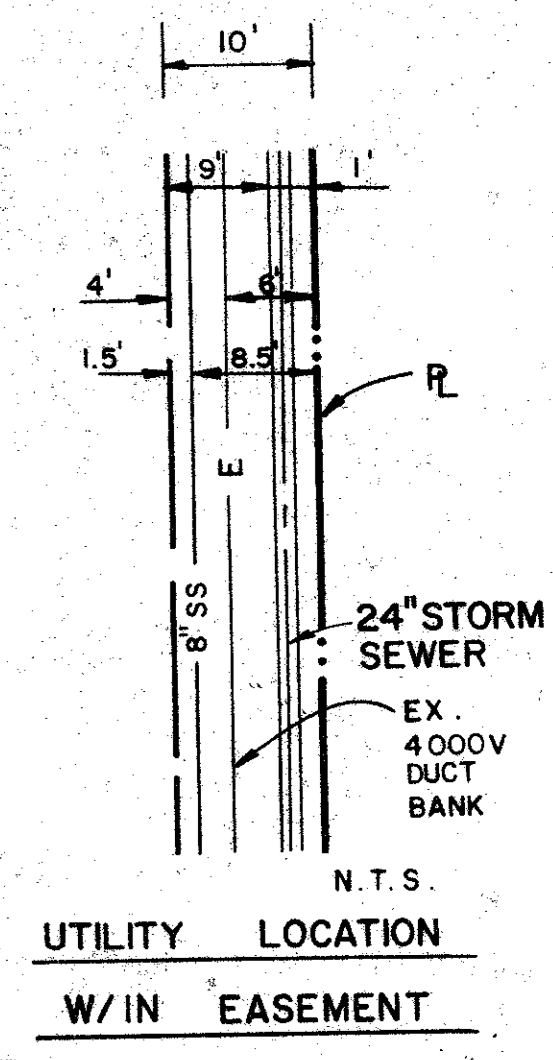

SCALE: 1" = 20'

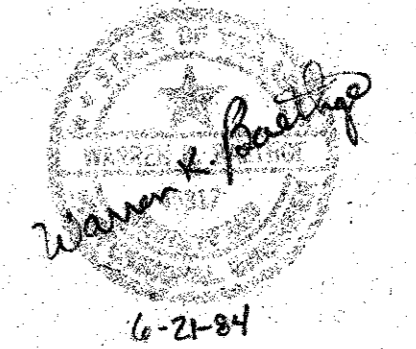

REVISED 7-16-84

UTILITY PLAN
THE ABERDEEN
HURD DEVELOPMENT
TOWN OF ADDISON
DALLAS COUNTY, TEXAS

Graham Associates, Inc.
CONSULTING ENGINEERS & PLANNERS

Drawn By: G.A.I.D. Sheet 3 of 8 Date: 6-3-84 File: 9160-100B

REVISED