


CITY OF ADDISON  
**APPROVED**  
 FOR CONSTRUCTION  
 BUILDING DEPARTMENT  
 DATE: 10-31-84  
 NOTE: CONTRACTOR IS HEREBY INSTRUCTED TO EXERCISE CARE IN MEETING OR EXCEEDING ALL REQUIREMENTS OF BOTH NATIONAL AND LOCAL CODES AND/OR ORDINANCES APPLICABLE TO HIS WORK. APPROVAL OF THESE DRAWINGS SHALL NOT BE CONSTRUED TO RELIEVE RESPONSIBILITY OR IMPLY VARIANCE IN SUCH CODES.

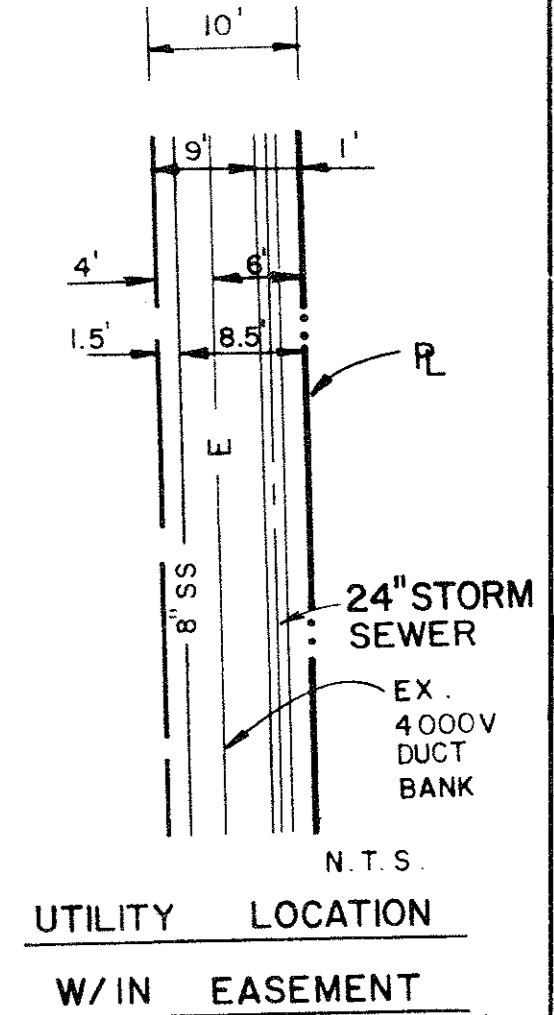

- GENERAL NOTES
1. Fire Hydrants shall be Mueller "Centurion Hydrants", N.S.T. Threads, and 4 1/2" Steamer connection.
  2. Gate Valves shall be Mueller Brand.
  3. 24 hours prior to construction a pre-construction meeting must be held for proper co-ordination with officials from the Town of Addison.

**UTILITY PLAN**  
**THE ABERDEEN**  
 HURD DEVELOPMENT  
 TOWN OF ADDISON  
 DALLAS COUNTY, TEXAS

Revised 10-30-84  
 Revised 9-27-84  
 Revised 7-16-84

**Graham Associates, Inc.**  
 CONSULTING ENGINEERS & PLANNERS

Scale: 1" = 20'

Sheet 3 of 8