




project: THE COLONNADE
 Phase One
 M.E.P.C./Mechanical, Electrical, Plumbing
 PAVING PLAN

job no: 11
 revisions

C4
 12/14/83

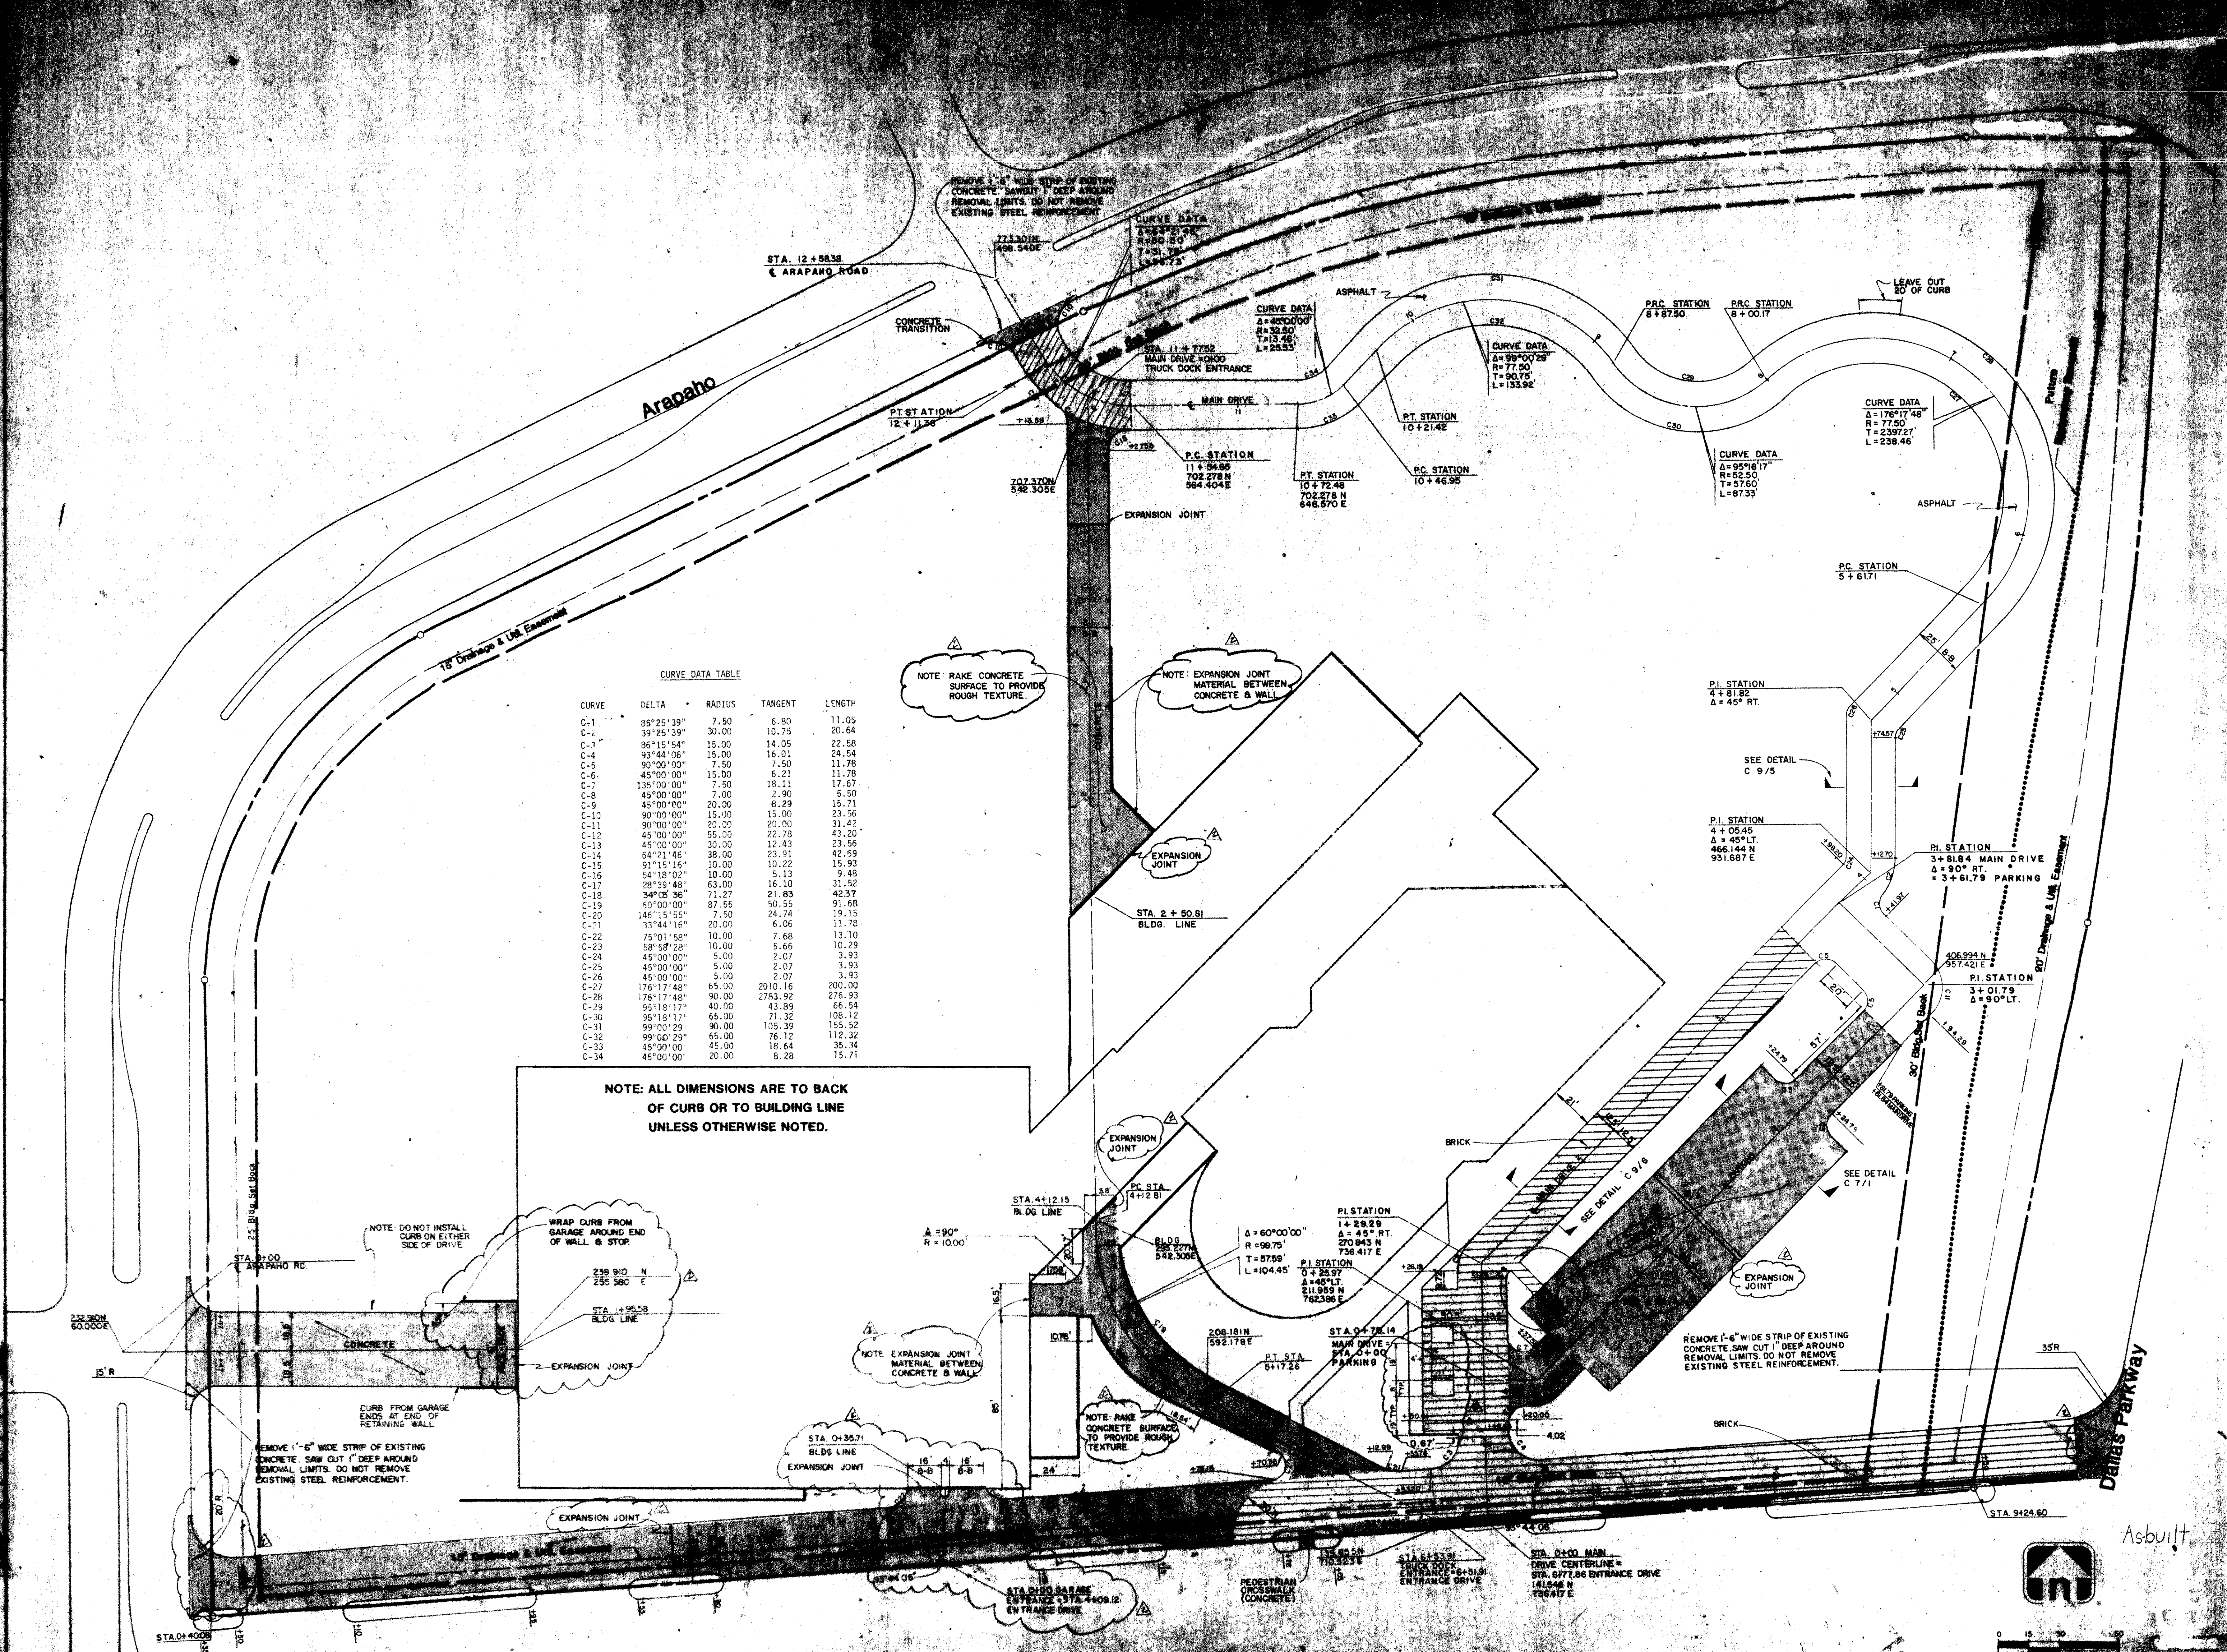

CURVE DATA TABLE

CURVE	DELTA	RADIUS	TANGENT	LENGTH
C-1	85°25'39"	7.50	6.80	11.05
C-2	39°25'39"	30.00	10.75	20.64
C-3	86°15'54"	15.00	14.05	22.58
C-4	93°44'06"	15.00	16.01	24.54
C-5	90°00'00"	7.50	7.50	11.78
C-6	45°00'00"	15.00	6.21	11.78
C-7	135°00'00"	7.50	18.11	17.67
C-8	45°00'00"	7.00	2.90	5.50
C-9	45°00'00"	20.00	6.29	15.71
C-10	90°00'00"	15.00	15.00	23.56
C-11	90°00'00"	25.00	20.00	31.42
C-12	45°00'00"	55.00	22.78	43.20
C-13	45°00'00"	30.00	12.43	23.56
C-14	64°21'46"	36.00	23.91	42.69
C-15	91°15'16"	10.00	10.22	15.93
C-16	54°18'02"	10.00	5.13	9.48
C-17	28°39'48"	63.00	16.10	31.52
C-18	34°05'36"	71.27	21.83	42.57
C-19	60°00'00"	87.55	50.55	91.68
C-20	146°15'55"	7.50	24.74	19.15
C-21	33°44'16"	20.00	6.06	11.78
C-22	75°01'58"	10.00	7.68	13.10
C-23	58°58'28"	10.00	5.66	10.29
C-24	45°00'00"	5.00	2.07	3.93
C-25	45°00'00"	5.00	2.07	3.93
C-26	45°00'00"	5.00	2.07	3.93
C-27	176°17'48"	65.00	2010.16	200.00
C-28	176°17'48"	90.00	2783.92	276.93
C-29	95°18'17"	40.00	43.89	66.54
C-30	95°18'17"	65.00	71.32	106.12
C-31	99°00'29"	90.00	105.39	155.52
C-32	99°00'29"	65.00	76.12	112.32
C-33	45°00'00"	45.00	18.64	35.34
C-34	45°00'00"	20.00	8.28	15.71

NOTE: ALL DIMENSIONS ARE TO BACK OF CURB OR TO BUILDING LINE UNLESS OTHERWISE NOTED.

WRAP CURB FROM GARAGE AROUND END OF WALL & STOP.

NOTE: DO NOT INSTALL CURB ON EITHER SIDE OF DRIVE.

REMOVE 1'-6" WIDE STRIP OF EXISTING CONCRETE. SAW CUT 1" DEEP AROUND REMOVAL LIMITS. DO NOT REMOVE EXISTING STEEL REINFORCEMENT.

EXPANSION JOINT

NOTE: EXPANSION JOINT MATERIAL BETWEEN CONCRETE & WALL.

NOTE: RAKE CONCRETE SURFACE TO PROVIDE ROUGH TEXTURE.



Asbuilt