


**AS-BUILT**

NOTE:  
This project was constructed to the best of my knowledge from information received from the contractor and a site visit in conformity to the Town of Addison, Texas standards and specifications and functions as designed.

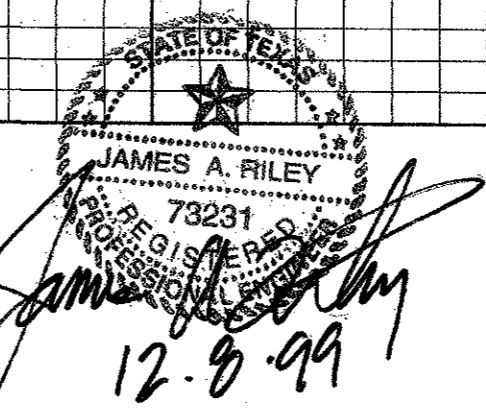

BENCHMARK:  
TOP OF CURB INLET AT THE NORTHWEST INTERSECTION OF ARAPAHO ROAD AND DALLAS NORTH PARKWAY.  
ELEVATION 613.33

GMP PACKAGE REV. 1  
SEPT. 30, 98

P.C. NO. 6  
DEC. 18, 98

**STORM SEWER AND WASTEWATER PROFILES**  
MILLENNIUM PHASE I  
TOWN OF ADDISON  
DALLAS COUNTY, TEXAS

BROCKETTE • DAVIS • DRAKE, inc.  
consulting engineers  
Civil & Structural Engineering-Surveying  
4144 North Central Expressway, Suite 1100 Dallas, Texas 75204  
(214)824-3647, fax (214) 824-7064

DESIGN	DRAWN	DATE	SCALE	NOTES	FILE	NO.
JAR	FG	11/98	1"=40'	BDD	C98365	C8