

CHANEY & HOPE, INC.
VOLUME 18194, PAGE 1741
D.R.D.C.T.

PARKING GARAGE
3 LEVELS

OFFICE BUILDING
2 STORY - AREUM
FIN. FLOOR ELEV. 618.0'

DALLAS NORTH PARKWAY

PART NO.	QUANTITY	DESCRIPTION	MATERIAL LIST	MANUFACTURER
1	1	4\"/>		

01.1800 RESOURCES
VOLUME 18070, PAGE 3638
D.R.D.C.T.




THIS DRAWING IS THE PROPERTY OF POWELL & POWELL. IT IS TO BE USED ONLY FOR THE PROJECT AND SITE SPECIFICALLY LISTED ABOVE. IT IS NOT TO BE REPRODUCED, COPIED, OR TRANSMITTED IN ANY FORM OR BY ANY MEANS, ELECTRONIC OR MECHANICAL, INCLUDING PHOTOCOPYING, RECORDING, OR BY ANY INFORMATION STORAGE AND RETRIEVAL SYSTEM, WITHOUT THE WRITTEN PERMISSION OF POWELL & POWELL.

NOTE: THIS EXHIBIT HAS BEEN PREPARED TO RECORD THE LOCATIONS OF THE FOLLOWING UNDERGROUND UTILITIES INSTALLED ON THIS SITE AS VERIFIED BY POWELL & POWELL:
1. 8\"/>

RECORD DRAWING
OF
INSTALLED UTILITIES
FOR
15851 DALLAS NORTH
PARKWAY ADDITION
OUT OF
G. W. FISHER SURVEY-ABSTRACT NO. 482
ADDISON, DALLAS COUNTY, TEXAS


POWELL & POWELL
Engineers and Consultants
3868 POND CREEK EXPWAY
SUITE 1100 DALLAS TEXAS 75244
(214) 512-4000
FEB. 1984 3144-93-6-17 E-290

B.M. BONNET CAP BOLT BETWEEN 'E' & 'L' IN 'MULEY' ON FIRE HYD. 300' N. OF DALLAS N. PKWY. AND 20' N. OF AIRPORT PKWY. ELEV. 617.47

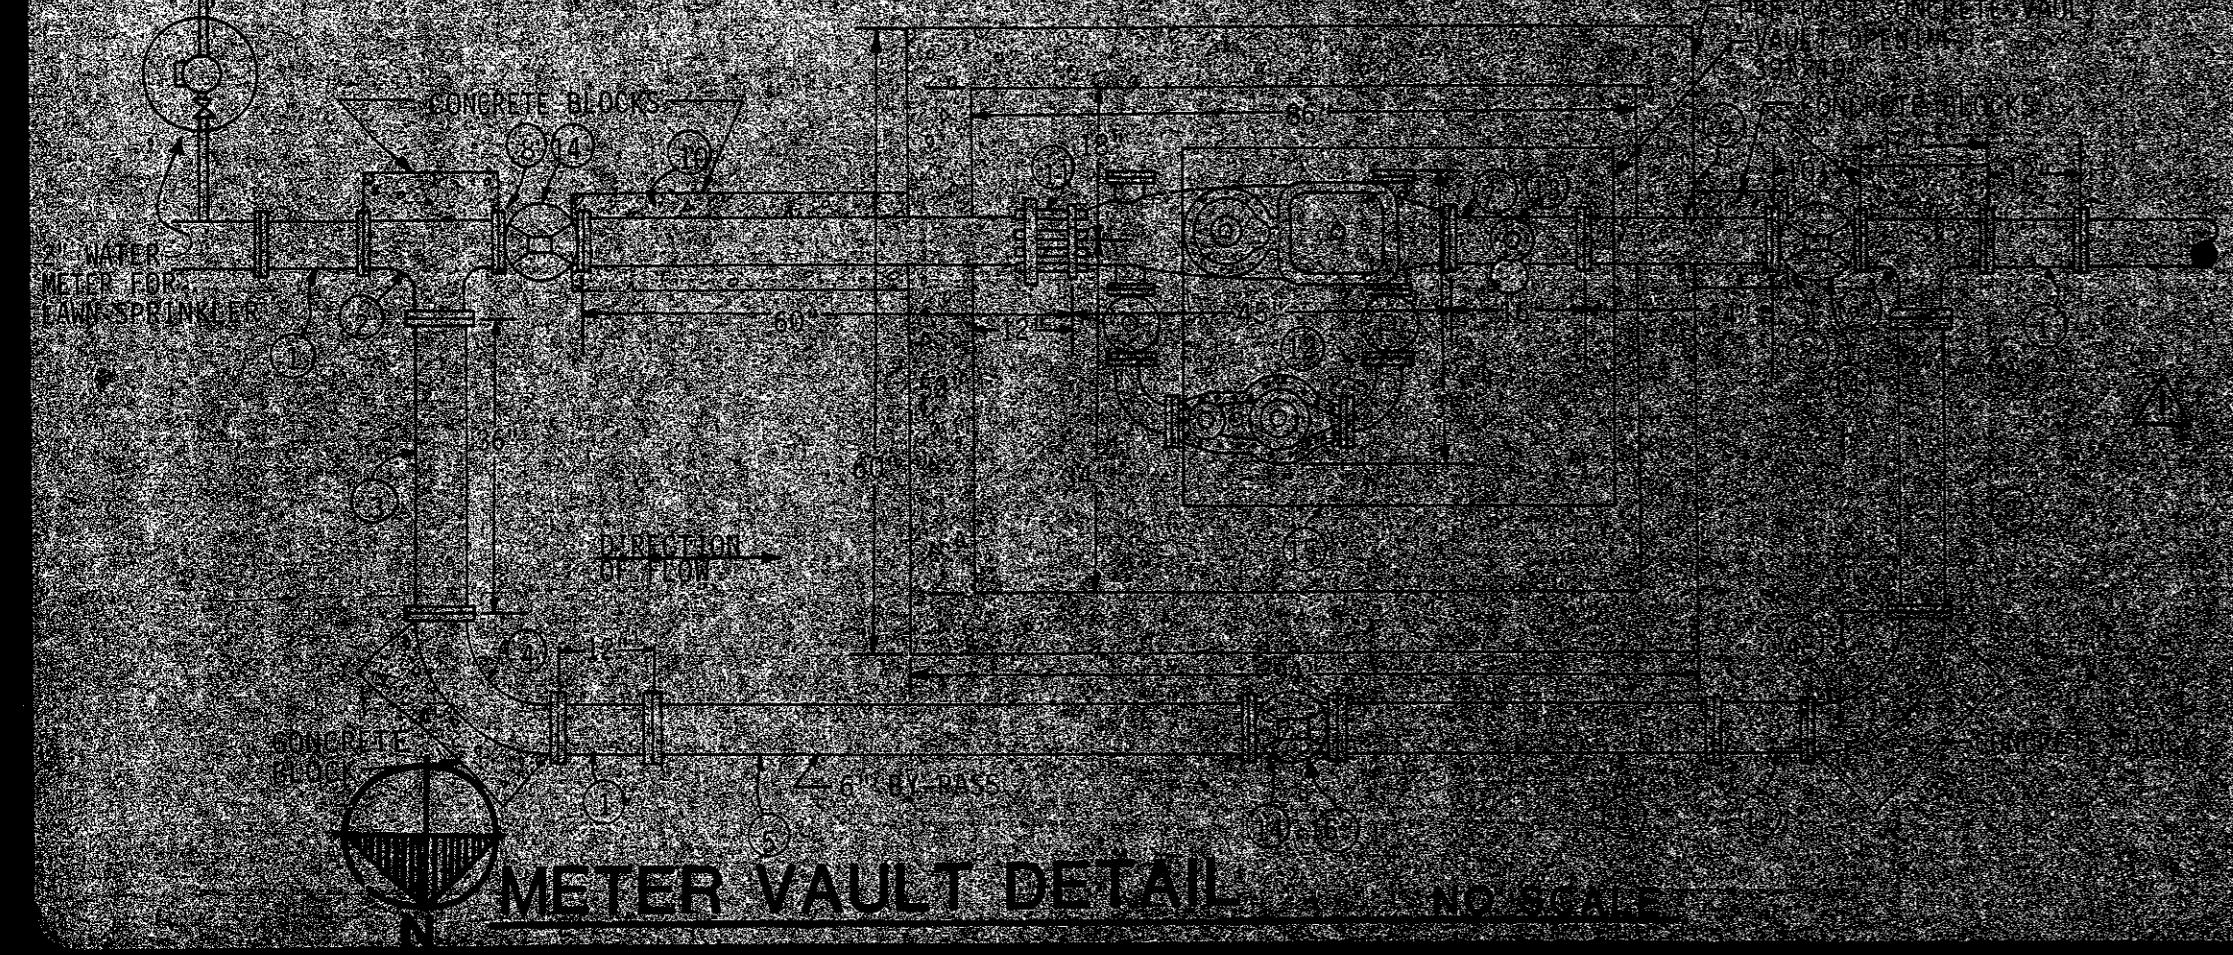

SHEPHERD + BOYD
ARCHITECTS PLANNERS & INTERIORS
8230 W. DALLAS SUITE 900
DALLAS TEXAS 75225
TELEPHONE 214/891-9000

The Madison
Young Companies
Development

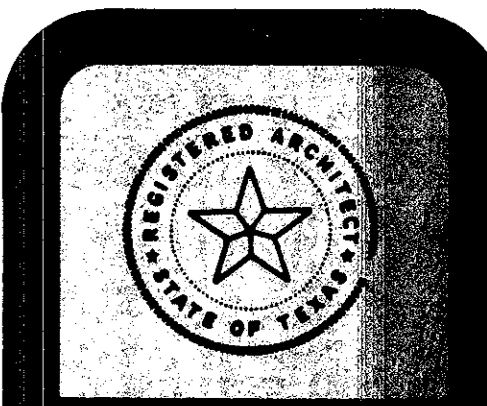

REVISION
REVISED 9-7-78
FIELD MEASUREMENTS
OF INSTALLED UTILITIES
ADDED BY POWELL & POWELL, 1/31/84
DATE 6-20-83 PERMIT 7-11-83 ISSUED

SHEET
ME-1