


C O R G A N

| | |
|----------------|---------------------------------|
| ISSUES | |
| 2.0 | ISSUE FOR CONSTRUCTION |
| 9/23/02 | |
| REVISIONS | |
| ADDENDUM NO. 1 | SERVICE YARD/WEST ENTRY 9/10/02 |
| ADDENDUM NO. 3 | |

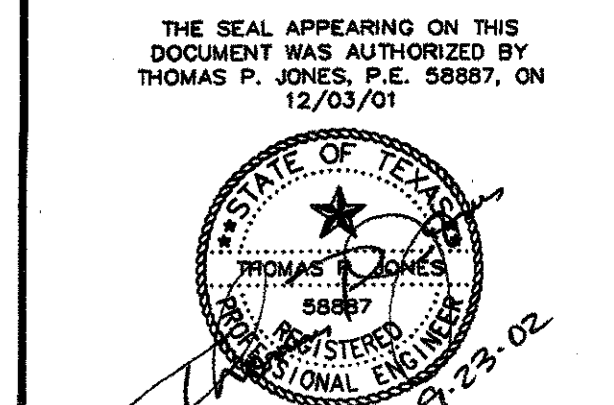

MBNA
 A M E R I C ASM
 HALLMARK CENTER SITE HARDENING


RECEIVED
 OCT 04 2002
 WHITING-TURNER
 DALLAS OFFICE

TOMDEN ENGINEERING
 12655 N. CENTRAL #1016
 DALLAS, TEXAS 75243
 (972) 386-6448 FAX: (972) 386-6409
 EMAIL: tomden@mail.net
 JOB No. 100.29

OVERALL PLAN

JOB 02143.00
 DATE 23 SEPT 02
 SHEET

C1.0

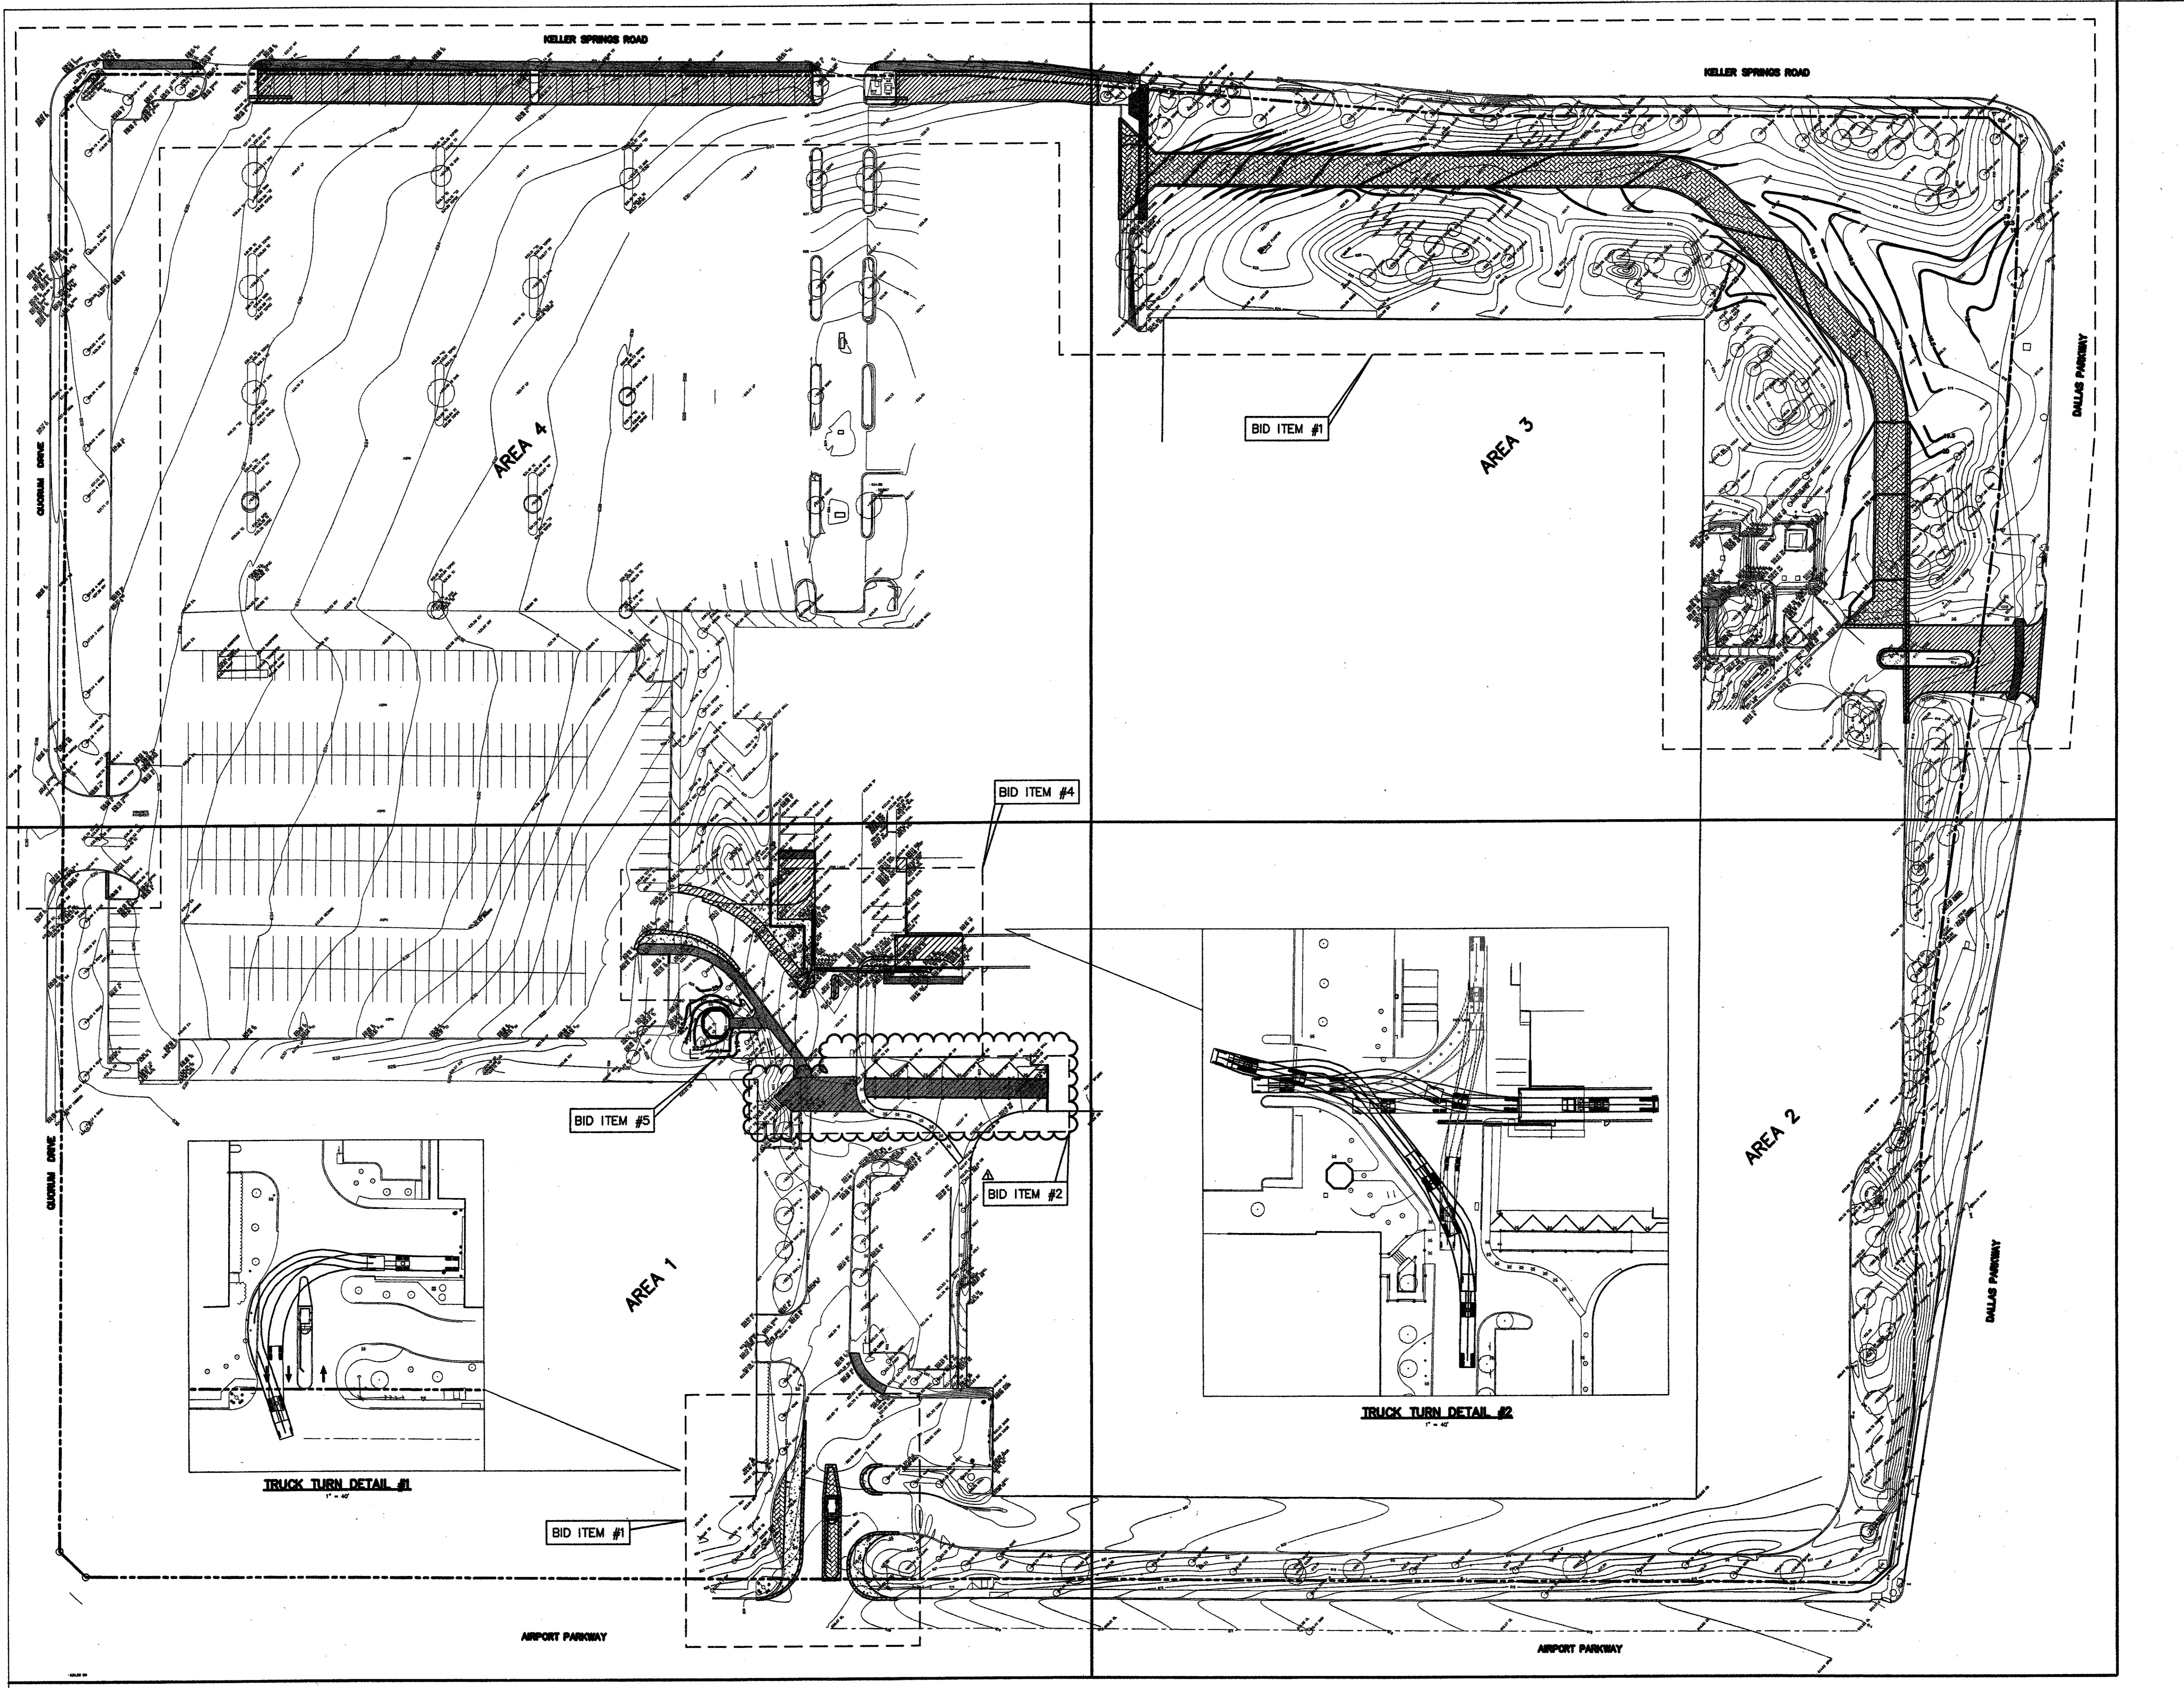

- 1) Obtain ROW Excavation Permit from: Town of Addison Public Works Dept. 16801 Westgrove Rd. Addison, TX 75001
- 2) Note changes to sidewalk + curb Specs. Also SEE ATTACHED
- 3) Curb expansion "bars" are to be placed at all locations where new curb abuts existing.

09/20/02 12:28
 C:\Land Projects\100-29.dwg\01SITE.dwg 09/20/02 12:28:23 PM PM CDT