


CURVE DATA				
NO.	A	R	T	L
1	16°30'00"	200.00'	29.00'	57.60'
2	16°18'00"	200.00'	28.64'	56.90'
3	04°59'42"	180.25'	7.86'	15.71'
4	04°00'18"	180.25'	6.30'	12.60'
5	05°00'00"	219.75'	9.59'	19.18'
6	04°30'49"	200.00'	7.86'	15.76'
7	04°29'11"	200.00'	7.83'	15.66'
8	05°00'00"	200.00'	8.73'	17.45'

BM NO. 1  
 SQUARE CUT ON TOP OF CURB AT THE RADIUS RETURN OF AN ISLAND LOCATED NEAR THE NORTHEAST CORNER OF LIBERTY PLAZA I, APPROXIMATELY 639 FEET NORTH OF THE SOUTHEAST PROPERTY CORNER.  
 ELEV. 622.14

BM NO. 2  
 CHISEL SQUARE ON THE END OF THE CURB RADIUS LOCATED ON THE DRIVEWAY ON THE NORTH SIDE OF KELLER SPRINGS ROAD, APPROXIMATELY 500 FEET WEST OF DALLAS PARKWAY.  
 ELEV. 626.24

BOUNDARY INFORMATION IS FROM A SURVEY BY GEORAM CORP. DATED FEB. 1984

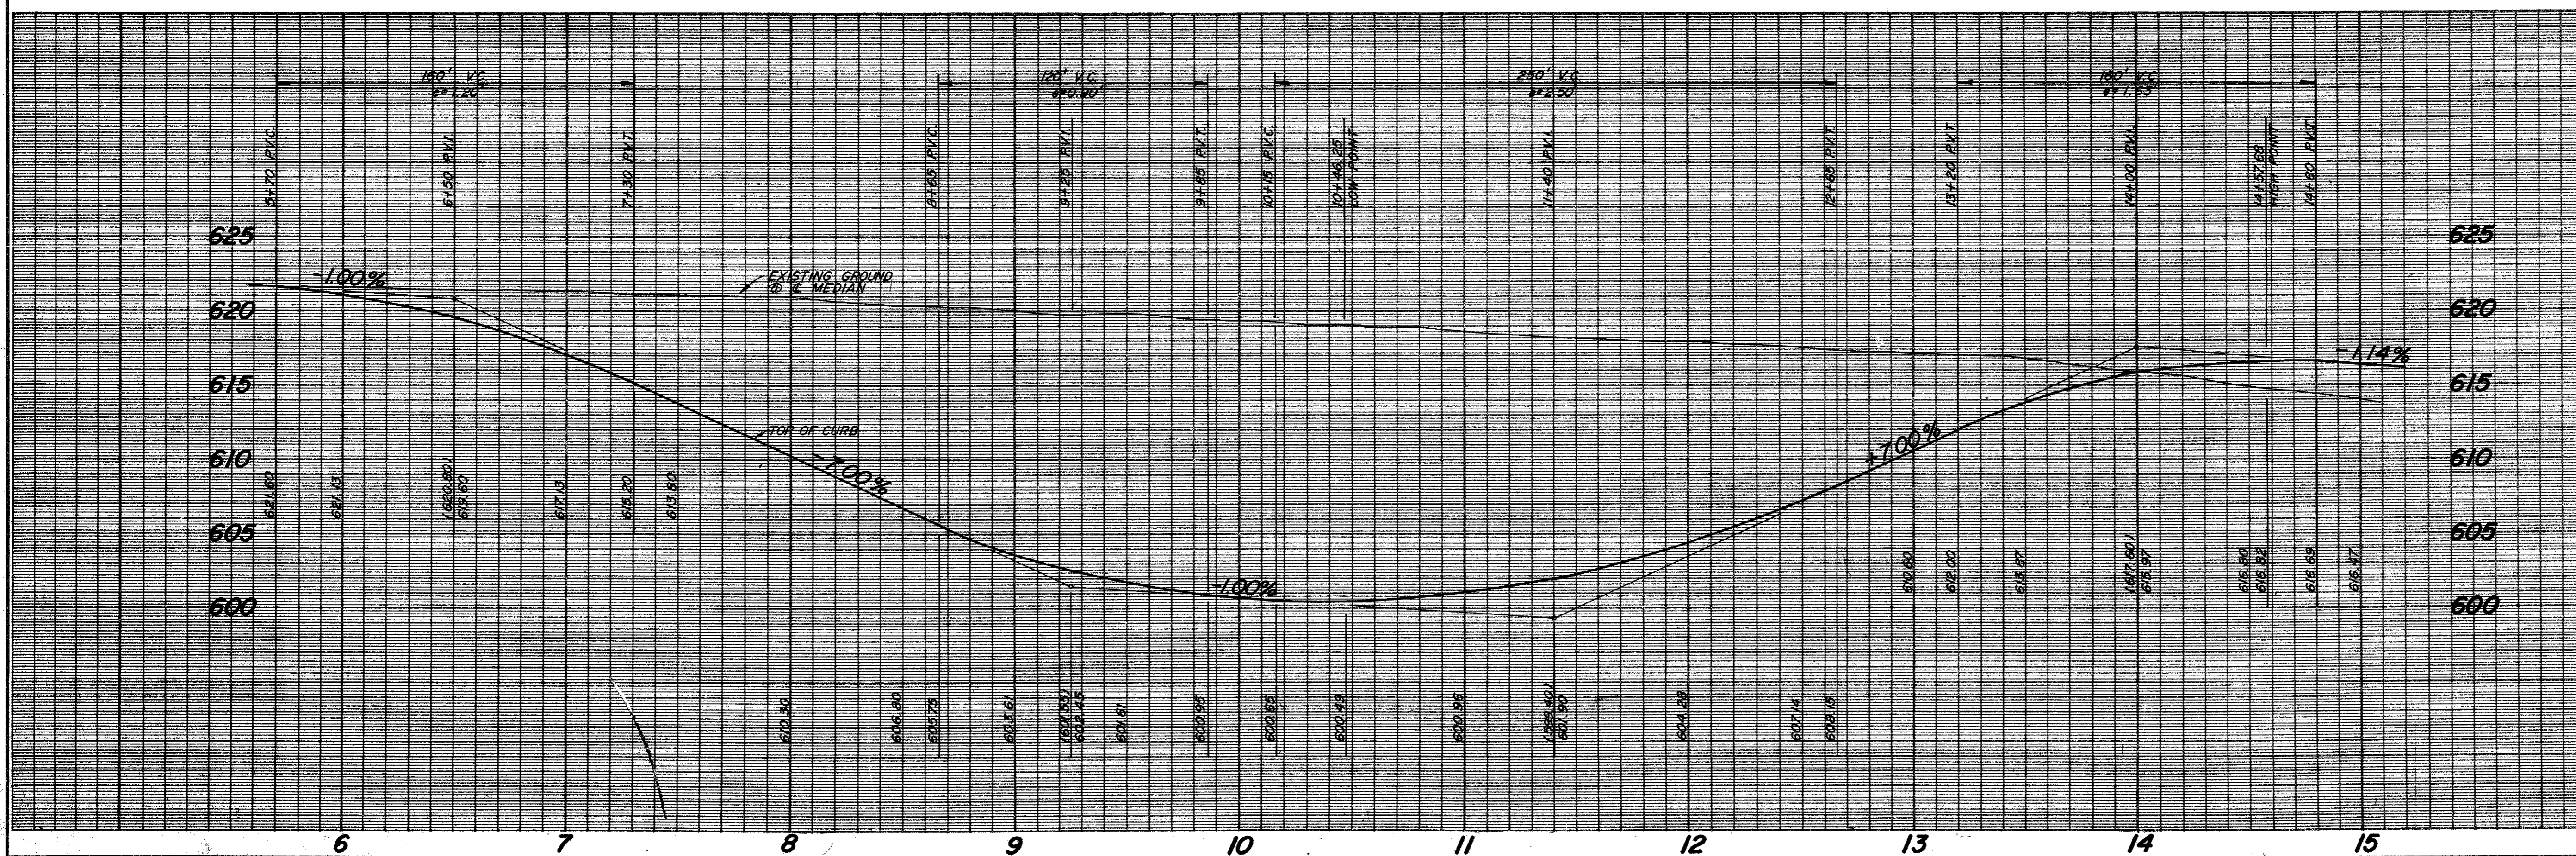

<b>LIBERTY BOULEVARD</b>					
<b>LIBERTY PLAZA</b>					
T.F. STONE COMPANIES, INC.					
JACK R. DAVIS & ASSOCIATES-ENGINEERS					
3535 TRAVIS, SUITE 100, DALLAS, TEXAS					
DESIGN	DRAWN	DATE	SCALE	NOTES	FILE
D.H.	J.A.R.	2/85	H-1"=40' V-1"=6'	FG.	C84146T
					NO.
					of