

Issued For Construction
 PC #18/8/86

Job No.
C34187

Revision

Add # 4, 7, 3, 85

Sheet Title
 WATER & SANITARY SEWER PLAN

Date
 6/03/85

Drawn

Sheet No.
C6



of sheets

WATER AND SANITARY SEWER GENERAL NOTES

- ALL MATERIALS AND WORKMANSHIP SHALL CONFORM TO THE CITY OF ADDISON STANDARDS AND SPECIFICATIONS.
- ALL WATER MAINS SHALL BE PVC SDR-18 WATER PIPE (BLUE BRUTE WITH WIRE TRACERS). TRACER TO BE #12 INSULATED COPPER.
- ALL WATER MAINS SHALL HAVE MINIMUM COVER BELOW FINISHED GRADES AS FOLLOWS: 6" & 8" - 48" OR AS REQUIRED TO CLEAR OTHER UTILITIES.
- ALL SEWER MAINS SHALL BE PVC SDR-35 SANITARY SEWER PIPE.
- ALL PIPE EMBEDMENT SHALL BE AS DETAILED ON THIS SHEET.
- ALL TEES, CONNECTIONS, BENDS, DEAD-ENDS, FIRE HYDRANTS, ETC., SHALL BE SECURELY HOOKED AGAINST TRENCH WALLS USING 3000 PSI CONCRETE.
- ALL FIRE HYDRANTS SHALL BE MUELLER CENTERLINE MODEL AND SHALL CONFORM TO THE CITY OF ADDISON STANDARDS AND SPECIFICATIONS.
- ALL TRENCH BACKFILL FOR THESE UTILITIES SHALL BE COMPACTED AS REQUIRED BY CITY, BUT IN NO CASE SHALL THE TOP 12" BE COMPACTED TO LESS THAN 90% RATIO DENSITY WITH THE REMAINDER OF THE TRENCH BEING COMPACTED TO THAT OF ADJOINING SOIL CONDITIONS.
- CONTRACTOR TO VERIFY LOCATION OF ALL UTILITIES PRIOR TO BEGINNING WORK AND SHALL PROTECT EXISTING IMPROVEMENTS DURING CONSTRUCTION.
- THE 8" FIRE LINE METER SHALL BE HERSEY MODEL D.C. DETECTOR CHECK WITH 2" BYPASS TURNING METER. THE DETECTOR CHECK SHALL BE INSTALLED IN A PRECAST OR CAST-IN-PLACE CONCRETE PIT WITH A CONCRETE FLOOR, WITH THE METER NO LOWER THAN 18" BELOW FINISHED GRADE. THE PIT SHALL BE OF ADEQUATE SIZE TO REMOVE METER WITHOUT HAVING TO DISASSEMBLE METER. THE DOORS TO THE PIT SHALL BE OF THE "BILCO" TYPE, BUT NOT NECESSARILY OF THAT BRAND.
- THE 8" DOMESTIC WATER METER SHALL BE HERSEY 6" COMPOUND METER MODEL MCT WITH 6" BYPASS. THE METER SHALL BE INSTALLED IN A PRECAST OR CAST-IN-PLACE CONCRETE PIT WITH A CONCRETE FLOOR, WITH THE METER NO LOWER THAN 18" BELOW FINISHED GRADE. THE PIT SHALL BE OF ADEQUATE SIZE TO REMOVE METER WITHOUT HAVING TO DISASSEMBLE METER. THE DOORS TO THE PIT SHALL BE OF THE "BILCO" TYPE, BUT NOT NECESSARILY OF THAT BRAND.
- THE CONTRACTOR SHALL INCLUDE IN HIS BID PRICE ALL COSTS OF UTILITY CONNECTIONS, TAP FEES AND THE TESTING OF NEW MAINS REQUIRED BY THE CITY OF ADDISON TO COMPLETE THE WORK WHETHER THESE SERVICES ARE PERFORMED BY THE CONTRACTOR OR BY OTHERS.

STORM DRAINAGE GENERAL NOTES

- ALL MATERIALS AND WORKMANSHIP SHALL CONFORM TO THE CITY OF ADDISON STANDARDS AND SPECIFICATIONS.
- ALL REINFORCED CONCRETE PIPE SHALL BE MINIMUM CLASS III PIPE WITH TONGUE AND GROOVE JOINTS. RAM NECK SEWER OR APPROVED EQUAL SHALL BE USED IN ALL PIPE JOINTS.
- STORM DRAINAGE PIPE LESS THAN 15" DIAMETER SHALL BE EXTRA STRENGTH REINFORCED CONCRETE PIPE, VERIFIED CLAY PIPE OR PVC PIPE AT THE CONTRACTOR'S OPTION WITH THE ENGINEER'S APPROVAL.
- WHENEVER A SMALLER PIPE IS JOINED END-TO-END TO A LARGER PIPE, A CONCRETE COLLAR SHALL BE PLACED AROUND THE PIPES OVER THE JOINT.
- THE CONTRACTOR SHALL VERIFY LOCATION OF ALL UTILITIES PRIOR TO BEGINNING WORK AND SHALL PROTECT EXISTING IMPROVEMENTS DURING CONSTRUCTION.
- ALL TRENCH BACKFILL FOR STORM SEWER SHALL BE COMPACTED AS REQUIRED BY CITY, BUT IN NO CASE SHALL THE TOP 12" BE COMPACTED TO LESS THAN 90% STANDARD PROCTOR WITH THE REMAINDER BEING COMPACTED TO THAT OF ADJOINING SOIL CONDITIONS.
- CRUSHED STONE BEDDING OR APPROVED EQUAL WILL BE PROVIDED WHEN ROCK IS ENCOUNTERED IN STORM SEWER TRENCHES.
- ALL DRAINAGE STRUCTURES SHALL BE 3000 PSI CONCRETE AT 28 DAYS UNLESS OTHERWISE NOTED ON PLANS.

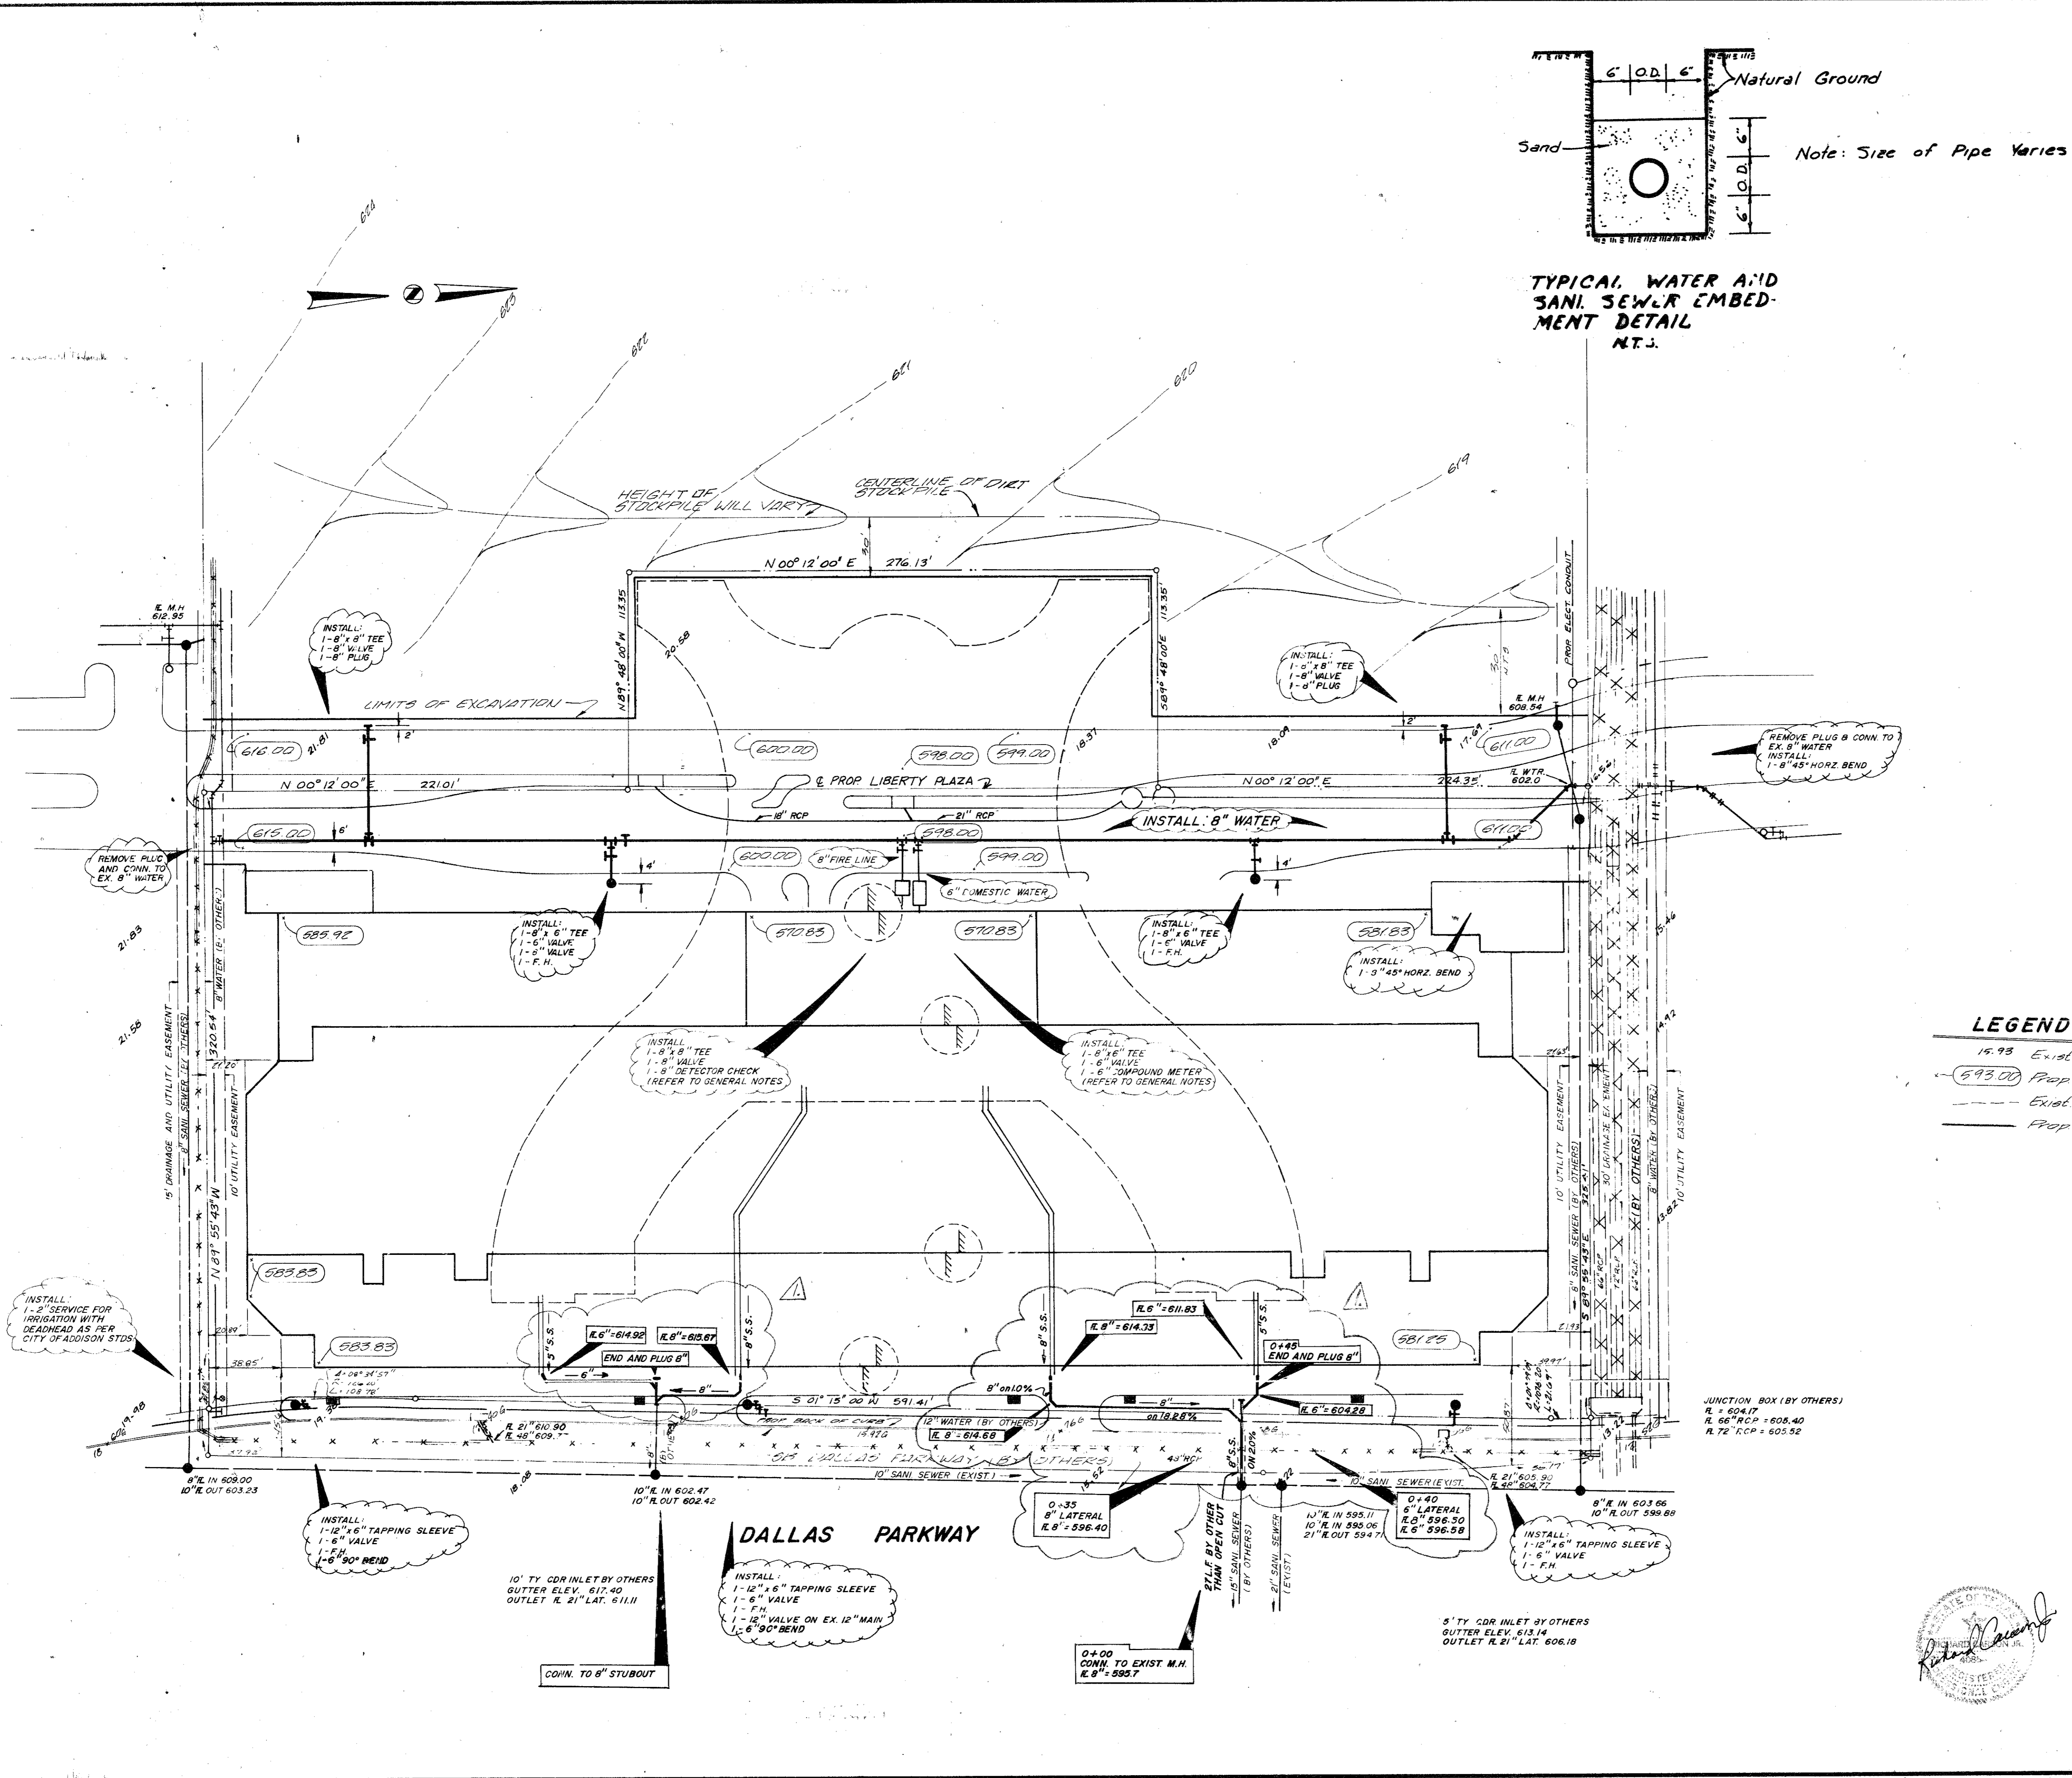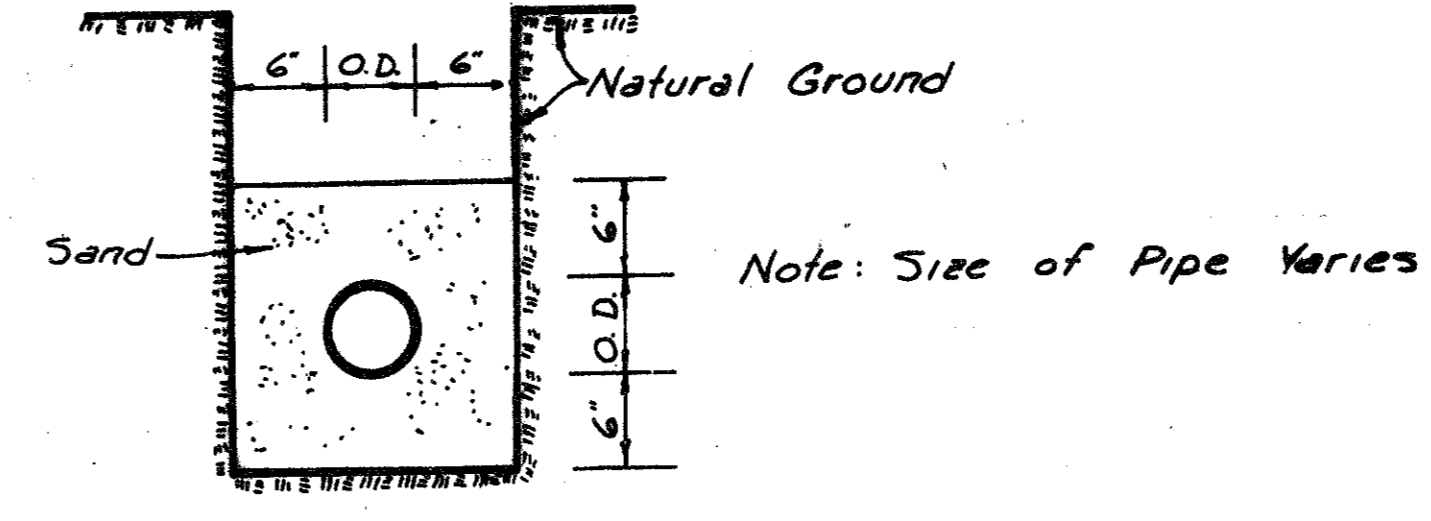

WATER & SANITARY SEWER PLAN

SUNBELT CORPORATE HEADQUARTERS
SUN DEVELOPMENT COMPANY

JACK R. DAVIS & associates, inc.
 consulting civil engineers & surveyors
 3535 Travis Street, Suite 100
 Dallas, Texas 75204 (214) 522-9540

design	drawn	date	scale	notes	job no.	sheet no.
JRD	RT	6/85	1" = 40'	JRD	C34187	of

JACK R. DAVIS & associates, inc.
 consulting civil engineers & surveyors
 3535 Travis Street, Suite 100
 Dallas, Texas 75204 (214) 522-9540