



## OMNIPLAN

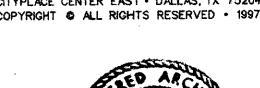

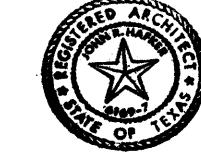

June. 4/1-

INTERVEST COMPANIES DEVELOPER WILCOX DEVELOPMENT SERVICES, INC. PROJECT MANAGER

> SITE PLAN 9716.00

10/14/97