


This seal indicates only that I have reviewed the consultant's work and coordinated it with the overall project.



OMNIPLAN
 CITYPLACE CENTER EAST - DALLAS, TX 75204
 COPYRIGHT © ALL RIGHTS RESERVED - 1997

ONE HANOVER PARK OFFICE BUILDING ADDISON, TEXAS

INTERVEST COMPANIES DEVELOPER
 WILCOX DEVELOPMENT SERVICES, INC. PROJECT MANAGER

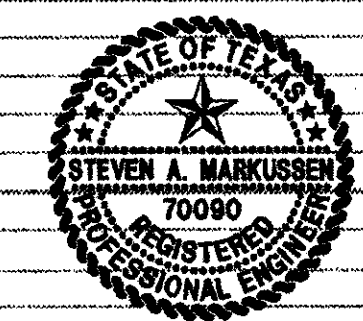

THE SEAL APPEARING ON THIS DOCUMENT WAS AUTHORIZED BY STEVEN A. MARKUSSEN P.E. 70990 ON 08/05/97. ALTERATION OF A SEALED DOCUMENT WITHOUT PROPER NOTIFICATION TO THE RESPONSIBLE ENGINEER IS AN OFFENSE UNDER THE TEXAS ENGINEERING PRACTICE ACT.

PACHECO KOCH Consulting Engineers, Inc.
 9401 LBJ Freeway, Suite 300 Dallas, Texas 75243 (214) 236-3031
 Civil Engineering - Land Surveying

STORM DRAIN PROFILES					
ONE HANOVER PARK					
N. DALLAS TOLLWAY AT EXCEL PARKWAY					
DALLAS COUNTY					
TOWN OF ADDISON, TEXAS					
DESIGN	DRAWN	DATE	SCALE	NOTES	FILE NO.
SAM	CHI	9/5/97	1"=20'H 1"=5'V		C-21

STORM DRAIN PROFILES
 9716.00
 EARLY ISSUE 9.5.97

C2.1