


This seal indicates only that I have reviewed the consultants work and coordinated it with the overall project.

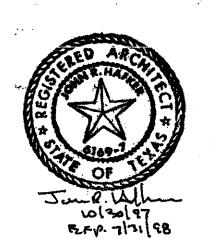

## **OMNIPLAN**

CITYPLACE CENTER EAST • DALLAS, TX 75204
COPYRIGHT • ALL RIGHTS RESERVED • 1997

ONE HANOVER PARK OFFICE BUILDING ADDISON, TEXAS

INTERVEST COMPANIES
DEVELOPER WILCOX DEVELOPMENT SERVICES, INC. PROJECT MANAGEF

STORM WATER POLLUTION CONTROL DETA

EARLY ISSUE 9.5.97

DWG NO: 1787-15