

GENERAL NOTES:

- 1. ALL CONSTRUCTION WITHIN THE ADDISON TOWN LIMITS SHALL BE IN ACCORDANCE WITH THESE PLANS AND THE TOWN OF ADDISON DEVELOPMENT SERVICES' STANDARD CONSTRUCTION DETAILS'...

STORM DRAINAGE (CONTINUED)

- 7. THE SITE UTILITY CONTRACTOR SHALL PROVIDE ALL MATERIALS AND APPURTENANCES NECESSARY FOR COMPLETE INSTALLATION OF THE STORM SEWER.

GRADING

- 1. ALL CONSTRUCTION TO BE IN ACCORDANCE WITH THESE PLANS AND THE TOWN OF ADDISON DEVELOPMENT SERVICES' STANDARD CONSTRUCTION DETAILS' AND THE FINAL GEOTECHNICAL REPORT...

PAVING

- 1. ALL CONSTRUCTION WITHIN THE TOWN OF ADDISON LIMITS SHALL BE IN ACCORDANCE WITH THESE PLANS AND THE TOWN OF ADDISON DEVELOPMENT SERVICES' STANDARD CONSTRUCTION DETAILS'...

PAVING (CONTINUED)

- 8. TESTING OF MATERIALS REQUIRED FOR THE CONSTRUCTION OF THE PAVING IMPROVEMENTS SHALL BE PERFORMED BY AN APPROVED AGENCY FOR TESTING MATERIALS...

WATER AND SANITARY

- 1. ALL MATERIALS AND WORKMANSHIP TO CONFORM TO THE REQUIREMENTS SET FORTH IN THE TOWN OF ADDISON 'WATER SYSTEM REQUIREMENTS' MANUAL FOR GENERAL PROCEDURES FOR THE DESIGN OF WATER LINES...

KHA GENERAL CONSTRUCTION NOTES

- 1. ALL CONSTRUCTION SHALL BE IN ACCORDANCE WITH THE STANDARD SPECIFICATIONS FOR PUBLIC WORKS CONSTRUCTION FOR THE NORTH CENTRAL TEXAS COUNCIL OF GOVERNMENTS (LATEST EDITION)...

KHA GENERAL CONSTRUCTION NOTES (CONTINUED)

- 37. THESE PLANS, PREPARED BY KIMLEY-HORN AND ASSOCIATES, INC. DO NOT EXTEND TO OR INCLUDE DESIGNS OR SYSTEMS PERTAINING TO THE SAFETY OF THE CONTRACTOR OR ITS EMPLOYEES, AGENTS OR REPRESENTATIVES...

REFER TO TNRC/TCOEQ DESIGN GUIDELINES (CHAPTER 290) FOR ALL UTILITY CROSSINGS.

STOP! CALL BEFORE YOU DIG DIG TESS 1-800-DIG-TESS (at least 72 hours prior to digging)

WARNING: CONTRACTOR TO VERIFY PRESENCE AND EXACT LOCATION OF ALL UTILITIES PRIOR TO CONSTRUCTION.

GEOTECHNICAL REPORT REPORT NO. G110598 ALPHA TESTING DALLAS, TEXAS DATED: JULY 5, 2011

UTILITY CONTACTS


- ONCOR (ELECTRIC) CONTACT: KAREN EASTMAN 817-335-7050

RECORD DRAWINGS (July 2013)

INFORMATION PROVIDED BY: Rogers-O'Brien Construction Company

THE CONTRACTOR SHALL FIELD VERIFY THE HORIZONTAL AND VERTICAL LOCATIONS OF ALL EXISTING UTILITIES PRIOR TO START OF CONSTRUCTION AND SHALL NOTIFY THE CONSTRUCTION MANAGER AND ENGINEER OF ANY CONFLICTS DISCOVERED...

Kimley-Horn and Associates, Inc. Tel: No. (972) 315-3580 Fax: No. (972) 315-3779

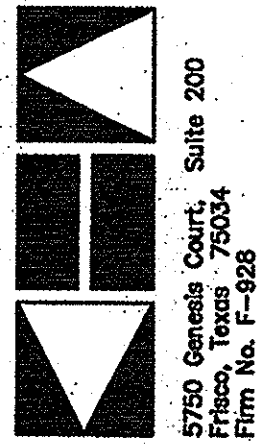

METHODIST PAVILION ONE TOWN OF ADDISON, DALLAS COUNTY, TEXAS

GENERAL NOTES