

CONSTRUCTION SPECIFICATIONS FOR SILT BARRIER FENCE MATERIALS:

1. SYNTHETIC FILTER FABRIC SHALL BE A PERVIOUS SHEET OF POLYPROPYLENE, NYLON, POLYESTER OR ETHYLENE YARN AND SHALL BE CERTIFIED BY THE MANUFACTURER OR SUPPLIER AS CONFORMING TO THE FOLLOWING REQUIREMENTS (PER ASTM METHODS):

PHYSICAL PROPERTY REQUIREMENTS:

FILTERING EFFICIENCY 75% (MIN.)
 TENSILE STRENGTH AT 20% EXT. STRENGTH = 50 LBS./LIN. IN. (MIN.)
 MAXIMUM ELONGATION STD. STRENGTH = 30 LBS./LIN. IN. (MIN.)
 FLOW RATE 30 GAL./SQ. FT./MINUTE (MIN.)






2. SYNTHETIC FILTER FABRIC SHALL CONTAIN ULTRAVIOLET RAY INHIBITORS AND STABILIZERS TO PROVIDE A MINIMUM OF 6 MONTHS OF EXPECTED USABLE CONSTRUCTION LIFE AT A TEMPERATURE RANGE OF 0° TO 120°.

INSTALLATION:

- THE HEIGHT OF THE SILT FENCE SHALL BE A MINIMUM OF 15" AND A MAXIMUM OF 18" ABOVE FINAL GRADE.
- STANDARD STRENGTH SYNTHETIC FILTER FABRIC SHALL BE PURCHASED IN A CONTINUOUS ROLL AND CUT TO THE LENGTH OF THE BARRIER TO AVOID THE USE OF JOINTS, (AND THUS IMPROVE THE BARRIER'S STRENGTH AND EFFICIENCY).
- STAKES FOR THE SILT FENCE SHALL BE 2" x 2" WOOD WITH A MINIMUM LENGTH OF 3 FEET.
- THE STAKES SHALL BE SPACED A MAXIMUM OF 5 FEET APART AT THE BARRIER LOCATION AND DRIVEN SECURELY INTO THE GROUND (18" MIN.).
- A TRENCH SHALL BE EXCAVATED APPROX. 6" WIDE AND 6" DEEP ALONG THE LINE OF STAKES AND UPSLOPE FROM THE BARRIER.
- THE SILT FENCE SHALL BE STAPLED TO THE STAKES WITH 8" (MIN.) OF FABRIC EXTENDED INTO THE TRENCH. HEAVY DUTY WIRE STAPLES (1/2" LONG MIN.) SHALL BE USED. THE FENCE SHALL NOT BE STAPLED TO EXISTING TREES.
- THE TRENCH SHALL BE BACKFILLED AND THE SOIL COMPACTED OVER THE FENCE MATERIAL.
- IF A SILT FENCE IS TO BE CONSTRUCTED ACROSS A DITCH LINE OR SWALE, THE BARRIER SHALL BE OF SUFFICIENT LENGTH TO ELIMINATE END FLOW. THE PLAN CONFIGURATION SHALL RESEMBLE AN ARC OR HORSESHOE WITH THE ENDS ORIENTED UPSLOPE.
- SILT FENCES SHALL BE REMOVED WHEN THEY HAVE SERVED THEIR USEFUL PURPOSE, BUT NOT BEFORE THE UPSLOPE AREA HAS BEEN PERMANENTLY STABILIZED.

MAINTENANCE:

- SILT FENCES SHALL BE INSPECTED IMMEDIATELY AFTER RAINFALL AND AT LEAST DAILY DURING PROLONGED RAINFALL. ANY REQUIRED REPAIRS SHALL BE MADE IMMEDIATELY.
- SHOULD THE FABRIC ON A SILT FENCE DECOMPOSE OR BECOME INEFFECTIVE PRIOR TO THE END OF THE EXPECTED USABLE LIFE AND THE SILT FENCE IS STILL NECESSARY, IT SHALL BE REPLACED IMMEDIATELY.
- SEDIMENT DEPOSITS SHALL BE REMOVED WHEN DEPOSITS REACH APPROXIMATELY 1/3 THE HEIGHT OF THE FENCE.
- ANY SEDIMENT DEPOSITS REMAINING IN PLACE AFTER THE SILT FENCE IS NO LONGER REQUIRED SHALL BE DRESSED TO CONFORM WITH THE EXISTING GRADE, PREPARED AND SEEDED.
- THERE SHOULD BE NO GAPS OR SAGS IN THE SILT FENCE.

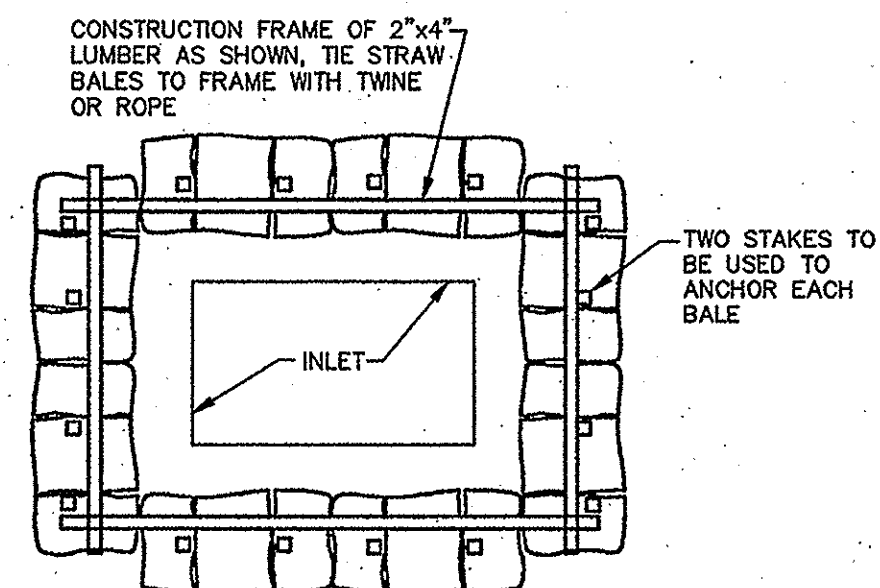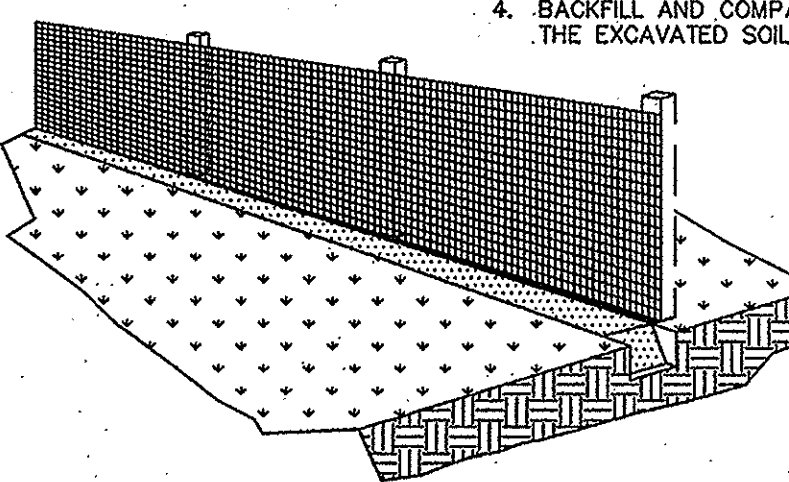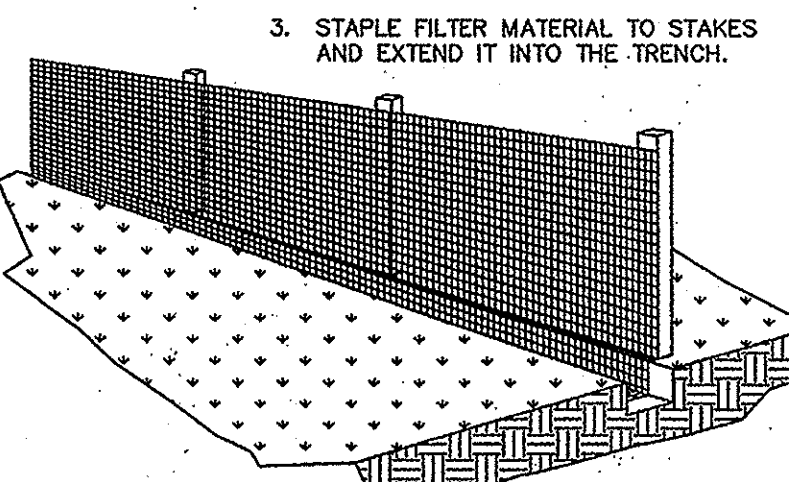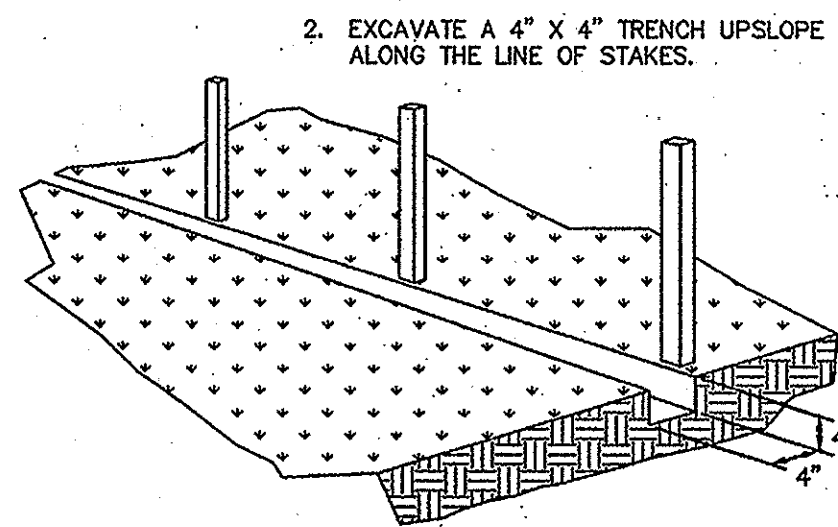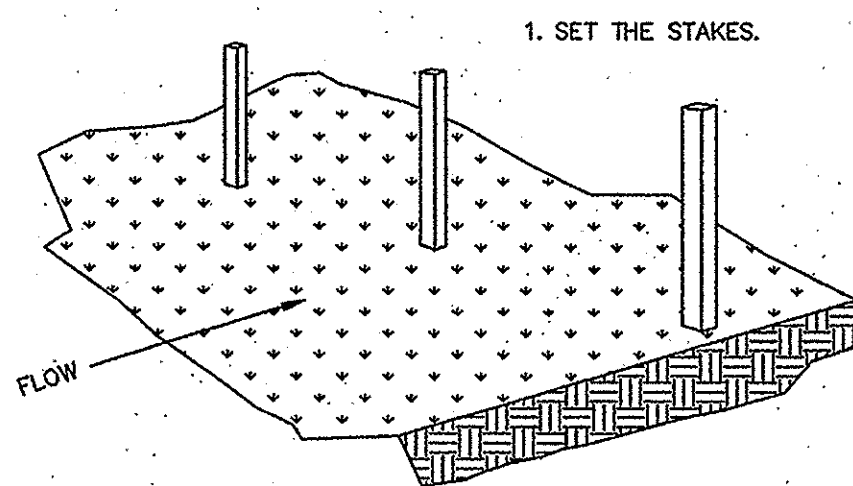


NOTE: STRAW BALE SEDIMENT BARRIER TO BE USED AROUND INLETS AND OTHER OPENINGS INTO DRAINAGE SYSTEMS THROUGHOUT CONSTRUCTION


CONSTRUCTION OF A FILTER BARRIER
N.T.S.

TYPE \"/>


(SF)

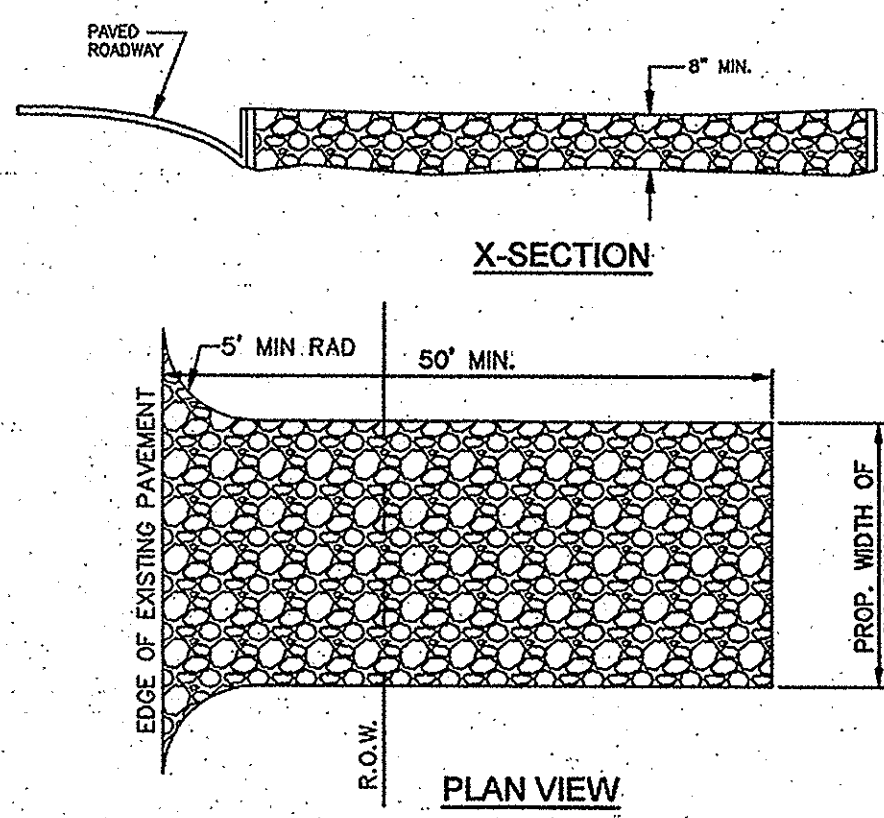

NOTE: VERTICAL PANEL BARRICADES TO BE PLACED WHEN LOCATED ON AN ACTIVE STREET.

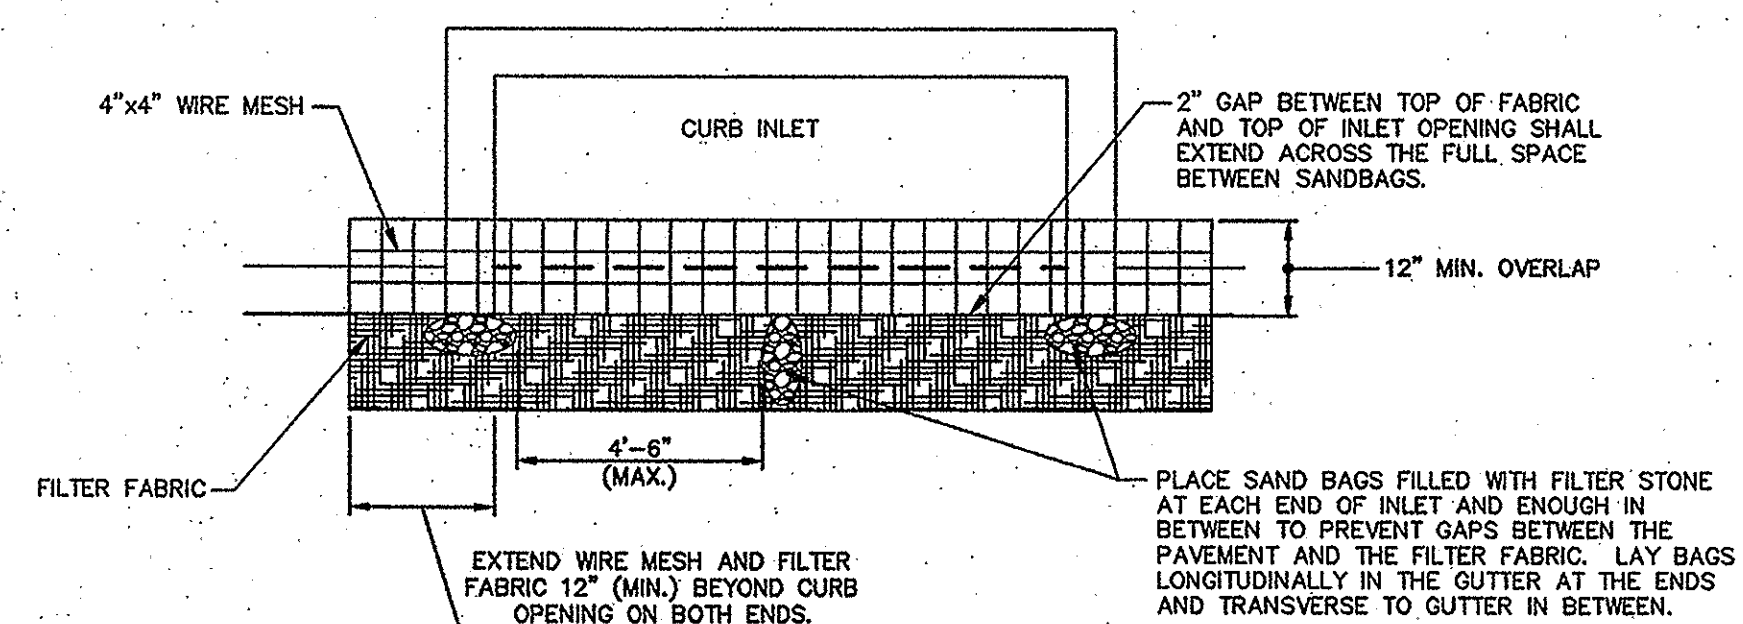

INLET PLAN VIEW

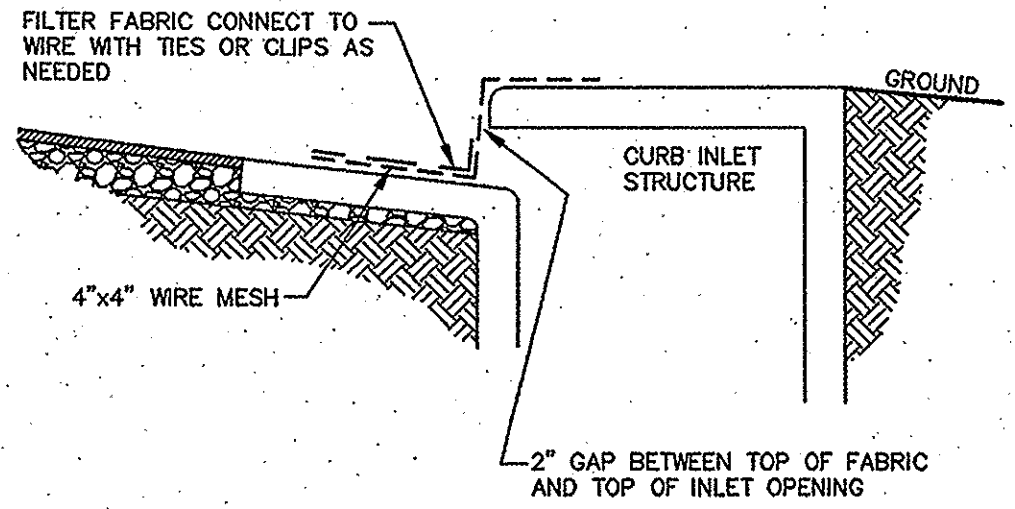

INLET SECTION

TYPE C CURB INLET PROTECTION
INLET PROTECTOR DETAILS


- NOTES:
- Stone size - 3 to 5 inches crushed rock.
 - Length - as effective, but not less than 50 feet.
 - Thickness - not less than 8 inches.
 - Width - not less than full width of all points of ingress or egress.
 - Washing - when necessary, wheels shall be cleaned to remove sediment prior to entrance onto public roadway. When washing is required, it shall be done on an area stabilized with crushed stone which drains into an approved trap or sediment basin. All sediment shall be prevented from entering any storm drain, ditch or watercourse using approved methods.
 - Maintenance - the entrance shall be maintained in condition which will prevent tracking or flowing of sediment onto public roadways. This may require periodic top dressing with additional stone as conditions demand, and repair and/or cleanout of any measures used to trap sediment. All sediment spilled, dropped, washed or tracked onto public roadway, must be removed immediately.
 - Drainage - entrance must be properly graded or incorporate a drainage swale to prevent runoff from leaving the construction site.
 - Contractor to coordinate exact location of this detail.

CONSTRUCTION ENTRANCE
N.T.S.

TYPE C CURB INLET PROTECTION
N.T.S.


(CE)

(IP1)

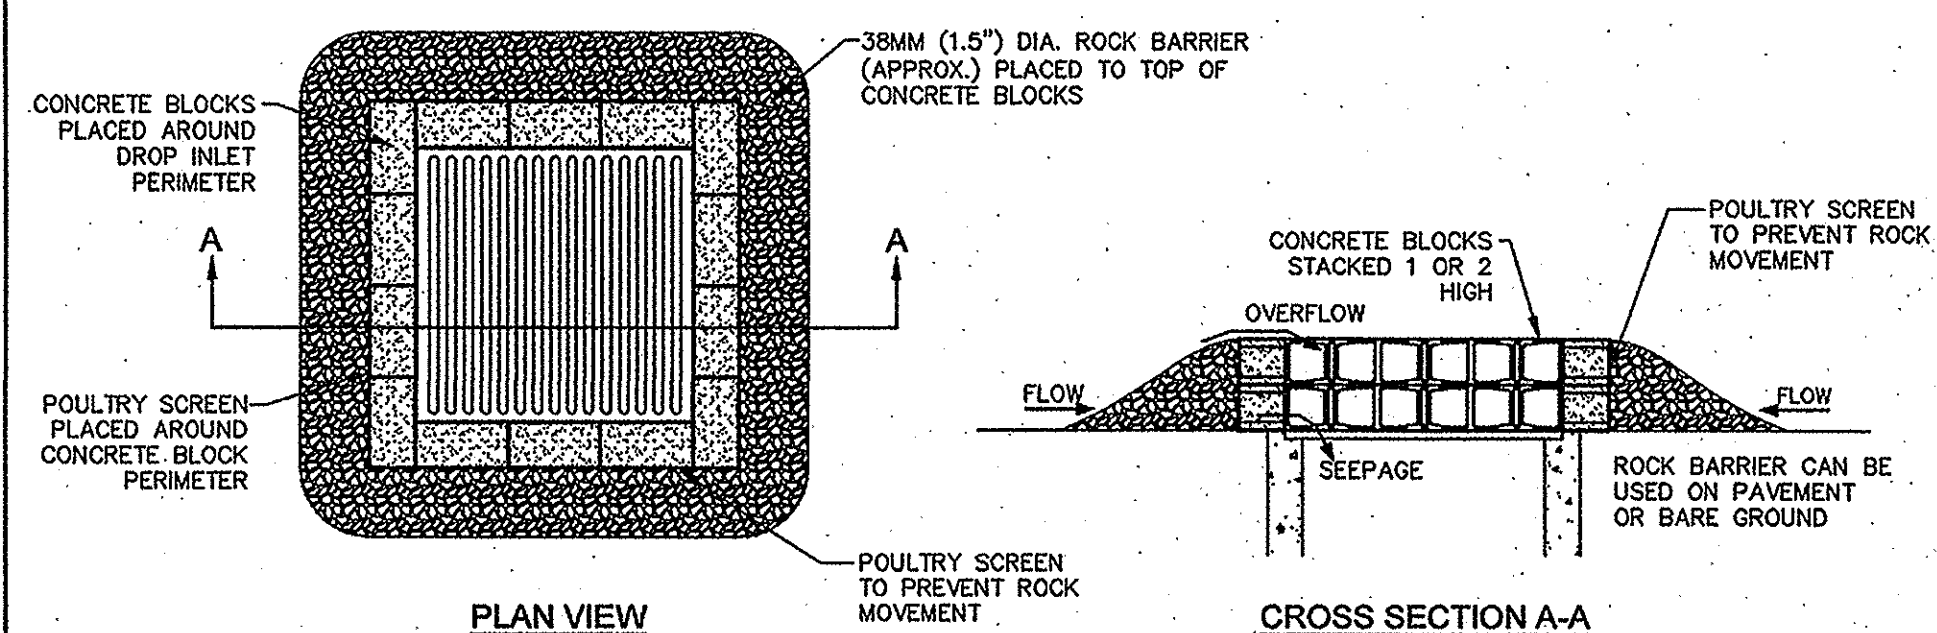

GRATE INLET PROTECTION DETAIL
N.T.S.

(IP2)

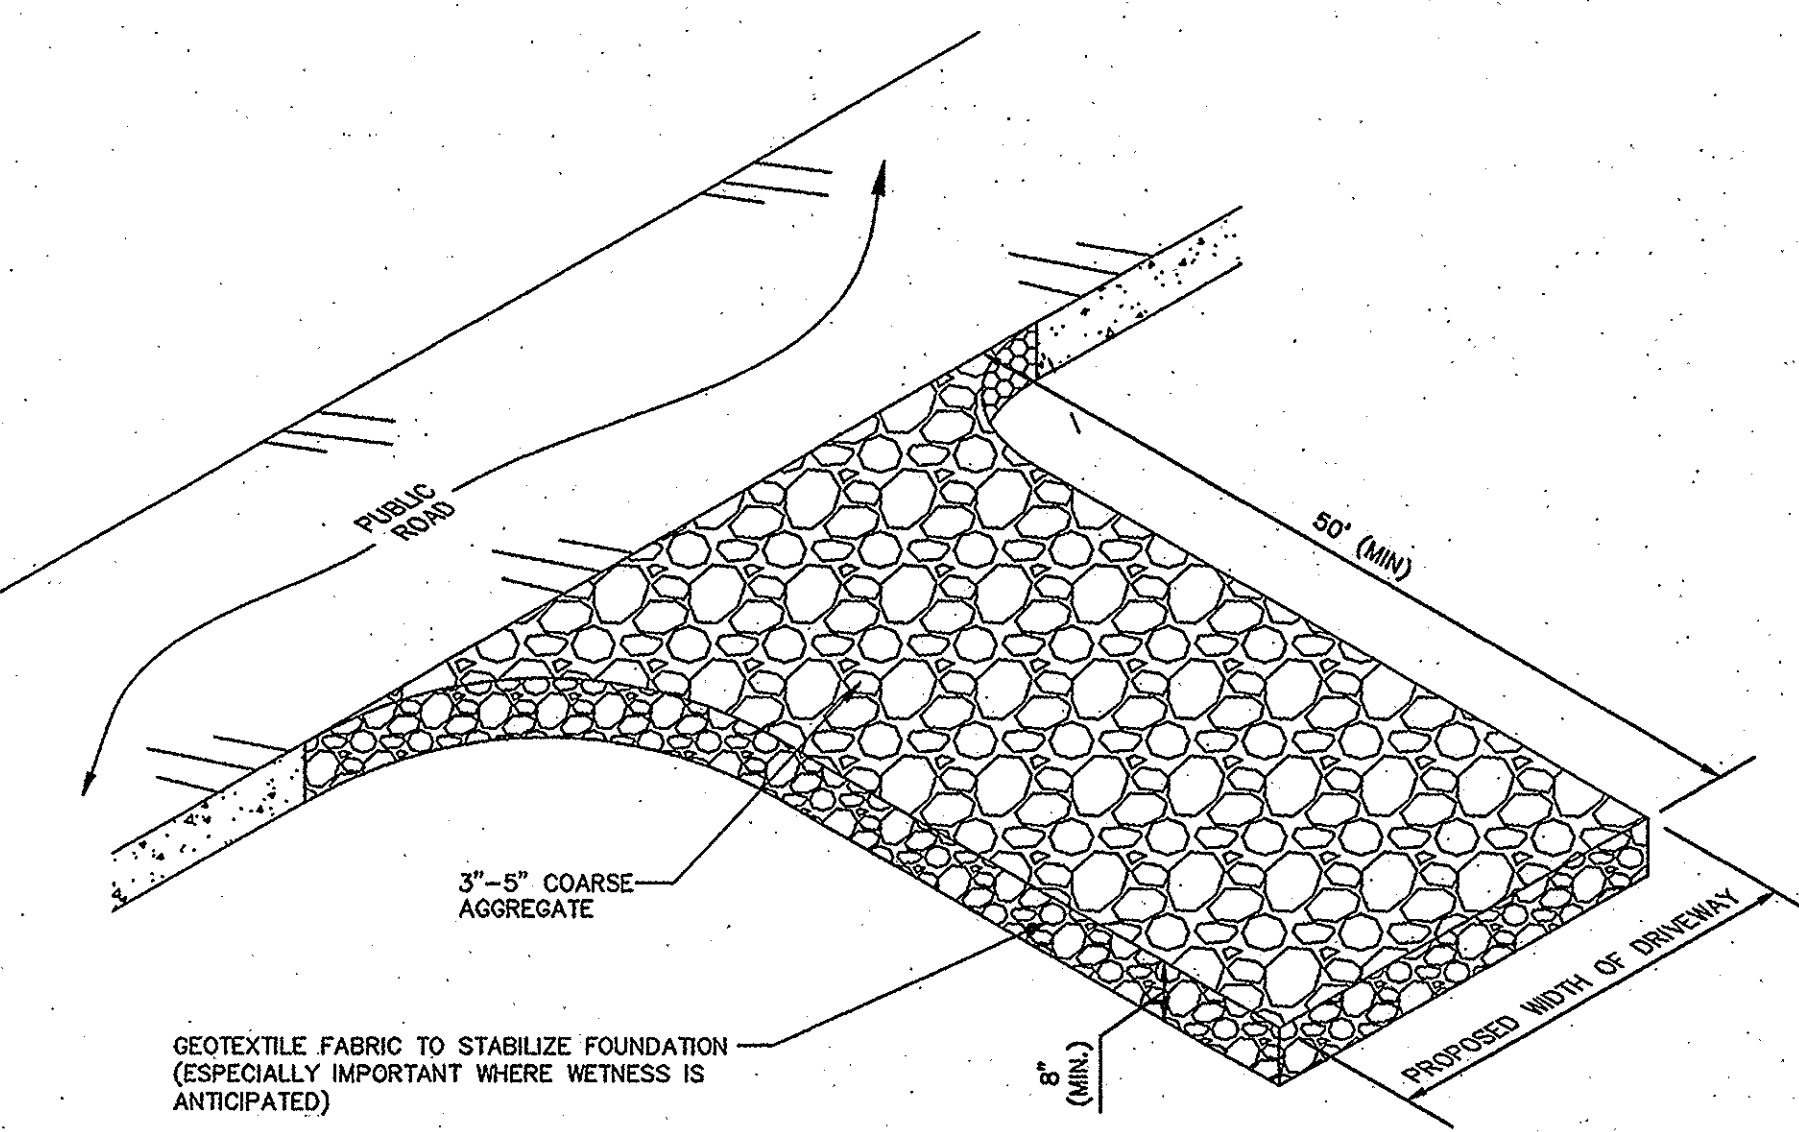

CONSTRUCTION ENTRANCE
N.T.S.

(CE)

GENERAL NOTES

- ALL EROSION CONTROL DEVICES SHALL BE INSTALLED PRIOR TO SITE DISTURBANCE AND SHALL REMAIN IN PLACE UNTIL FINAL GRADING AND PAVING IS COMPLETE AND A STAND OF GRASS IS ESTABLISHED WITH 70% COVERAGE ACHIEVED.
- CONSTRUCTION OPERATIONS SHALL BE MANAGED SO THAT AS MUCH OF THE SITE AS POSSIBLE IS LEFT COVERED WITH TOPSOIL AND VEGETATION.
- ALL AREAS DISTURBED BY CONSTRUCTION OPERATIONS MUST BE SEEDED AND IRRIGATED UNTIL A PERMANENT STAND OF GRASS IS ACHIEVED WITH A MINIMUM OF 70% COVERAGE.
- THE CONTRACTOR SHALL COMPLY WITH ALL FEDERAL, STATE, AND LOCAL EROSION, CONSERVATION, AND SILTATION ORDINANCES. THE CONTRACTOR SHALL REMOVE ALL TEMPORARY EROSION CONTROL DEVICES UPON COMPLETION OF PERMANENT DRAINAGE AND THE ESTABLISHMENT OF A STAND OF GRASS SUFFICIENT TO PREVENT EROSION.
- THE CONTRACTOR MUST USE SEDIMENT FILTERS OR OTHER MEASURES APPROVED BY THE ENGINEER AND CONSTRUCTION MANAGER TO PREVENT SILT AND CONSTRUCTION DEBRIS FROM CLOGGING STORM SEWER PIPES OR PROPOSED OR EXISTING INLETS, OR FROM BEING TRANSPORTED TO ADJACENT PROPERTIES.
- CONSTRUCTION ENTRANCE MINIMUM SIZE STONE: 3\"/>
- PLACE INLET PROTECTION AROUND ALL PROPOSED INLETS DURING CONSTRUCTION.
- SITE ENTRY AND EXIT LOCATIONS SHALL BE MAINTAINED IN A CONDITION WHICH WILL PREVENT TRACKING OR FLOWING OF SEDIMENT ONTO PUBLIC ROADWAYS. ALL SEDIMENT SPILLED, DROPPED, WASHED OR TRACKED ON A PUBLIC ROADWAY MUST BE REMOVED IMMEDIATELY. WHEN WASHING IS REQUIRED TO REMOVE SEDIMENT PRIOR TO ENTRANCE TO A PUBLIC ROADWAY, IT SHALL BE DONE ON AN AREA STABILIZED WITH CRUSHED STONE WHICH DRAINS INTO AN APPROVED SEDIMENT BASIN. ALL FINES IMPOSED FOR TRACKING ONTO PUBLIC ROADS SHALL BE PAID BY THE CONTRACTOR.
- MAINTENANCE: EROSION CONTROLS SHALL BE REPAIRED OR REPLACED AS INSPECTION DEEMS NECESSARY, OR AS DIRECTED BY THE OWNER'S REPRESENTATIVE. ACCUMULATED SILT IN ANY EROSION CONTROL DEVICE SHALL BE REMOVED AND SHALL BE DISTRIBUTED ON SITE IN A MANNER NOT CONTRIBUTING TO ADDITIONAL SILTATION.
- EROSION CONTROL MEASURES MAY ONLY BE PLACED IN FRONT OF INLETS, OR IN CHANNELS, DRAINAGE WAYS OR BORROW DITCHES AT RISK OF CONTRACTOR. CONTRACTOR SHALL REMAIN LIABLE FOR ANY DAMAGE CAUSED BY THE MEASURES, INCLUDING FLOODING DAMAGE WHICH MAY OCCUR DUE TO BLOCKED DRAINAGE. AT THE CONCLUSION OF ANY PROJECT, ALL CHANNELS, DRAINAGE WAYS AND BORROW DITCHES IN THE WORK ZONE SHALL BE DREDGED OF ANY SEDIMENT GENERATED BY THE PROJECT OR DEPOSITED AS A RESULT OF EROSION CONTROL MEASURES.
- THE CONTRACTOR IS RESPONSIBLE FOR REESTABLISHING ANY EROSION CONTROL DEVICE WHICH THEY DISTURB. EACH CONTRACTOR SHALL NOTIFY THE OWNER'S REPRESENTATIVE OF ANY DEFICIENCIES IN THE ESTABLISHED EROSION CONTROL MEASURES WHICH MAY LEAD TO UNAUTHORIZED DISCHARGE OR STORM WATER POLLUTION, SEDIMENTATION OR OTHER POLLUTANTS. UNAUTHORIZED POLLUTANTS INCLUDE, BUT ARE NOT LIMITED TO, EXCESS CONCRETE DUMPING OR CONCRETE RESIDUE, PAINTS, SOLVENTS, GREASES, FUEL AND LUBE OIL, PESTICIDES, AND SOLID WASTE MATERIALS.
- THE CONTRACTOR SHALL MAINTAIN ADEQUATE SITE DRAINAGE DURING ALL PHASES OF CONSTRUCTION. THE CONTRACTOR SHALL USE FILTER BARRIER (OR OTHER METHOD APPROVED BY THE ENGINEER AND TOWN OF ADDISON) AS REQUIRED TO PREVENT SILT AND CONSTRUCTION DEBRIS FROM FLOWING ONTO ADJACENT PROPERTIES. CONTRACTOR SHALL COMPLY WITH ALL APPLICABLE FEDERAL, STATE, OR LOCAL EROSION, CONSERVATION, AND SILTATION ORDINANCES. CONTRACTOR SHALL REMOVE ALL TEMPORARY EROSION CONTROL DEVICES UPON COMPLETION OF PERMANENT DRAINAGE FACILITIES AND THE ESTABLISHMENT OF A STAND OF GRASS OR OTHER GROWTH TO PREVENT EROSION.
- CONTRACTOR IS RESPONSIBLE FOR REMOVING ALL SILT AND DEBRIS OFF SITE FROM THE EXISTING ROADWAYS AND PROJECT SITE THAT ARE A RESULT OF THE PROPOSED CONSTRUCTION AS REQUESTED BY THE TOWN OF ADDISON.
- CONTRACTOR SHALL CONSTRUCT A STABILIZED CONSTRUCTION ENTRANCE AT ALL PRIMARY POINTS OF ACCESS. CONTRACTOR IS RESPONSIBLE FOR INSURING THAT ALL CONSTRUCTION TRAFFIC UTILIZES THE STABILIZED ENTRANCE AT ALL TIMES FOR INGRESS/EGRESS TO THE SITE.
- THE CONTRACTOR SHALL TAKE ALL AVAILABLE PRECAUTIONS TO CONTROL DUST. CONTRACTOR SHALL CONTROL DUST BY SPRINKLING WATER, OR BY OTHER MEANS APPROVED BY THE CITY AND ENGINEER, AT NO ADDITIONAL COST TO THE OWNER.
- BEFORE ANY EARTHWORK IS DONE, THE CONTRACTOR SHALL STAKE OUT AND MARK THE LIMITS OF CONSTRUCTION AND OTHER ITEMS ESTABLISHED BY THE PLANS. THE CONTRACTOR SHALL PROTECT AND PRESERVE CONTROL POINTS AT ALL TIMES DURING THE COURSE OF THE PROJECT. THE GRADING CONTRACTOR SHALL PROVIDE ALL NECESSARY ENGINEERING AND SURVEYING FOR LINE AND GRADE CONTROL POINTS RELATED TO EARTHWORK.
- THE CONTRACTOR SHALL SALVAGE AND PROTECT ALL EXISTING POWER POLES, SIGNS, MANHOLES, TELEPHONE RISERS, WATER VALVES, ETC. DURING ALL CONSTRUCTION PHASES UNLESS NOTED OTHERWISE.
- CONTRACTOR STAGING AREA TO BE AGREED UPON BY OWNER PRIOR TO CONSTRUCTION.

RECORD DRAWINGS
(July 2013)
INFORMATION PROVIDED BY:
Rogers-O'Brien Construction Company

Kimley-Horn and Associates, Inc.
 Tel. No. (972) 335-3780
 Fax No. (972) 335-3776
 5700 General Court, Suite 200
 Dallas, Texas 75240
 Firm No. F-828
 LICENSED PROFESSIONAL ENGINEER
 DAVID K. KOCHALKA
 87781
 6/19/12

METHODIST PAVILION ONE
TOWN OF ADDISON, DALLAS COUNTY, TEXAS

EROSION CONTROL DETAILS

Scale: AS SHOWN
 Designed by: DRK
 Drawn by: DRK
 Checked by: DRK
 Date: 06/12/2013
 Project No. 6506200

SHEET
C-12

DRAWINGS
 PREPARED BY
 MILLIKEN, LTD. 67201215MFM
 DATE: 06/12/2013
 LARS SAUNDERS
 20130612