#### TRAFFIC SIGNAL INSTALLATION

All specifications and special provisions applicable to this project are identified as follows:

#### **STANDARD SPECIFICATIONS:**

Adopted by the Texas Department of Transportation June 1, 2004, Standard specifications are incorporated into the contract by reference.

Drilled Shaft Foundations (421)(427)(440)(448)

Conduit (400)(445)(476)(622) Electrical Conductors (610)(628)

Ground Boxes (421) (440) Item 636 Aluminum Signs Item 680

Installation of Highway Traffic Signals (610)(625)(627)(634)(636)(656) Item 682 Vehicle and Pedestrian Signal Heads Traffic Signal Cables Item 686 Traffic Signal Pole Assemblies (Steel) (421)(441)(442)(445)(449)

Pedestrian Detectors and Vehicle Loop Detectors (618)(624)(682)(684)

Pedestal Pole Assemblies (445)(449)(656)

**SPECIAL PROVISIONS:** 

Special provisions will govern and take precedence over the specifications enumerated hereon wherever in conflict therewith.

Special Provision to Item 400 (400---004) Special Provision to Item 421 (421---035) Special Provision to Item 440 (440---002) Special Provision to Item 441 (441---002) Special Provision to Item 442 (442---005) Special Provision to Item 506 (506---010) Special Provision to Item 620 (620--001)

#### <u>Item 416:</u>

Item 687

Item 688

Provide a formed smooth finish for all portions of drill shafts extending above proposed ground. Include cost for this work in the unit bid price for this item.

Traffic signal pole foundations will be paid for once regardless of extra work caused by obstructions.

Install a 5/8"x10' copper clad ground rod in each traffic signal pole foundation. The ground rod for each foundation will protrude above the finish grade of the foundation a minimum of 1" and a maximum of 2".

Concrete removal required for installation of drilled shafts will be subsidiary to Item 416.

General Notes

Sheet A

Provide signal head attachments that allow for adjustment about the horizontal and vertical

Turn down signal heads or cover with burlap or other material, as approved, until traffic signal is placed in operation.

Mount signal heads level and plumb and aimed as directed. Match existing signal head section color (black).

# <u>Item 684:</u>

Provide stranded 14 AWG Type A signal cables.

Provide a separate multi-conductor signal cable (14 AWG) inside pedestal poles and signal poles from the terminal strip to each signal head as shown on the plans.

Identify each cable as shown on the plans (cable 1, etc.) with permanent marking labels (Panduit Type PLM standard single marker tie, Thomas&Betts Type 548M, or equal) at each ground box, pole base, and controller.

# <u>Item 686:</u>

Provide 12 circuit Buchanan Type 112SN, Kulka Type 985-GP-12 CU, or equal terminal strips in the signal pole access compartment. Provide additional terminal strips of 8 circuits each when more than 12 circuits are required. The conductors for the Line and Load side of the terminal strip shall be identified with a plastic label with two straps per tag. The line side shall have each signal head, PED head, and push button identified on the tag.

Mark pole shafts and mast arms with the identification numbers from the plans to facilitate field-assembly. Identify pole shafts and mast arms by intersection for projects with multiple

Provide nuts on top and bottom (double nuts) of the base plate as shown on the plans.

Set anchor bolts for mast arm signal poles and strain poles so that two are in tension and two are in compression. Obtain approval of anchor bolt placement before placing concrete.

Use the traffic signal pole heights and mast arm lengths shown on the plans and in the material summary for bidding purposes only. Make field measurements to determine the actual pole height and mast arm length required. Provide vertical clearance of 17 to 19 feet from the roadway to the lowest point of the signal head or mast arm. Place signal heads 40 feet minimum and 180 feet maximum from the stop line. If the nearest signal is more than 180 feet from the stop line, place a supplemental near-side signal head. Determine the field measurements and elevations from the actual field location of the poles, considering all above and below ground utilities and existing roadway elevations.

Provide vibration dampers for mast arms 28 feet to 48 feet in length. Install as shown on MA-DPD-12.

For existing signal poles, replacement of existing conductors is not required inside the poles. Plug any unused openings in existing mast arms and poles with an approved material.

### <u>Item 618:</u>

The location of conduits and ground boxes are diagrammatic only and may be shifted to accommodate field conditions as directed.

Secure permission and approval from the proper authority prior to cutting into or removing any sidewalks or curbs for installation of this Item.

When holes are drilled through concrete structures, use a coring device. Do not use masonry or concrete drills.

Place conduit under existing pavement by an approved boring method. Do not place boring pits closer than 2 feet from the edge of the pavement unless otherwise directed. Do not use water jetting. When conduits are bored, do not exceed 18 inches in the vertical and horizontal tolerances as measured from the intended target point.

Do not use a pneumatically driven device for punching holes beneath the pavement (commonly known as a "missile").

Furnish and install a non-metallic pull rope in conduit runs in excess of 50 feet.

Use a colored cleaner-primer on all PVC to PVC joints before application of PVC cement.

Seal all conduit ends with a permanently soft, non-toxic duct seal. Use a duct seal that does not adversely affect other plastic materials or corrode metals.

Furnish and install non-metallic pull ropes in conduit installed for future use and cap using standard weather-tight conduit caps, as approved. This work will not be paid for directly, but is subsidiary to this Item.

When using existing conduit, ensure that all conduits have bushings and are cleaned of mud and debris. Re-strap conduit that is being relocated to new timber poles as if it were a new installation. This work will not be paid for directly, but is subsidiary to this Item.

#### <u>Item 620:</u>

The equipment grounding conductor shall be identified by a continuous green colored jacket insulation or bare wire. Grounded conductors (Neutral) shall be identified by a continuous white colored jacket. Ungrounded conductors (Hot) in a 120/240v or 240/480v system shall be identified by each pole or leg. For 240-volt branch circuit fed from 120/240 source and 480-volt branch circuit fed from 240/480 source, ensure one leg is identified by a continuous black colored jacket and the other leg by a continuous red colored jacket.

For Ped poles (Item 687) within the project, provide single-pole breakaway disconnects. Use Bussman HEBW, Littlefuse LEB, Ferraz-Shawmut FEB, or equal on ungrounded conductors. For all grounded conductors use Bussman HET, Littlefuse LET, Ferraz-Shawmut FEBN, or equal. These breakaway connectors have a white colored marking and a permanently installed solid neutral.

### <u>Item 624:</u>

Ground all junction boxes mounted on bridges and underpasses with a ground rod.

General Notes

Sheet B

Provide 3 pipe plugs for wiring access on strain poles.

Provide a three piece bracket assembly on strain poles or drill the pole and use thimble eye bolts to attach the strain vise for the span wire.

Per Town of Addison, signal pole and mast arms to be powder coated black.

## <u>Item 688:</u>

Maintain a minimum 12 inch separation between loop lead-in sawcuts and loop sawcuts, and a minimum 6 inch separation between loop lead-in sawcuts and other loop lead-in sawcuts.

Use loop wire for concrete pavement and loop duct for asphalt pavements.

Install loop detectors only during off-peak traffic periods.

Provide pedestrian push button assemblies that have permanent-type signs within the detector unit which indicates which crosswalk signal is actuated. Provide push buttons with a minimum 2 inch convex plunger. Provide a protective shroud encircling the plunger to detervandalism that is cast as part of the housing cover. Use a plunger that protrudes beyond the shroud a distance adequate to accommodate the switch travel.

Verify the location of the push button assemblies and the direction of the arrows on the signs prior to installation.

Assist the Engineer in determining the loop inductance of each loop detector installation. In the presence of the engineer, conduct field testing to determine the total inductance of the loop detector and the percentage shift in loop inductance for various size vehicles.

All new pedestrian signal heads to be countdown.

Slack conductors required by Standard Sheet ED(2)-03 will be subsidiary to Item 624.

Concrete removal required for installation of ground boxes will be subsidiary to Item 624.

#### <u>ltem 656:</u>

Form a 3/4-inch chamfer on the top edge of each signal pole foundation.

Probe for utilities and underground structures prior to drilling foundations. Foundations shall be paid for once regardless of extra work caused by obstructions.

#### <u>Item 680:</u>

Requirements for this Item include the following work, all of which are subsidiary to this Item:

- 1. Notify the Town of Addison one week before beginning any work involving traffic signals.
- 2. Provide submittal literature for all traffic signal equipment before installation. 3. Provide detector cards that have a Liquid Crystal Display (LCD) of all operational and diagnostic information. The LCD shall show all major parameters of the loop operation including loop frequency, loop inductance, inductance change, and loop faults. Loop faults include open circuit, short circuit, and inductance change. Provide a user's manual with full operating instructions and the contact name, address, and telephone number for the representative, manufacturer, or distributor for warranty repair.

4. Connect all field wiring to the controller assembly

5. Furnish and install all sign panels for mounting on signal poles and mast arms. Fabricate the sign panels in accordance with Item 636, and mount with Astro-Sign Brac, Signfix aluminum channel, or equal as approved by the Engineer.

6. Furnish and install all other signs in accordance to Item 636. Furnish all mounting hardware for all signs. Mount signs with Astro-Sign Brac, Signfix aluminum channel, or equal as approved by the Engineer.

7. Install the emergency vehicle preemption equipment.

8. Have a qualified technician on the project site to place the traffic signal in operation. 9. Use qualified personnel to respond to and diagnose all trouble calls during the thirty-day test period. Repair any malfunction to Contractor-supplied signal equipment. Provide to the Engineer a local telephone number, not subject to frequent changes and available on a 24-hour basis, for reporting trouble calls. Response time to reported calls must be less than 2 hours. Make appropriate repairs within 24 hours. Place a logbook in the controller cabinet and keep a record of each trouble call reported. Notify the Engineer of each trouble call. Do not clear the error log in the conflict monitor or MMU during the thirty-day test period without approval.


10. Prevent any damage to property owner's poles, fences, shrubs, etc. Protect all underground and overhead utilities and repair any damage. Provide access to all driveways during construction.

### <u>Item 682:</u>


Install signal head attachments so that the wiring to each signal head passes from the mast arm through the attachment hardware to the signal head. Do not leave cable or wiring exposed.

**General Notes** 

Sheet C

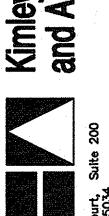



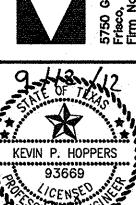

S OF

> NOTE 0 0

SHEET

**TS-03** 

INFORMATION PROVIDED BY: Rogers-O'Brien Construction Company

RECORD DRAWINGS

(July 2013)

General Notes

Sheet D

General Notes

Sheet E