

KEYED NOTES


- 1 PROPOSED 5.0 FOOT STORM STRUCTURE. SEE DETAIL C4.1-02. SEE SHEET C10 FOR EROSION CONTROL DURING CONSTRUCTION.
- 2 PROPOSED 10.0 FOOT STORM STRUCTURE. SEE DETAIL C4.1-02. SEE SHEET C10 FOR EROSION CONTROL DURING CONSTRUCTION.
- 3 PROPOSED 7.5 FOOT STORM STRUCTURE. SEE DETAIL C4.1-02. SEE SHEET C10 FOR EROSION CONTROL DURING CONSTRUCTION.
- 4 6" P.V.C. STORM LINE FROM DOWNSPOUTS. RUN LINE THROUGH CURB. SEE DETAIL MEPT-04. SEE SHEET A2.2 FOR EXACT LOCATION.
- 5 CONCRETE COLLAR. SEE DETAIL C4.1-05. TIE-IN ELEV = 630.26
- 6 CONCRETE COLLAR. SEE DETAIL C4.1-05. TIE-IN ELEV = 629.66
- 7 CONCRETE COLLAR. SEE DETAIL C4.1-05. TIE-IN ELEV = 622.00

STORM STRUCTURE SCHEDULE


- 1 PRECAST JUNCTION BOX
RM = 637.25
60" INVERT IN (SW) = 627.70
66" INVERT IN (W) = 628.54
72" INVERT OUT (S) = 626.59
- 2 PRECAST BEND MANHOLE ASSEMBLY
RM = 631.55
72" INVERT IN (N) = 623.75
72" INVERT IN (S) = 623.65
- 3 PROPOSED CURB INLET
TOP = 631.74
THROAT = 630.24
36" INVERT OUT (W) = 625.97
24" INVERT OUT (NW) = 626.97
24" INVERT IN (E) = 626.07
- 4 PROPOSED CURB INLET
TOP = 633.66
THROAT = 633.18
66" INVERT OUT (E) = 628.68
24" INVERT OUT (S) = 628.66
- 5 PROPOSED CURB INLET
TOP = 631.48
THROAT = 630.88
18" INVERT OUT (N) = 627.48
- 6 PROPOSED CURB INLET
TOP = 631.10
THROAT = 630.60
18" INVERT IN (S) = 626.32
24" INVERT OUT (SW) = 626.22

PIPE SCHEDULE

- A 32" LINEAR FEET OF 60" RCP AT 8.00% SLOPE
- B 14" LINEAR FEET OF 66" RCP AT 8.00% SLOPE
- C 284" LINEAR FEET OF 72" RCP AT 1.00% SLOPE
- D 68" LINEAR FEET OF 72" RCP AT 2.42% SLOPE
- E 20" LINEAR FEET OF 24" HDPE AT 7.28% SLOPE (OVERFLOW PIPE)
- F 11" LINEAR FEET OF 36" HDPE AT 0.50% SLOPE
- G 100" LINEAR FEET OF 36" HDPE AT 0.50% SLOPE
- H 100" LINEAR FEET OF 36" HDPE AT 0.50% SLOPE
- I 100" LINEAR FEET OF 36" HDPE AT 0.50% SLOPE
- J 12" LINEAR FEET OF 12" HDPE AT 0.27% SLOPE (OVERFLOW PIPE)
- K 10" LINEAR FEET OF 24" HDPE AT 0.70% SLOPE (OVERFLOW PIPE)
- L 170" LINEAR FEET OF 24" HDPE AT 1.00% SLOPE
- M 170" LINEAR FEET OF 24" HDPE AT 1.00% SLOPE
- N 170" LINEAR FEET OF 24" HDPE AT 1.00% SLOPE
- O 9" LINEAR FEET OF 12" HDPE AT 0.27% SLOPE
- P 36" HDPE PIPE MANIFOLD (SIZED FOR 4 - 36" PIPES)
- Q 36" HDPE PIPE MANIFOLD (SIZED FOR 4 - 36" PIPES & 1 - 12" PIPE)
- R 24" HDPE PIPE MANIFOLD (SIZED FOR 3 - 24" PIPES & 1 - 12" PIPE)
- S 63" LINEAR FEET OF 18" RCP AT 1.92% SLOPE
- T 20" LINEAR FEET OF 24" RCP AT 1.00% SLOPE
- U 100" LINEAR FEET OF 12" HDPE AT 0.50% SLOPE
- V 10" LINEAR FEET OF 24" HDPE AT 0.70% SLOPE (OVERFLOW PIPE)
- W 170" LINEAR FEET OF 24" HDPE AT 1.00% SLOPE

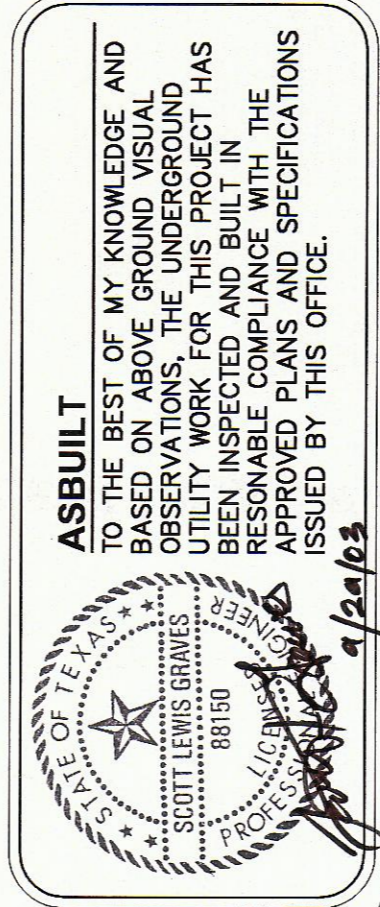

VERT. SCALE: 1" = 4'
HORIZ. SCALE: 1" = 20'

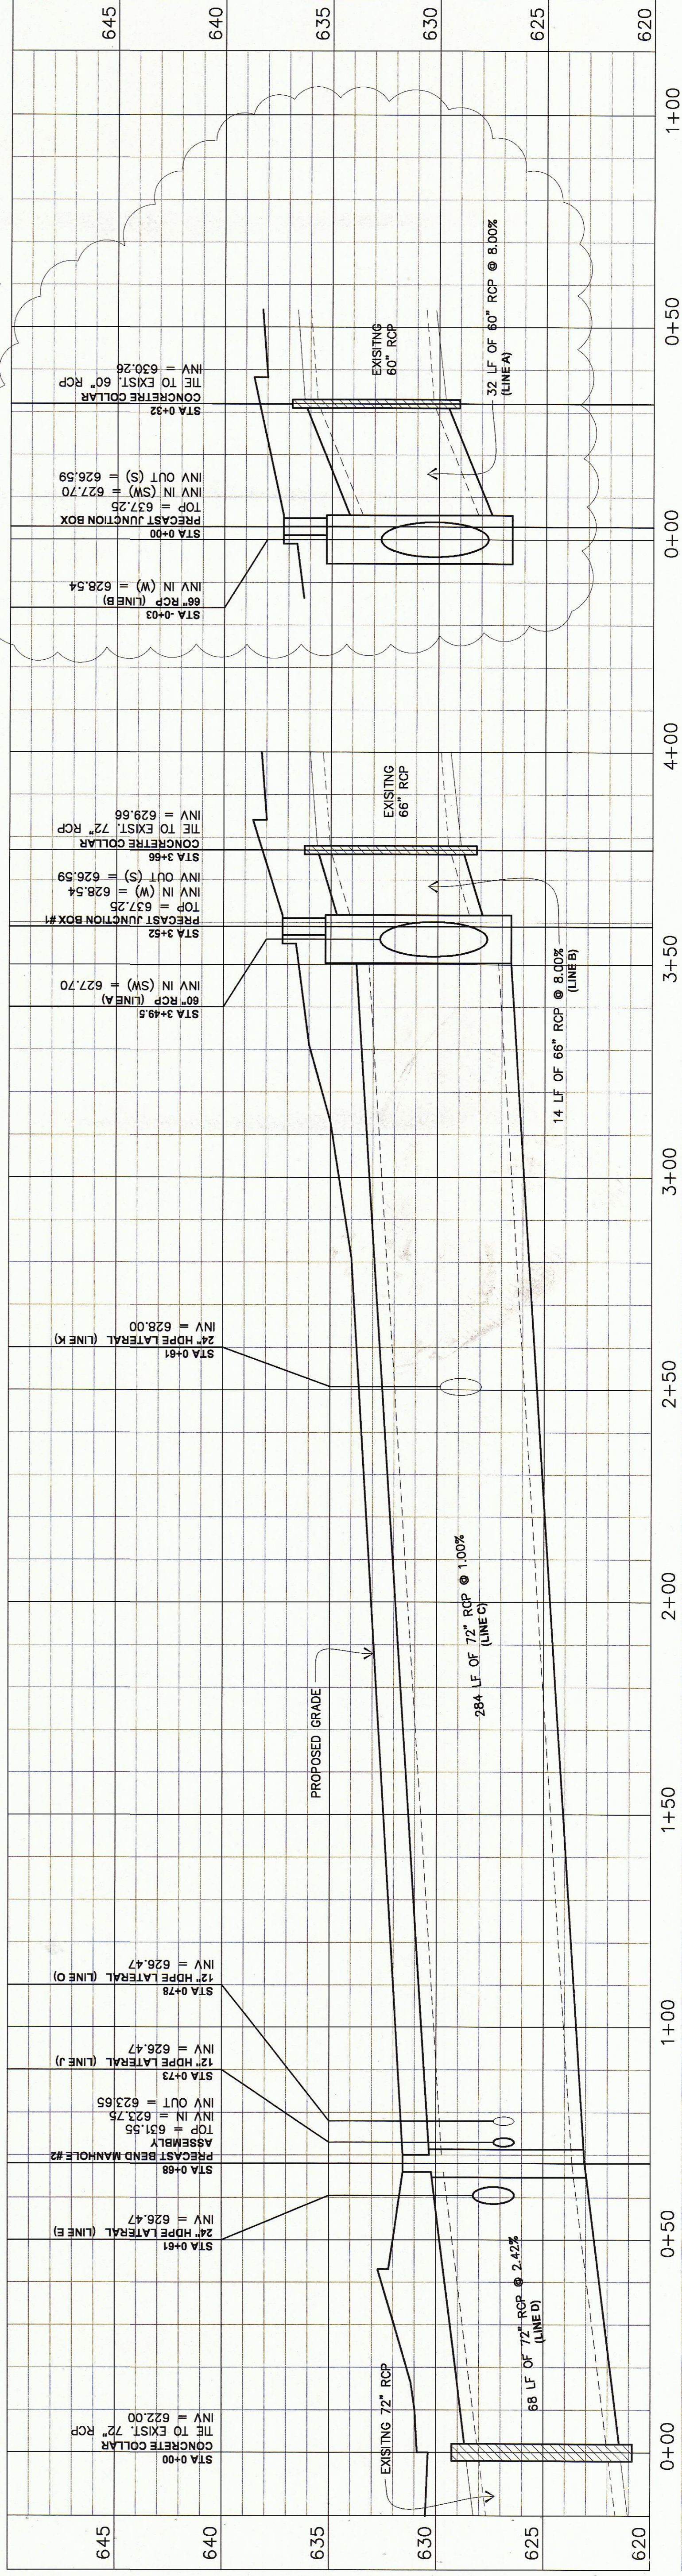

STORM PLAN AND PROFILE

- REVISIONS**
- 1 12/19/02 (CH)
 - 3 09/14/03
 - 5 (Dallas Comments)
 - 8 09/26/03 (As Built)

PROTOTYPE
DALLAS FILE NO.
311T-7045
WD-PROJECT NUMBER
0006.659-00

C3.1



2350 Valley View Lane
Suite 100
Dallas, Texas 75234-6734
T 214.551.5400
F 214.551.5400
info@wu-partners.com
wupartners.com

Dallas
Columbus
Los Angeles
Chicago
Miami

exposite.com

