

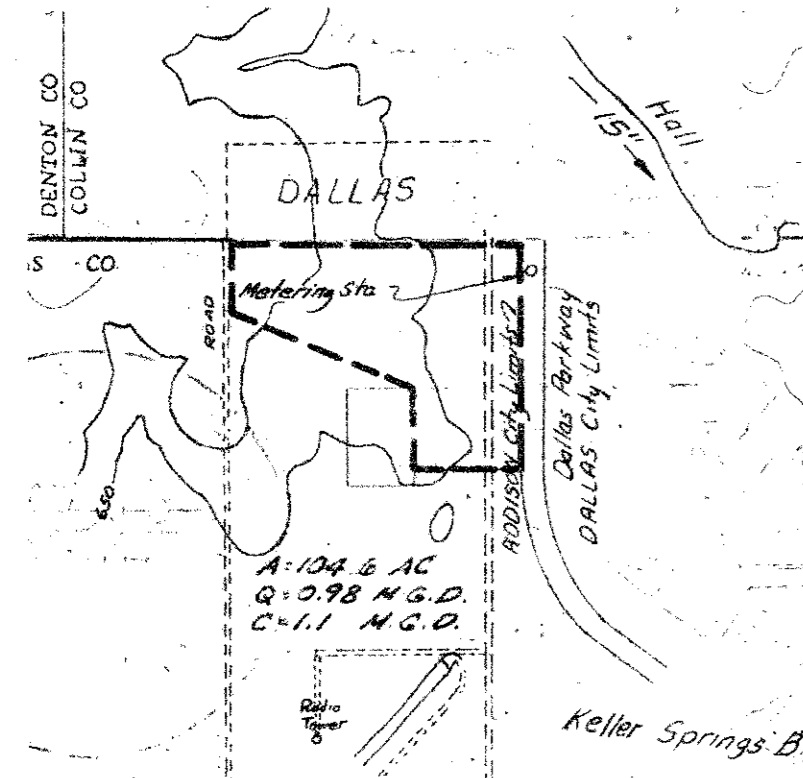



COLLIN COUNTY
DALLAS COUNTY

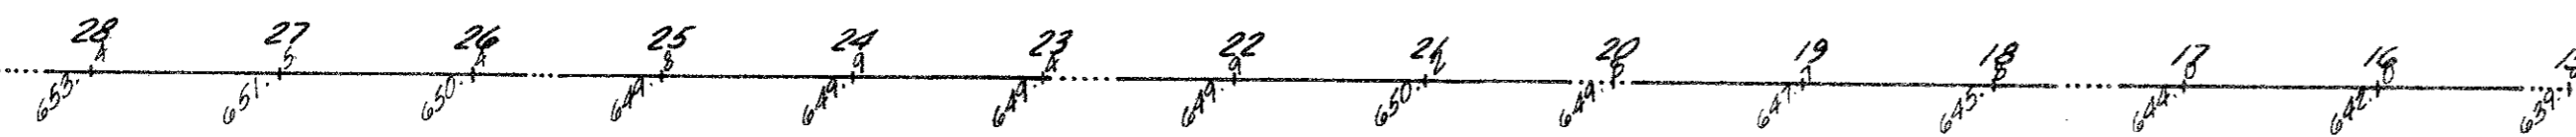

DRAINAGE AREA MAP

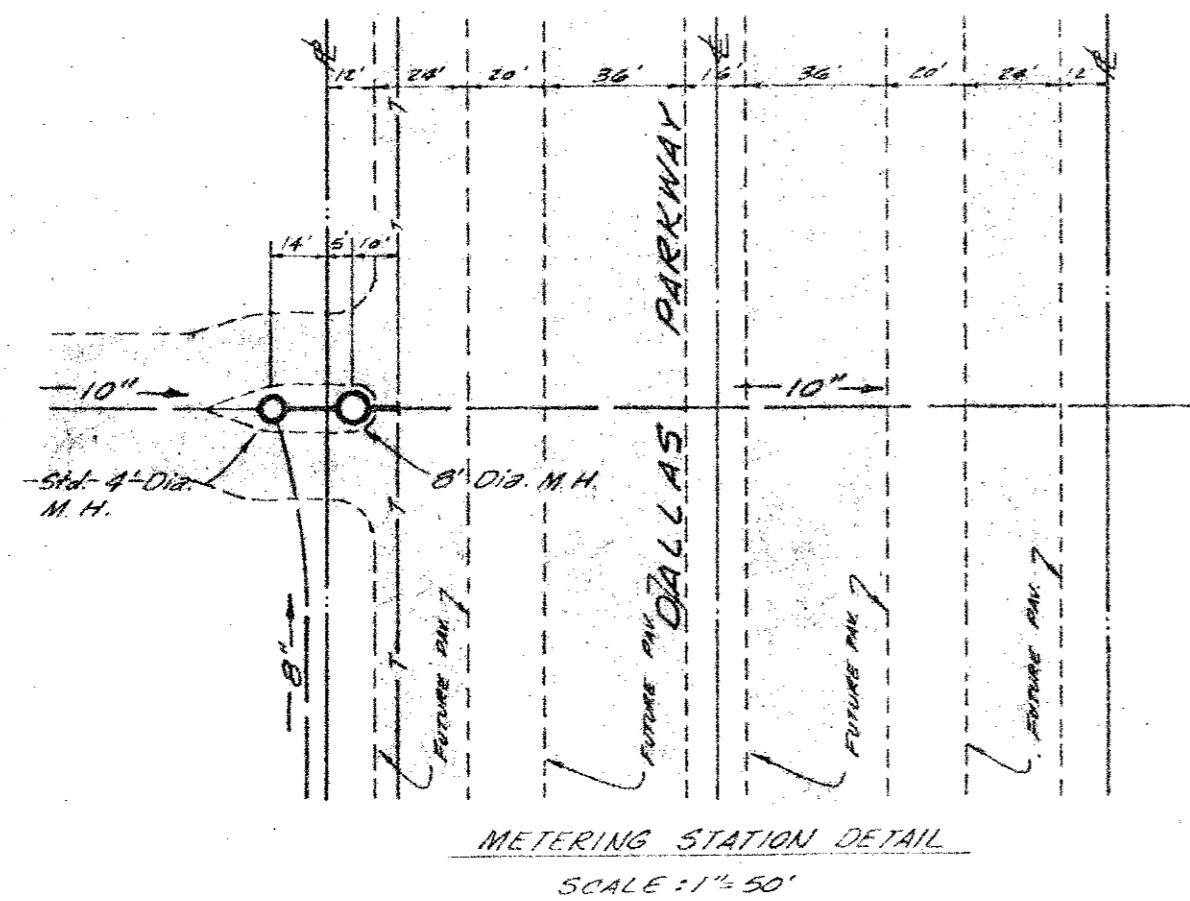

METERING STATION DETAIL
SCALE: 1" = 50'

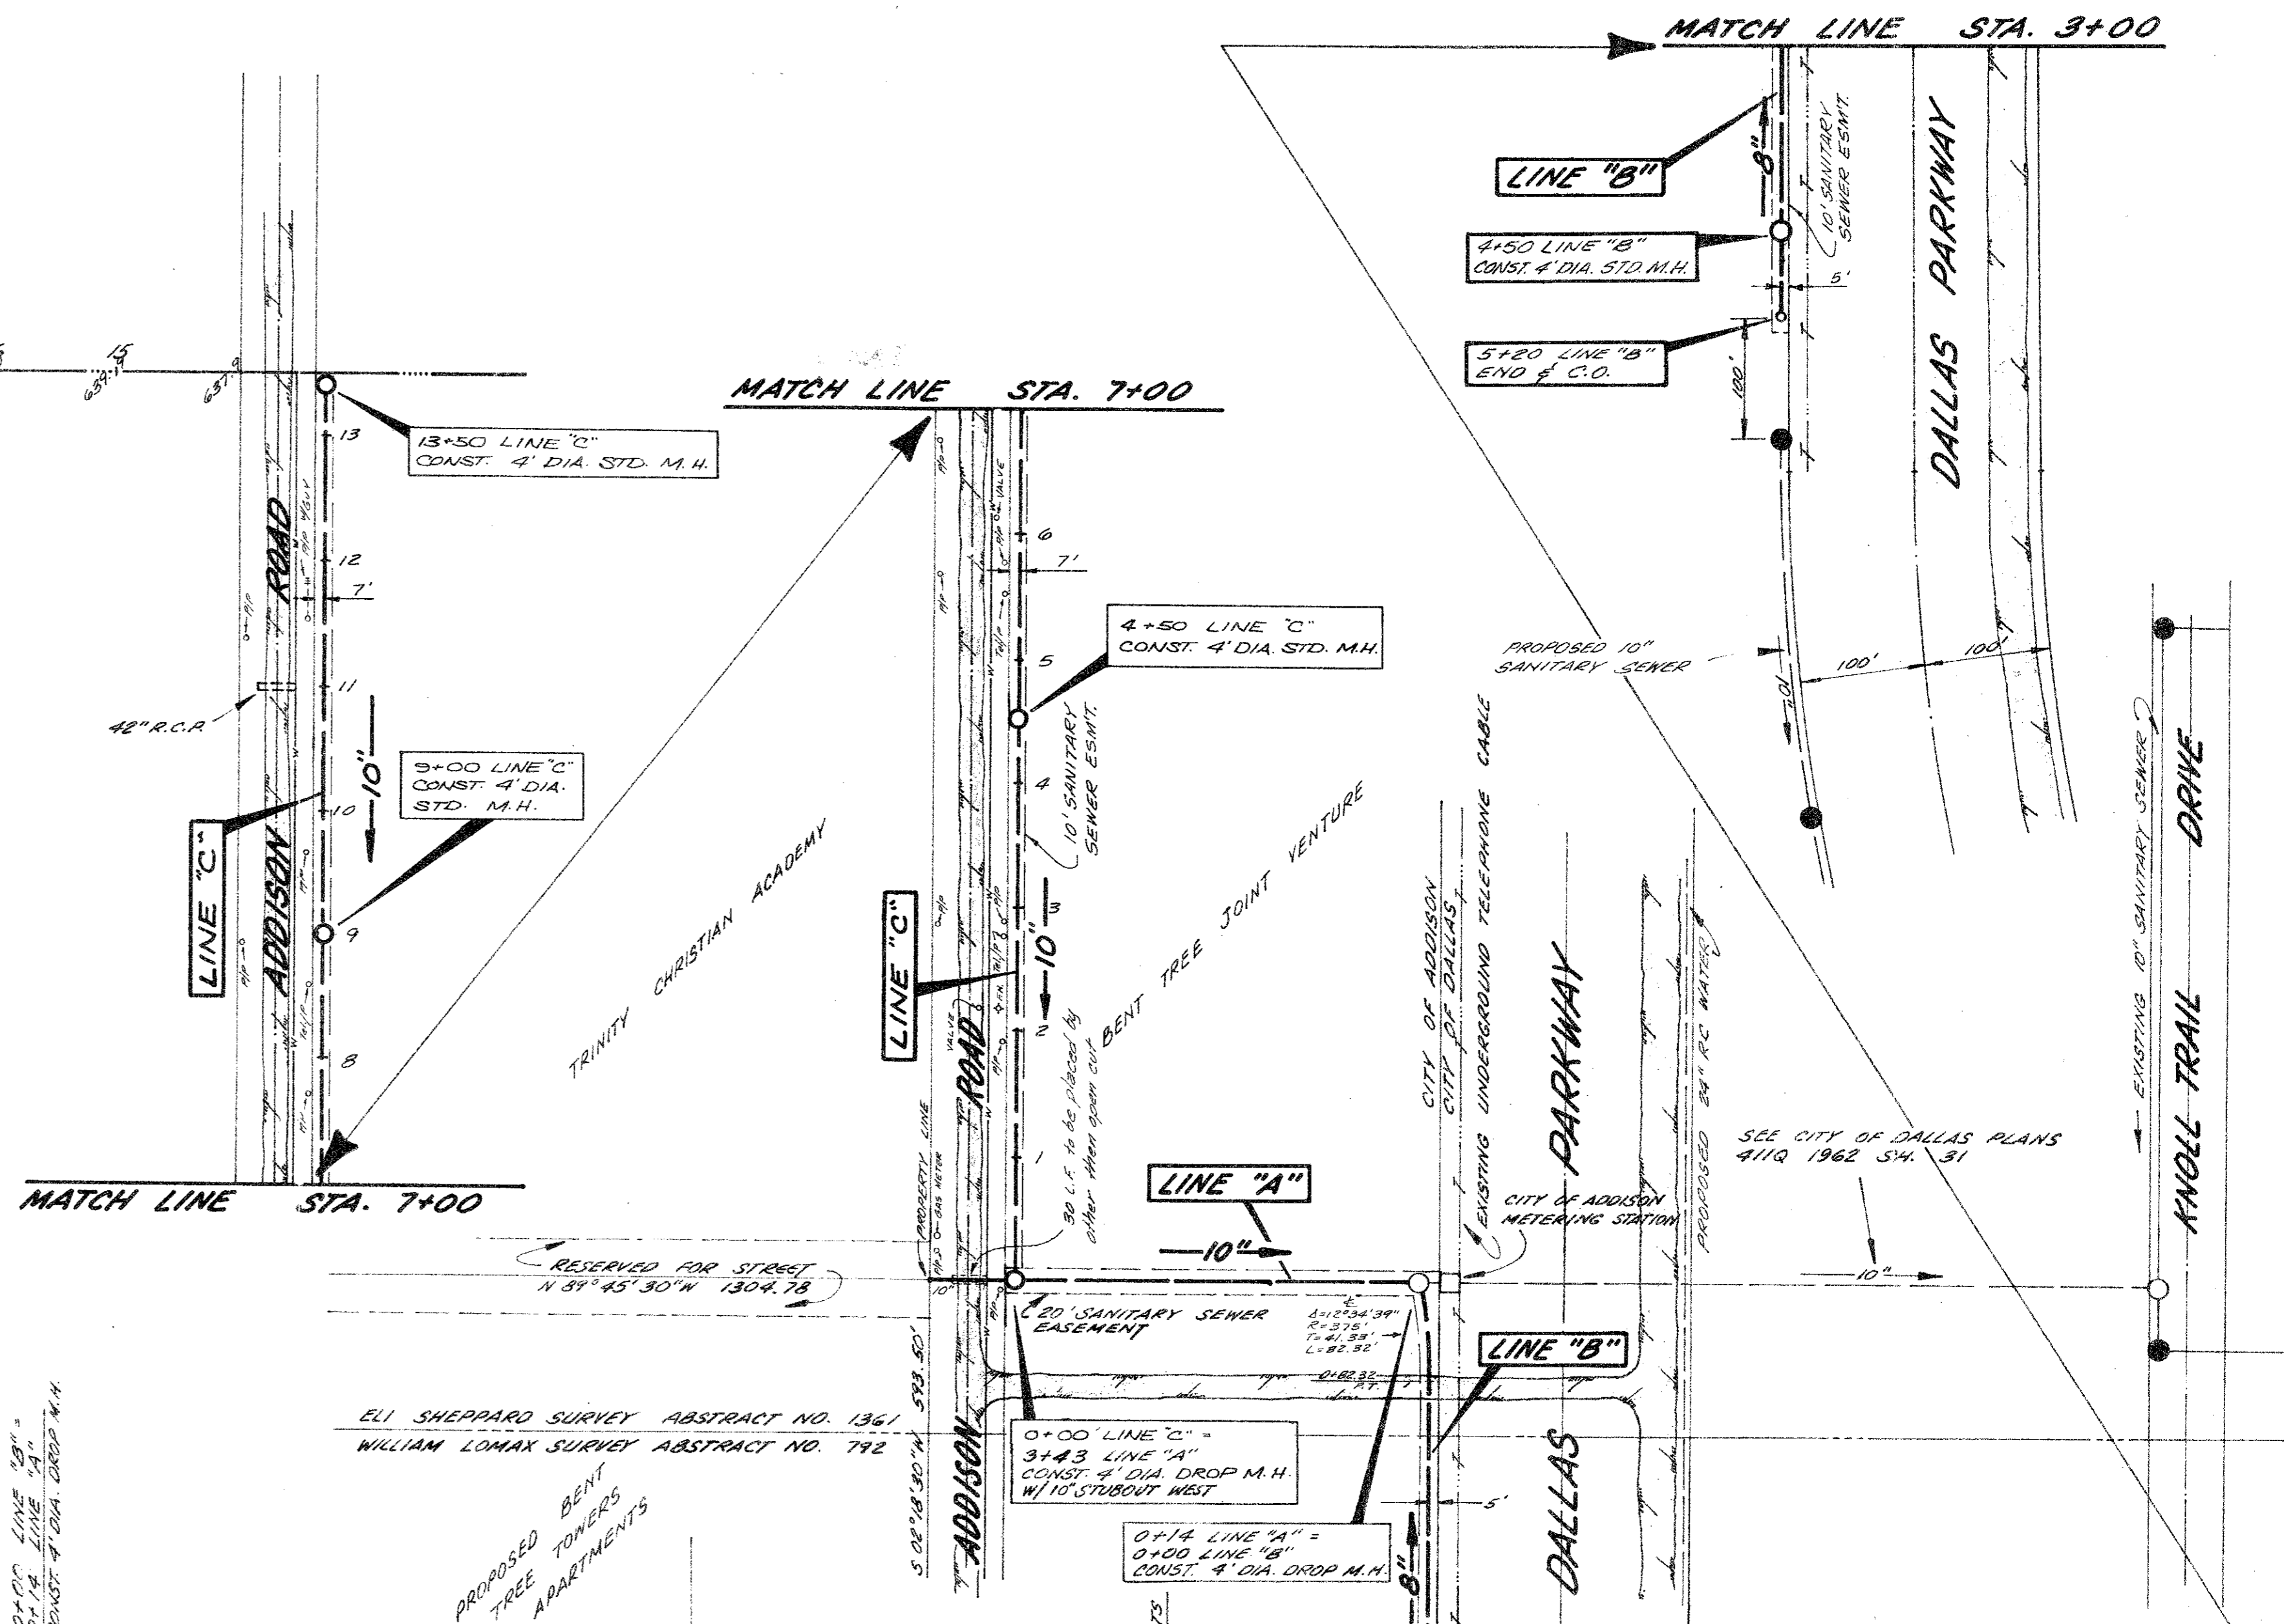


BENCH MARK

R.R. SPINE IN POWER POLE POINT OF STA. 0+00 (DALLAS PARKWAY PLANS) AT THE INTERSECTION OF HASTINGS DRIVE AND DALLAS PARKWAY DRIVE AND DALLAS PARKWAY DRIVE. ELEV. 617.84


NOTE:

IT WILL BE THE CONTRACTOR'S RESPONSIBILITY TO VERIFY THE LOCATION AND TO PROTECT ALL EXISTING UTILITIES.

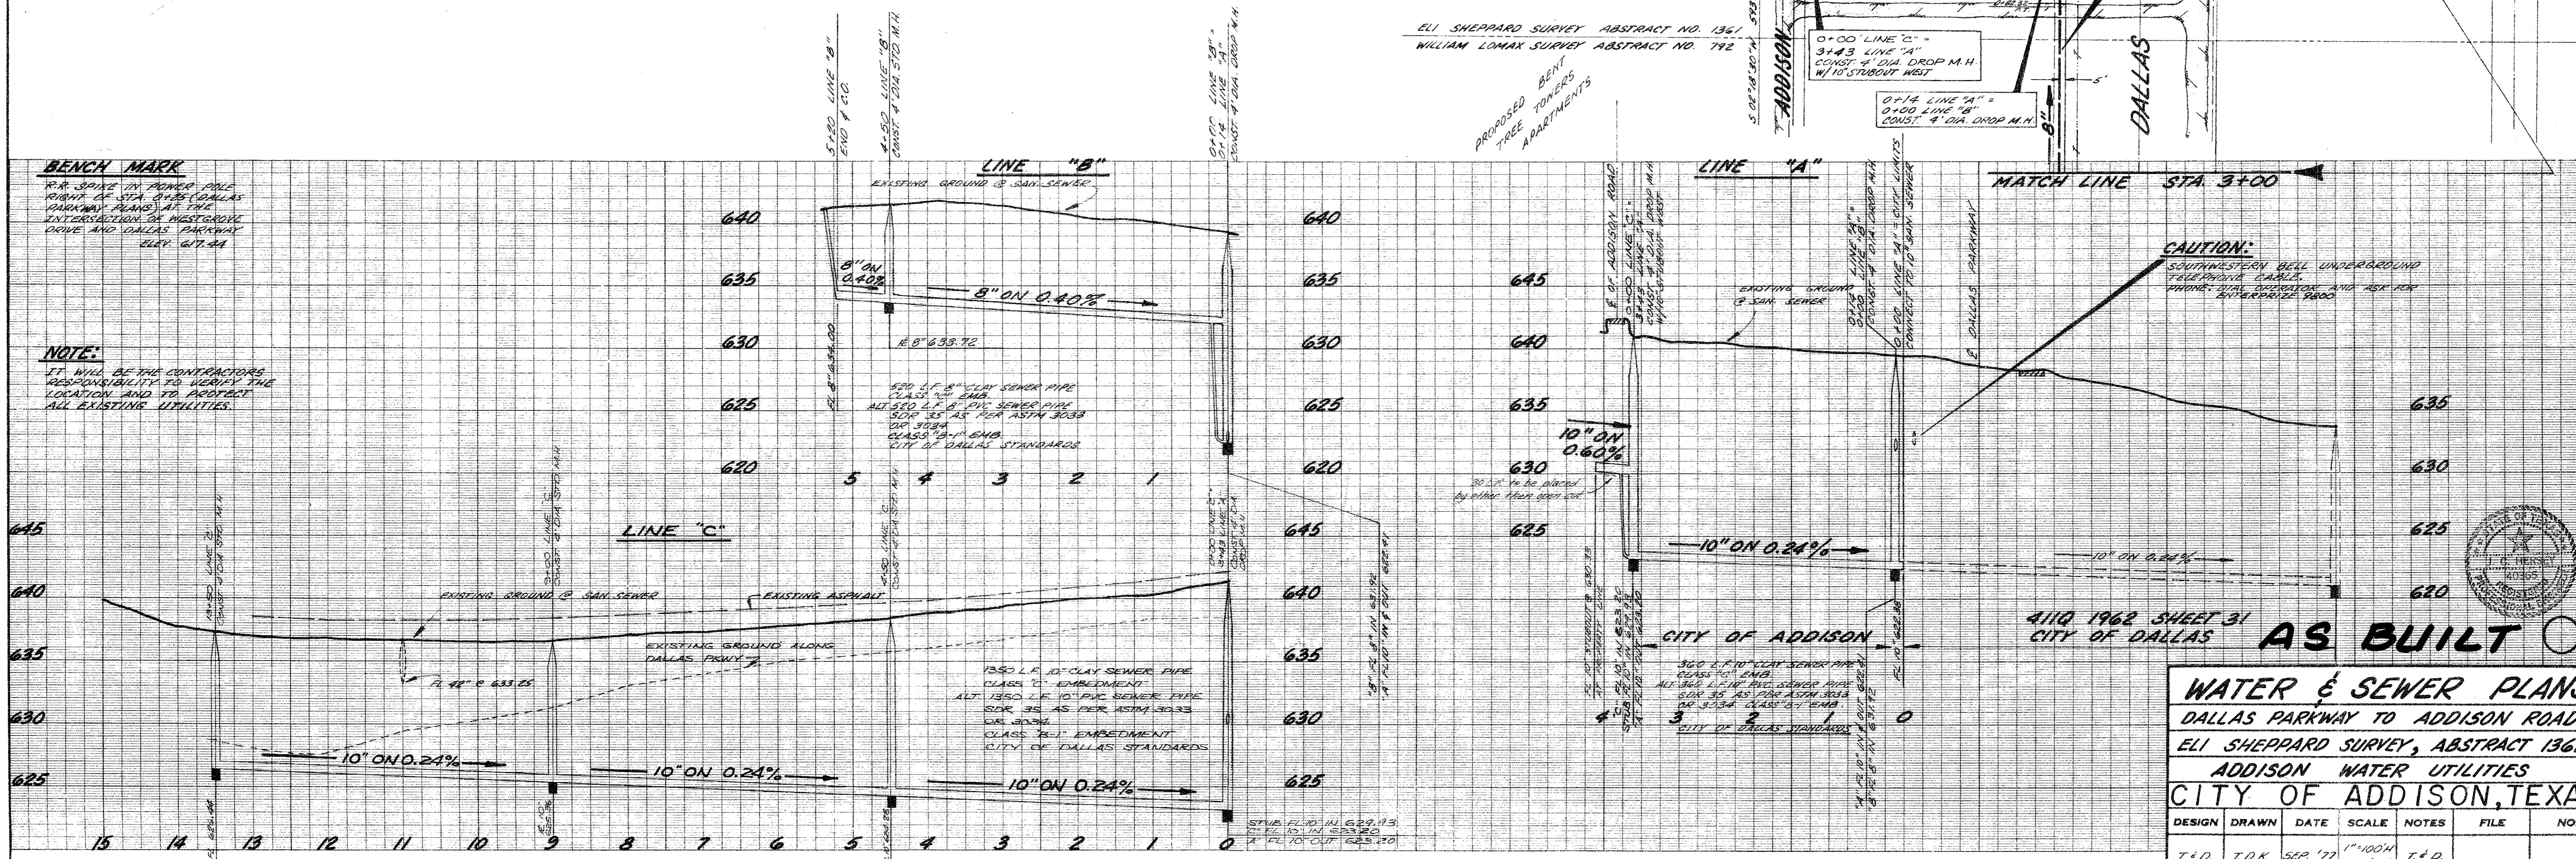

411Q 1962 SHEET 31
CITY OF DALLAS
AS BUILT

WATER & SEWER PLANS						
DALLAS PARKWAY TO ADDISON ROAD						
ELI SHEPPARD SURVEY, ABSTRACT 1361						
ADDISON WATER UTILITIES						
CITY OF ADDISON, TEXAS						
DESIGN	DRAWN	DATE	SCALE	NOTES	FILE	NO.
T. & D.	T. O. K.	SEP '77	1" = 100' 1" = 6' V.	T. & D.		


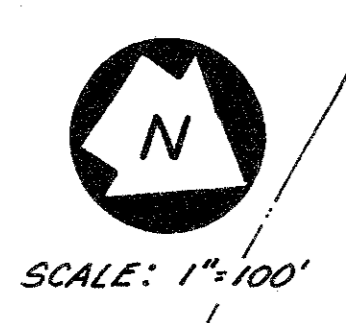


JACK ROUGE, W.R. SANFORD, CHRISTIAN CONCERN FOUNDATION INC., FIRST BAPTIST CHURCH OF DALLAS, W.A. CRISWELL FOUNDATION, INC.

ABSTRACT 792

R.S.F. LAND CORPORATION & OAK CLIFF SAVINGS & LOAN ASSOCIATION


SAN SEWER CURVE DATA	
CI	D = 50° 01' 00"
	R = 1605.00'
	T = 748.71'
	L = 1401.09'

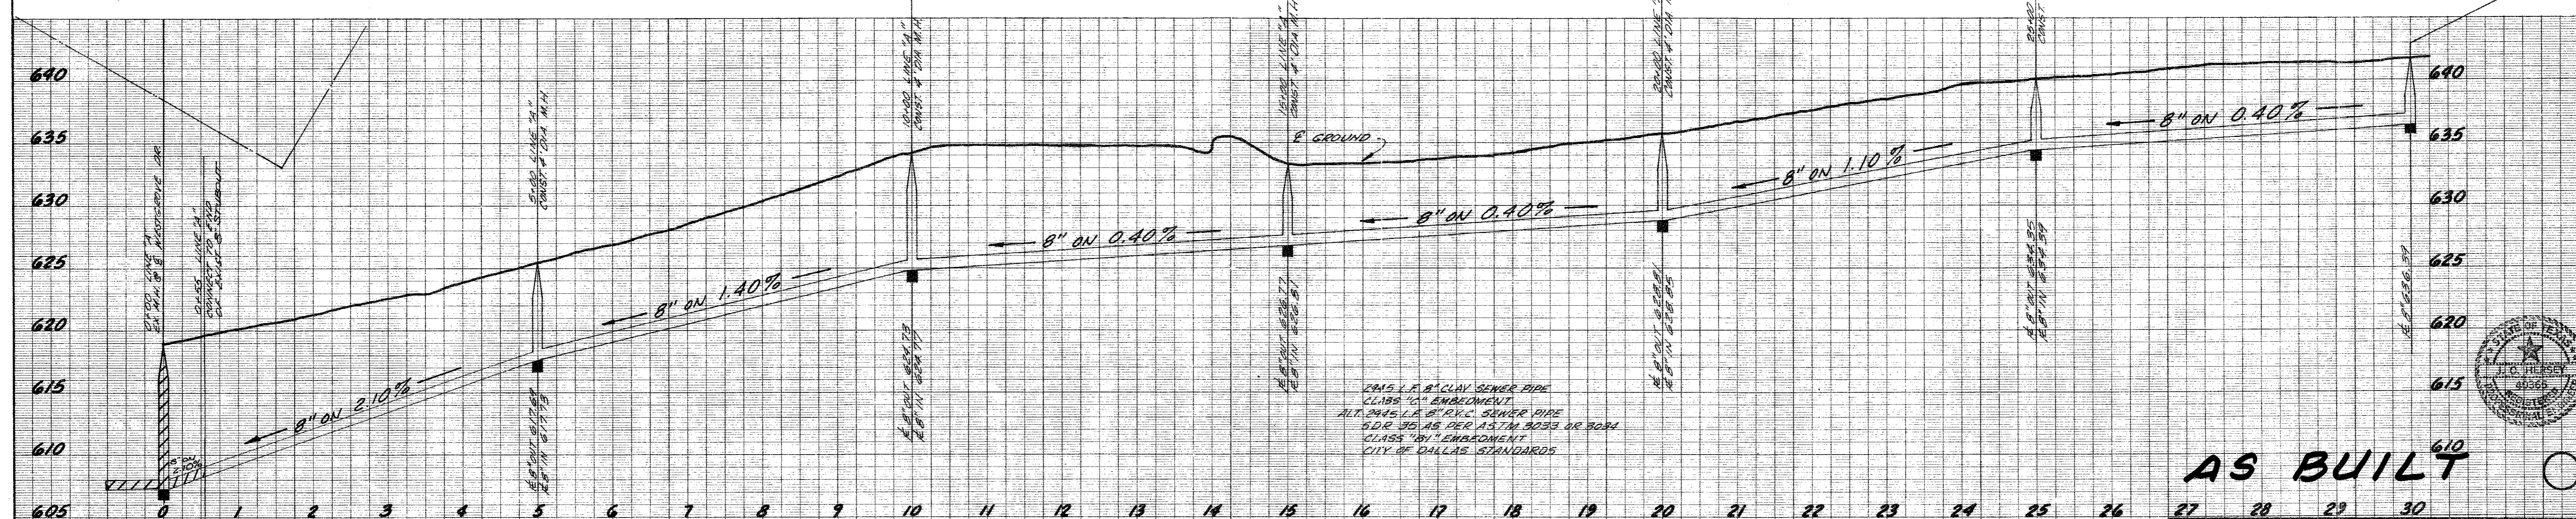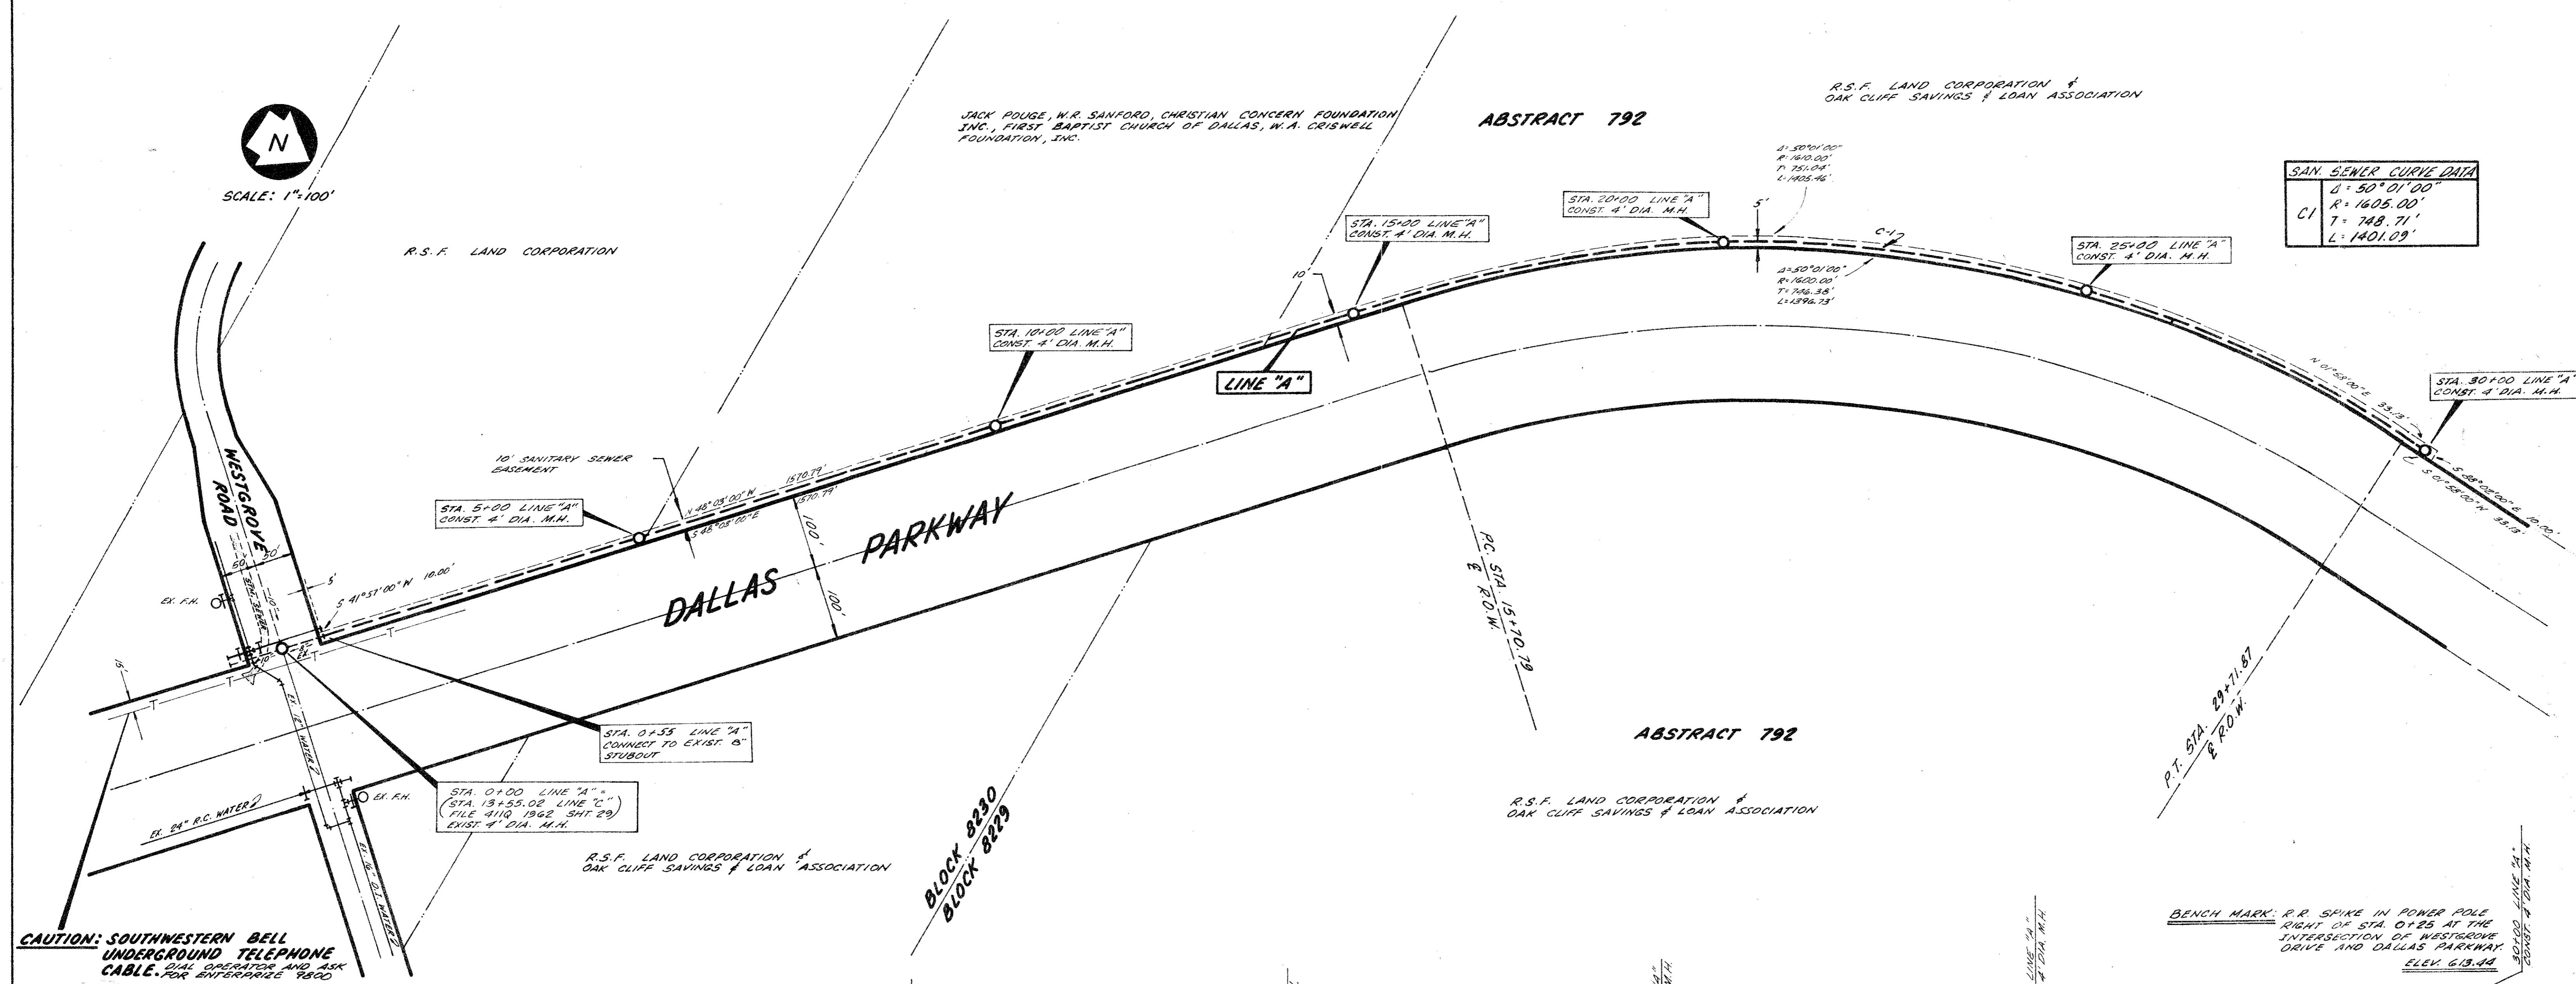

AS BUILT



WATER & SAN. SEWER PLANS
 DALLAS PARKWAY
 WESTGROVE DRIVE TO COUNTY LINE
 ADDISON WATER UTILITIES
 CITY OF ADDISON, TEXAS

DESIGN	DRAWN	DATE	SCALE	NOTES	FILE	NO.
THURGOOD	DOWNEY	APR 77	1"=100' H 1"=6' V	T & D		

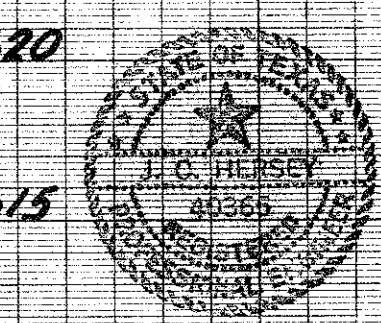



SCALE: 1"=100'

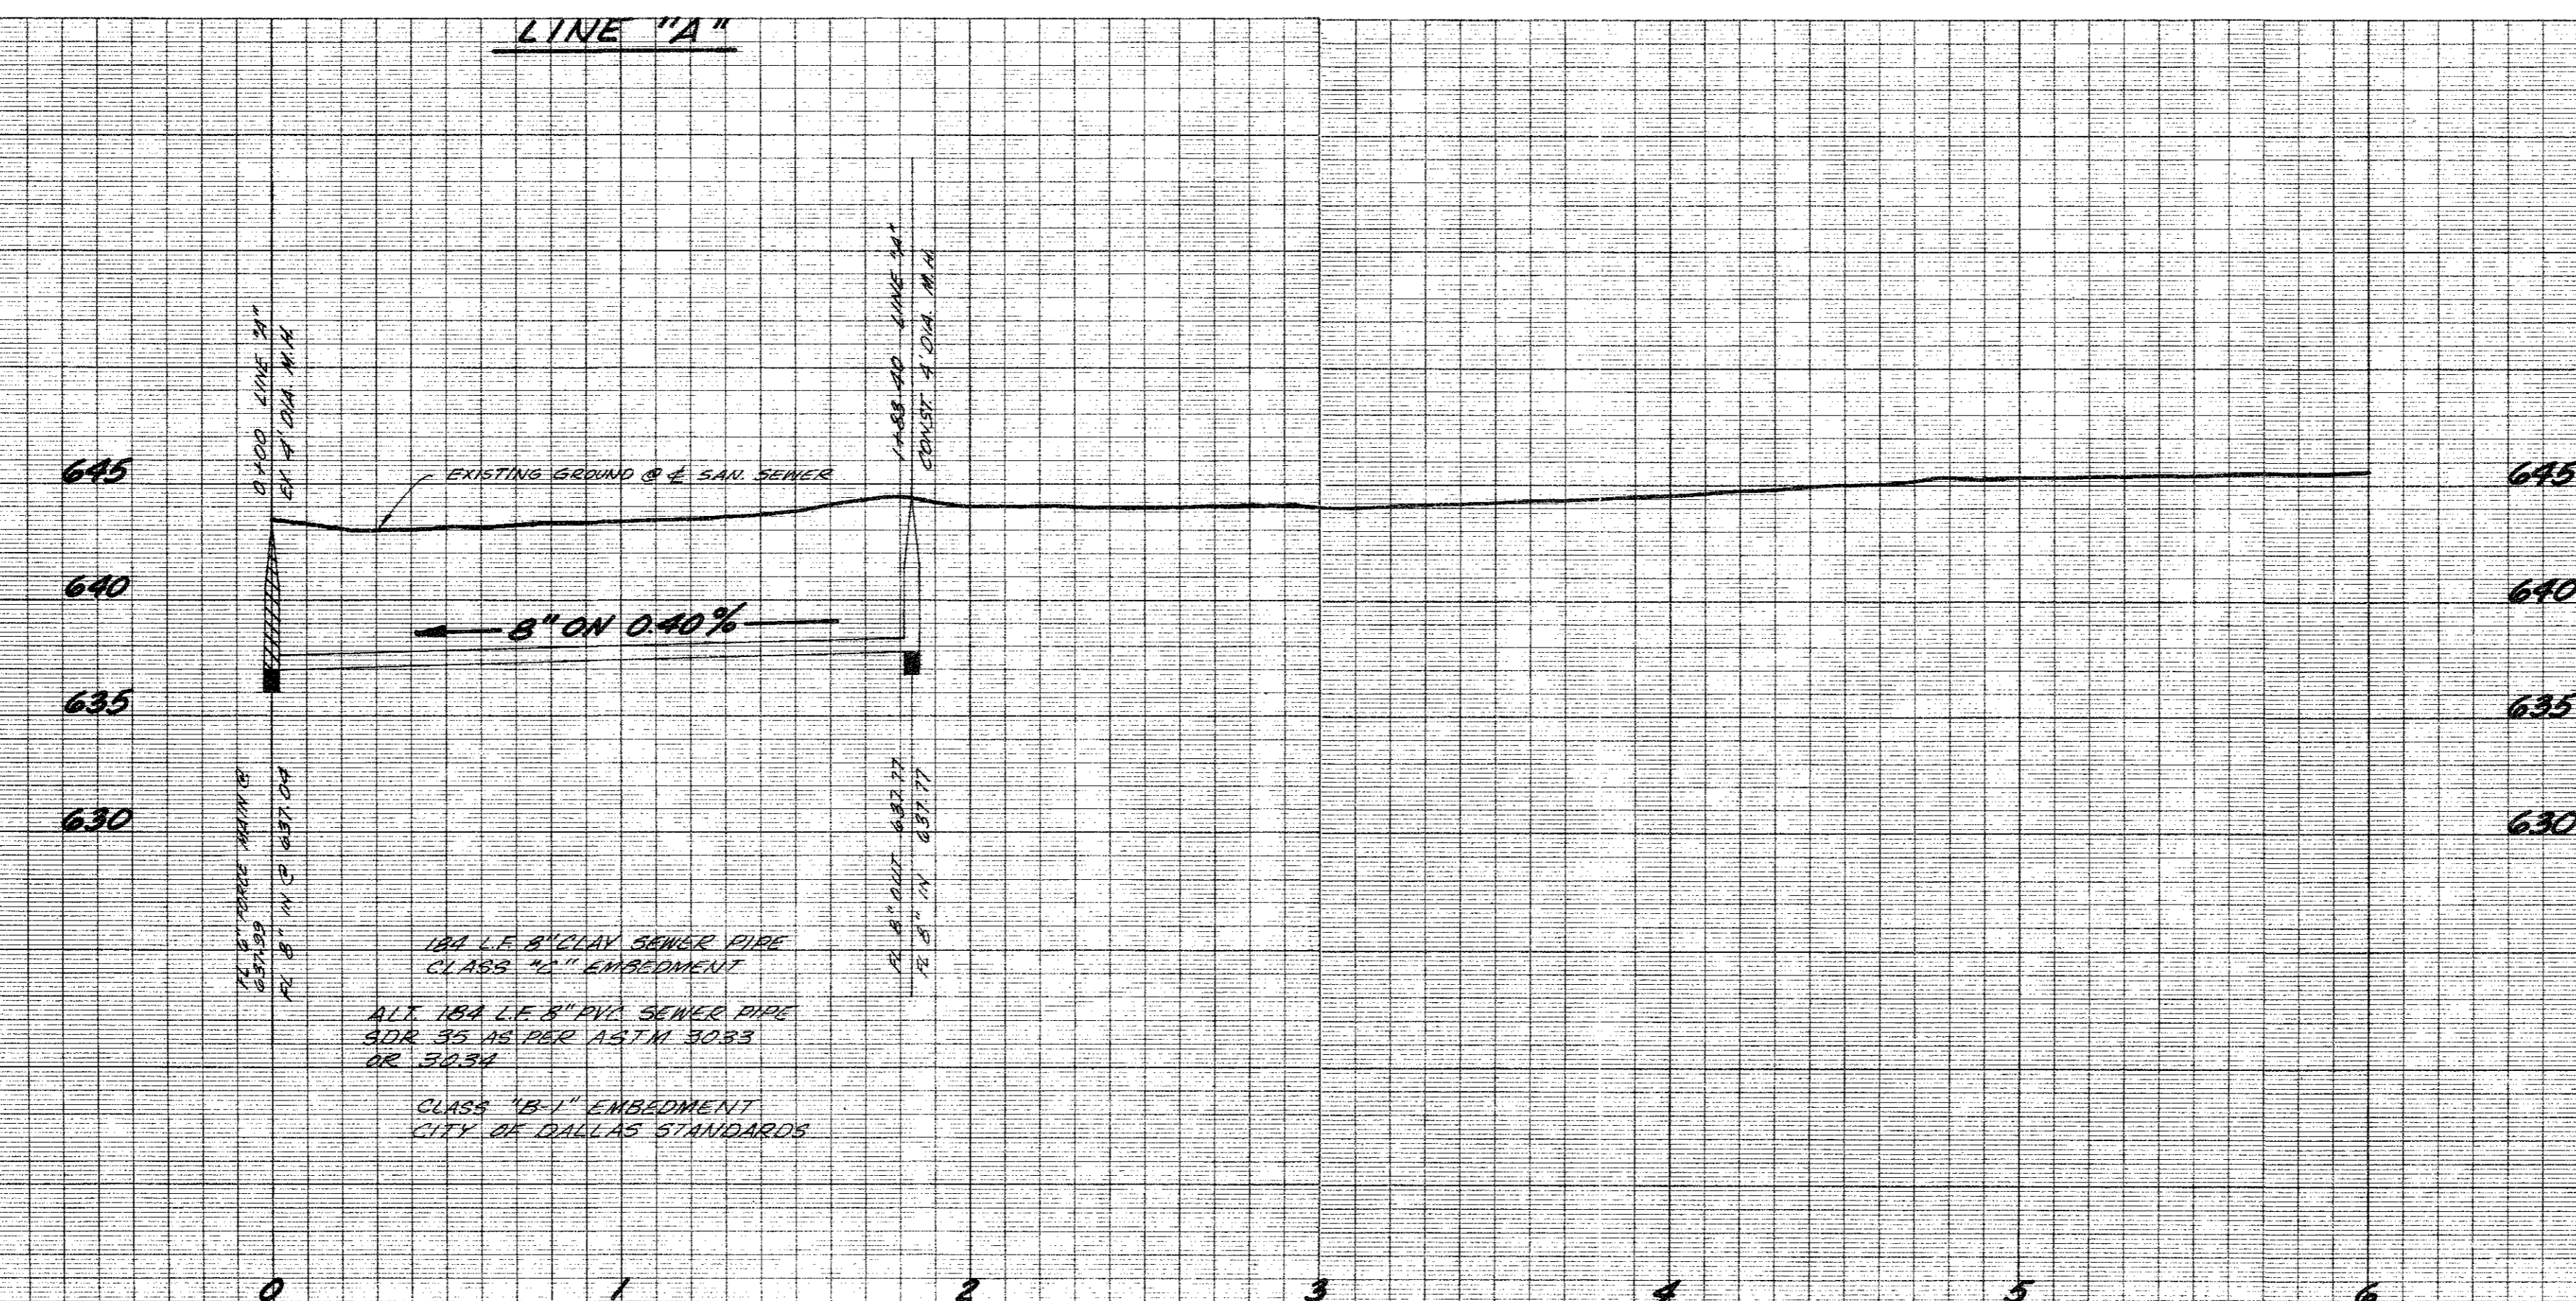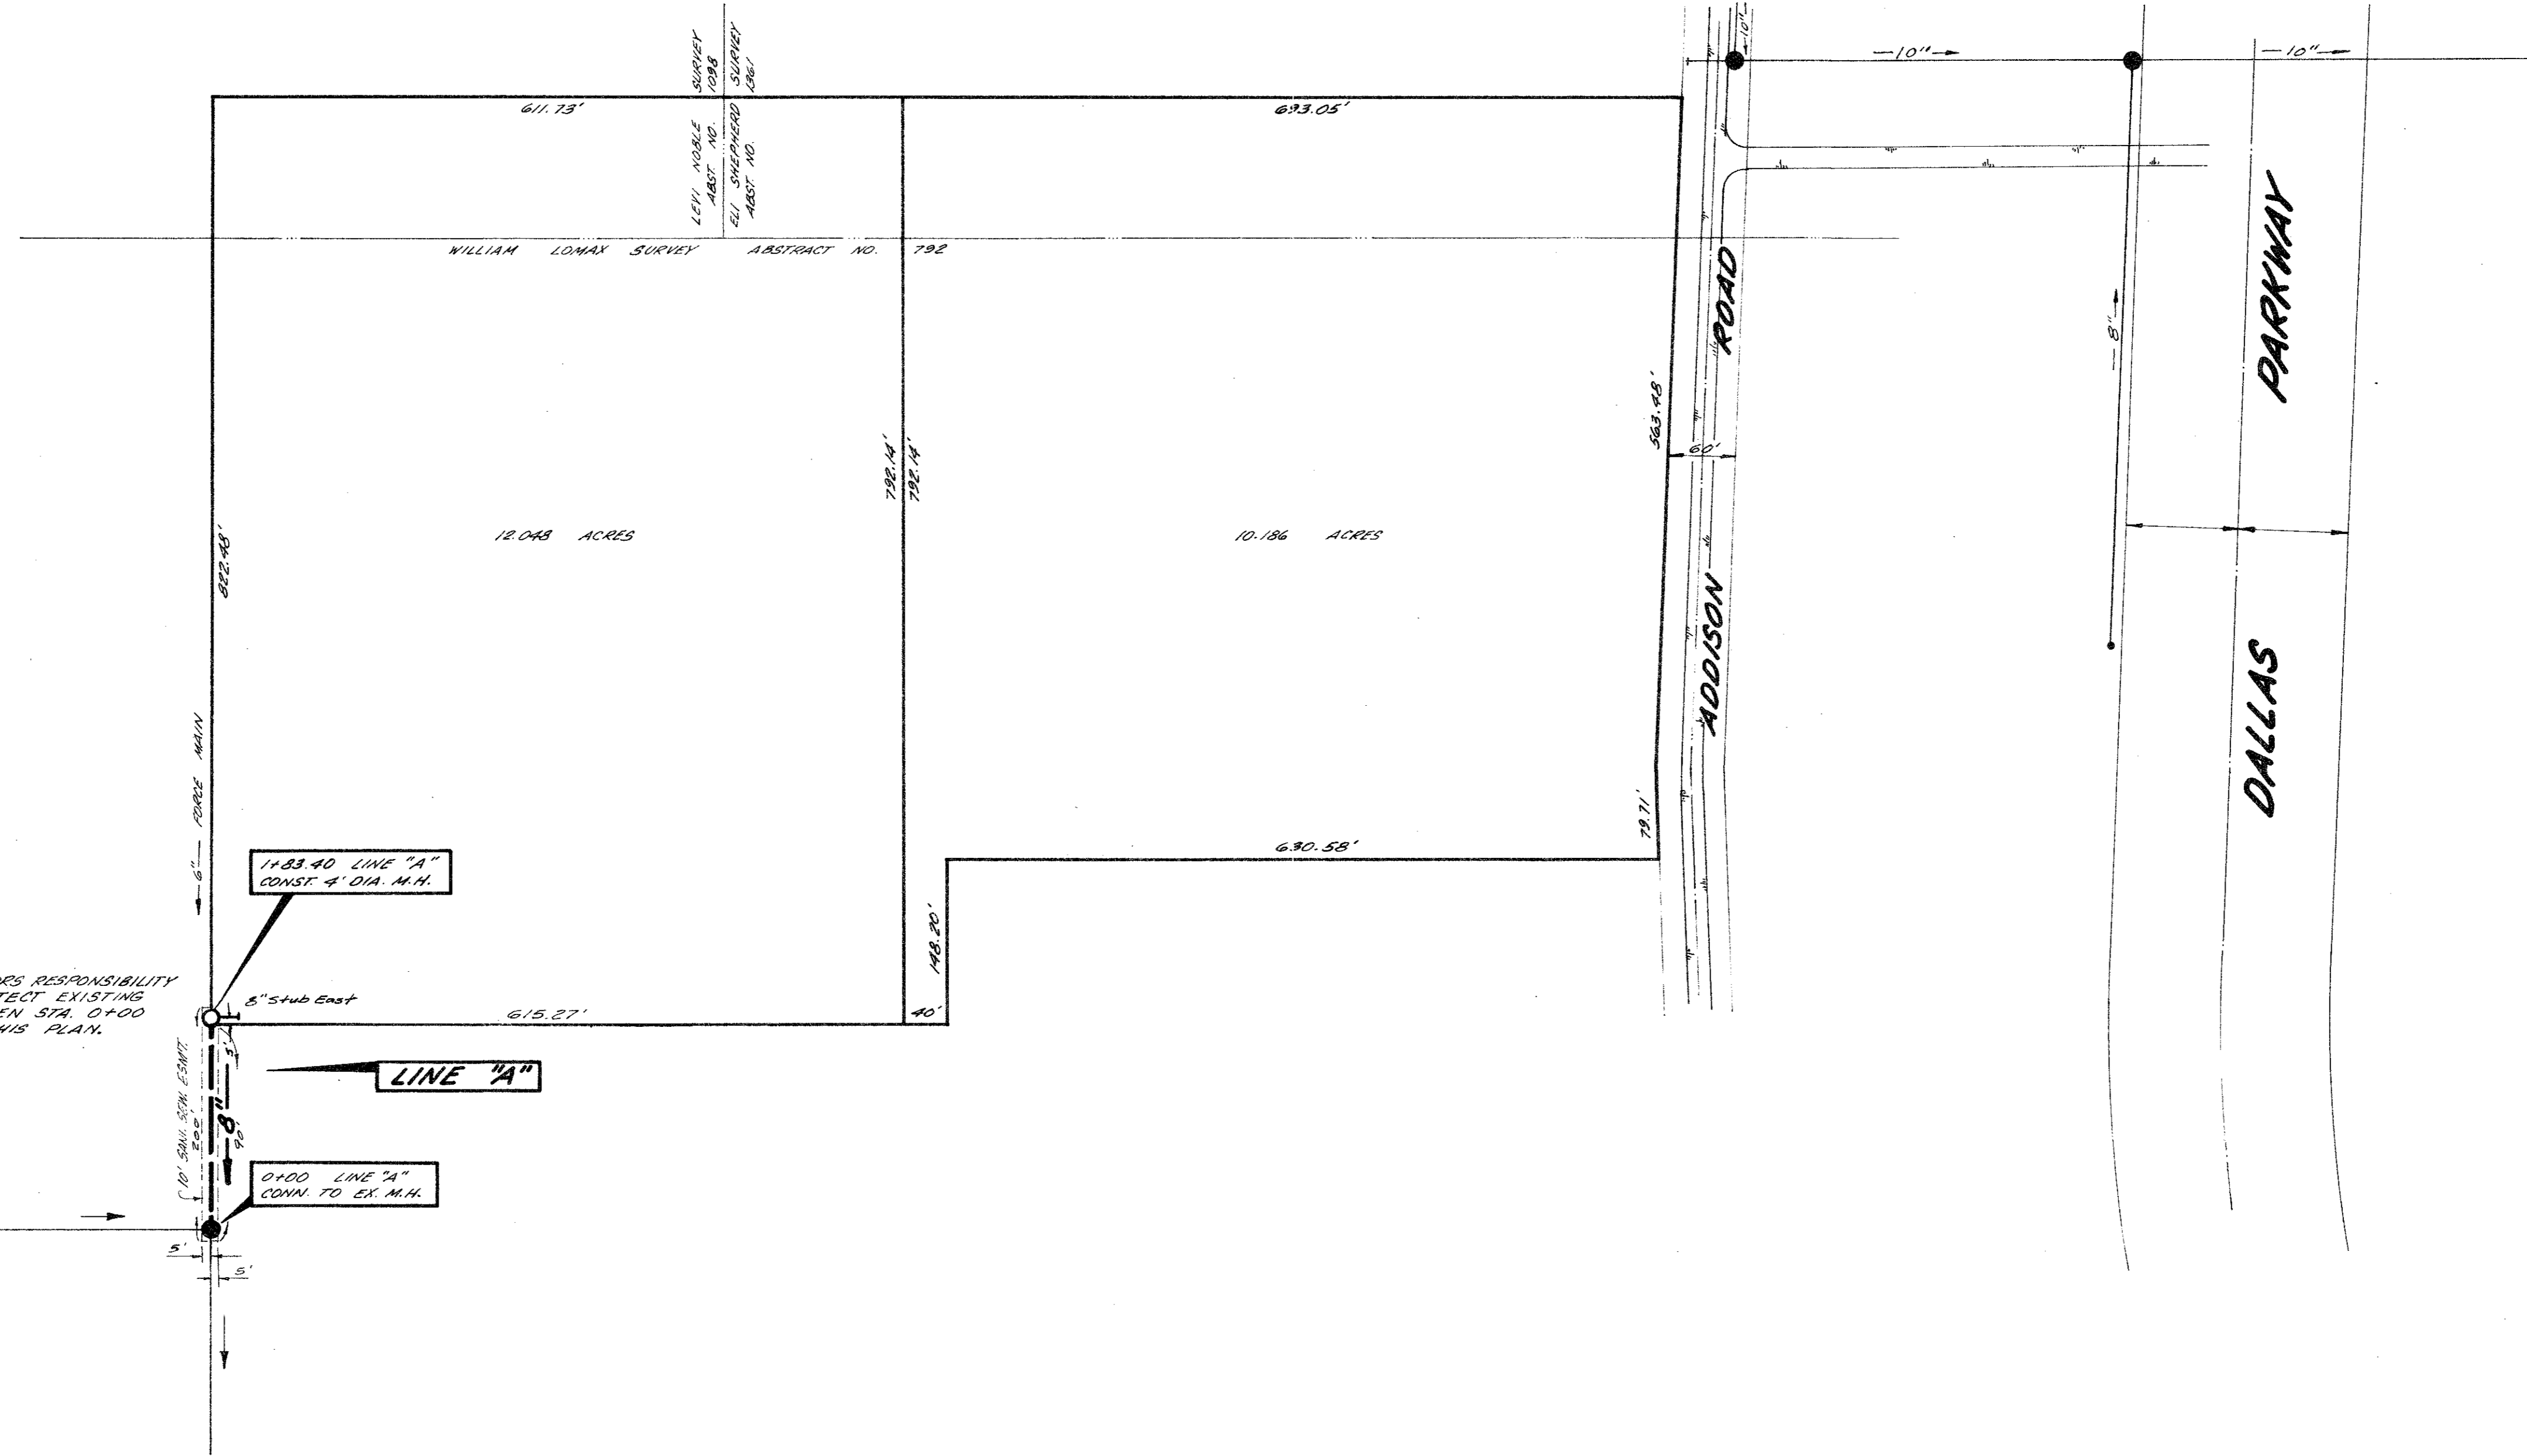

NOTE: IT WILL BE THE CONTRACTOR'S RESPONSIBILITY TO VERIFY THE LOCATION AND TO PROTECT ALL EXISTING UTILITIES.

BEARY MARK: NAIL IN THE WEST SIDE OF DOOLEY ROAD AND 15 FEET 240' NORTH OF SOUTHWEST CORNER OF THE TEXAS CHRISTIAN ACADEMY TRACT. ELEV. 660.15'

18" I.E. 8" CLAY SEWER PIPE CLASS "B" EMBEDMENT
 ALL 18" I.E. 8" PV. SEWER PIPE SDR 35 PER ASTM 3083 OR 5054
 CLASS "B-1" EMBEDMENT CITY OF DALLAS STANDARDS

AS BUILT

WATER & SEWER PLANS

BENT TREE ~~XXXXXX~~ APARTMENTS

ADDISON ROAD

ADDISON WATER UTILITIES
CITY OF ADDISON, TEXAS

DESIGN	DRAWN	DATE	SCALE	NOTES	FILE	NO.
T&D	T&D	AUG. '77	1"=8' V	T&D		