

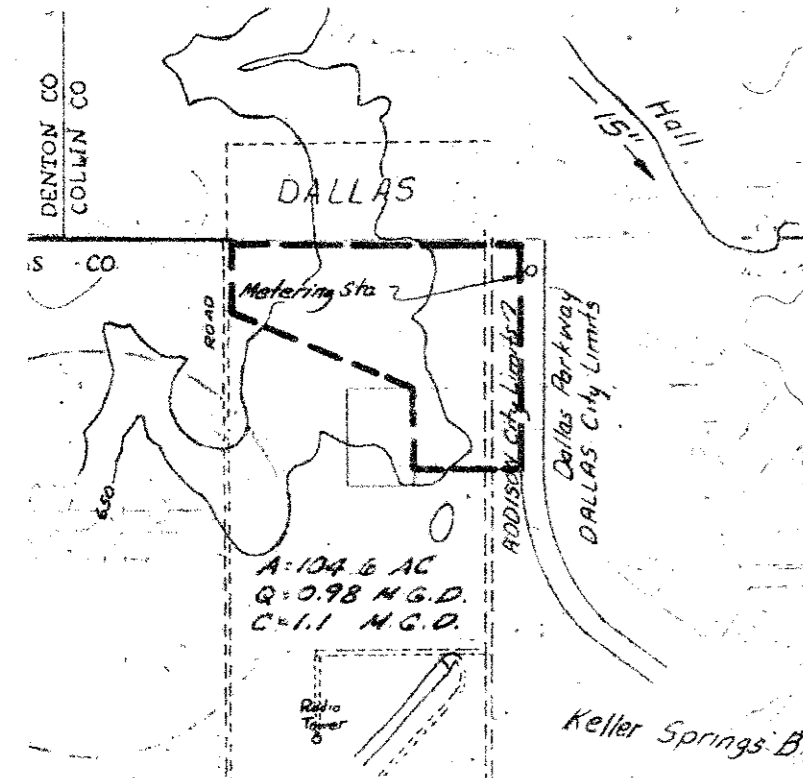
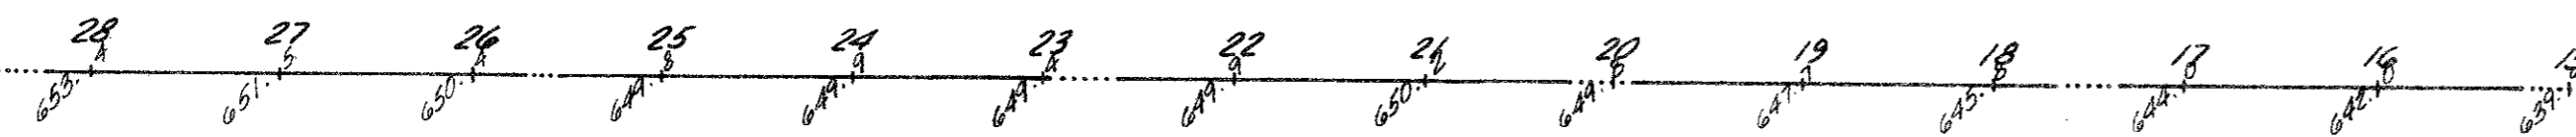


COLLIN COUNTY
DALLAS COUNTY

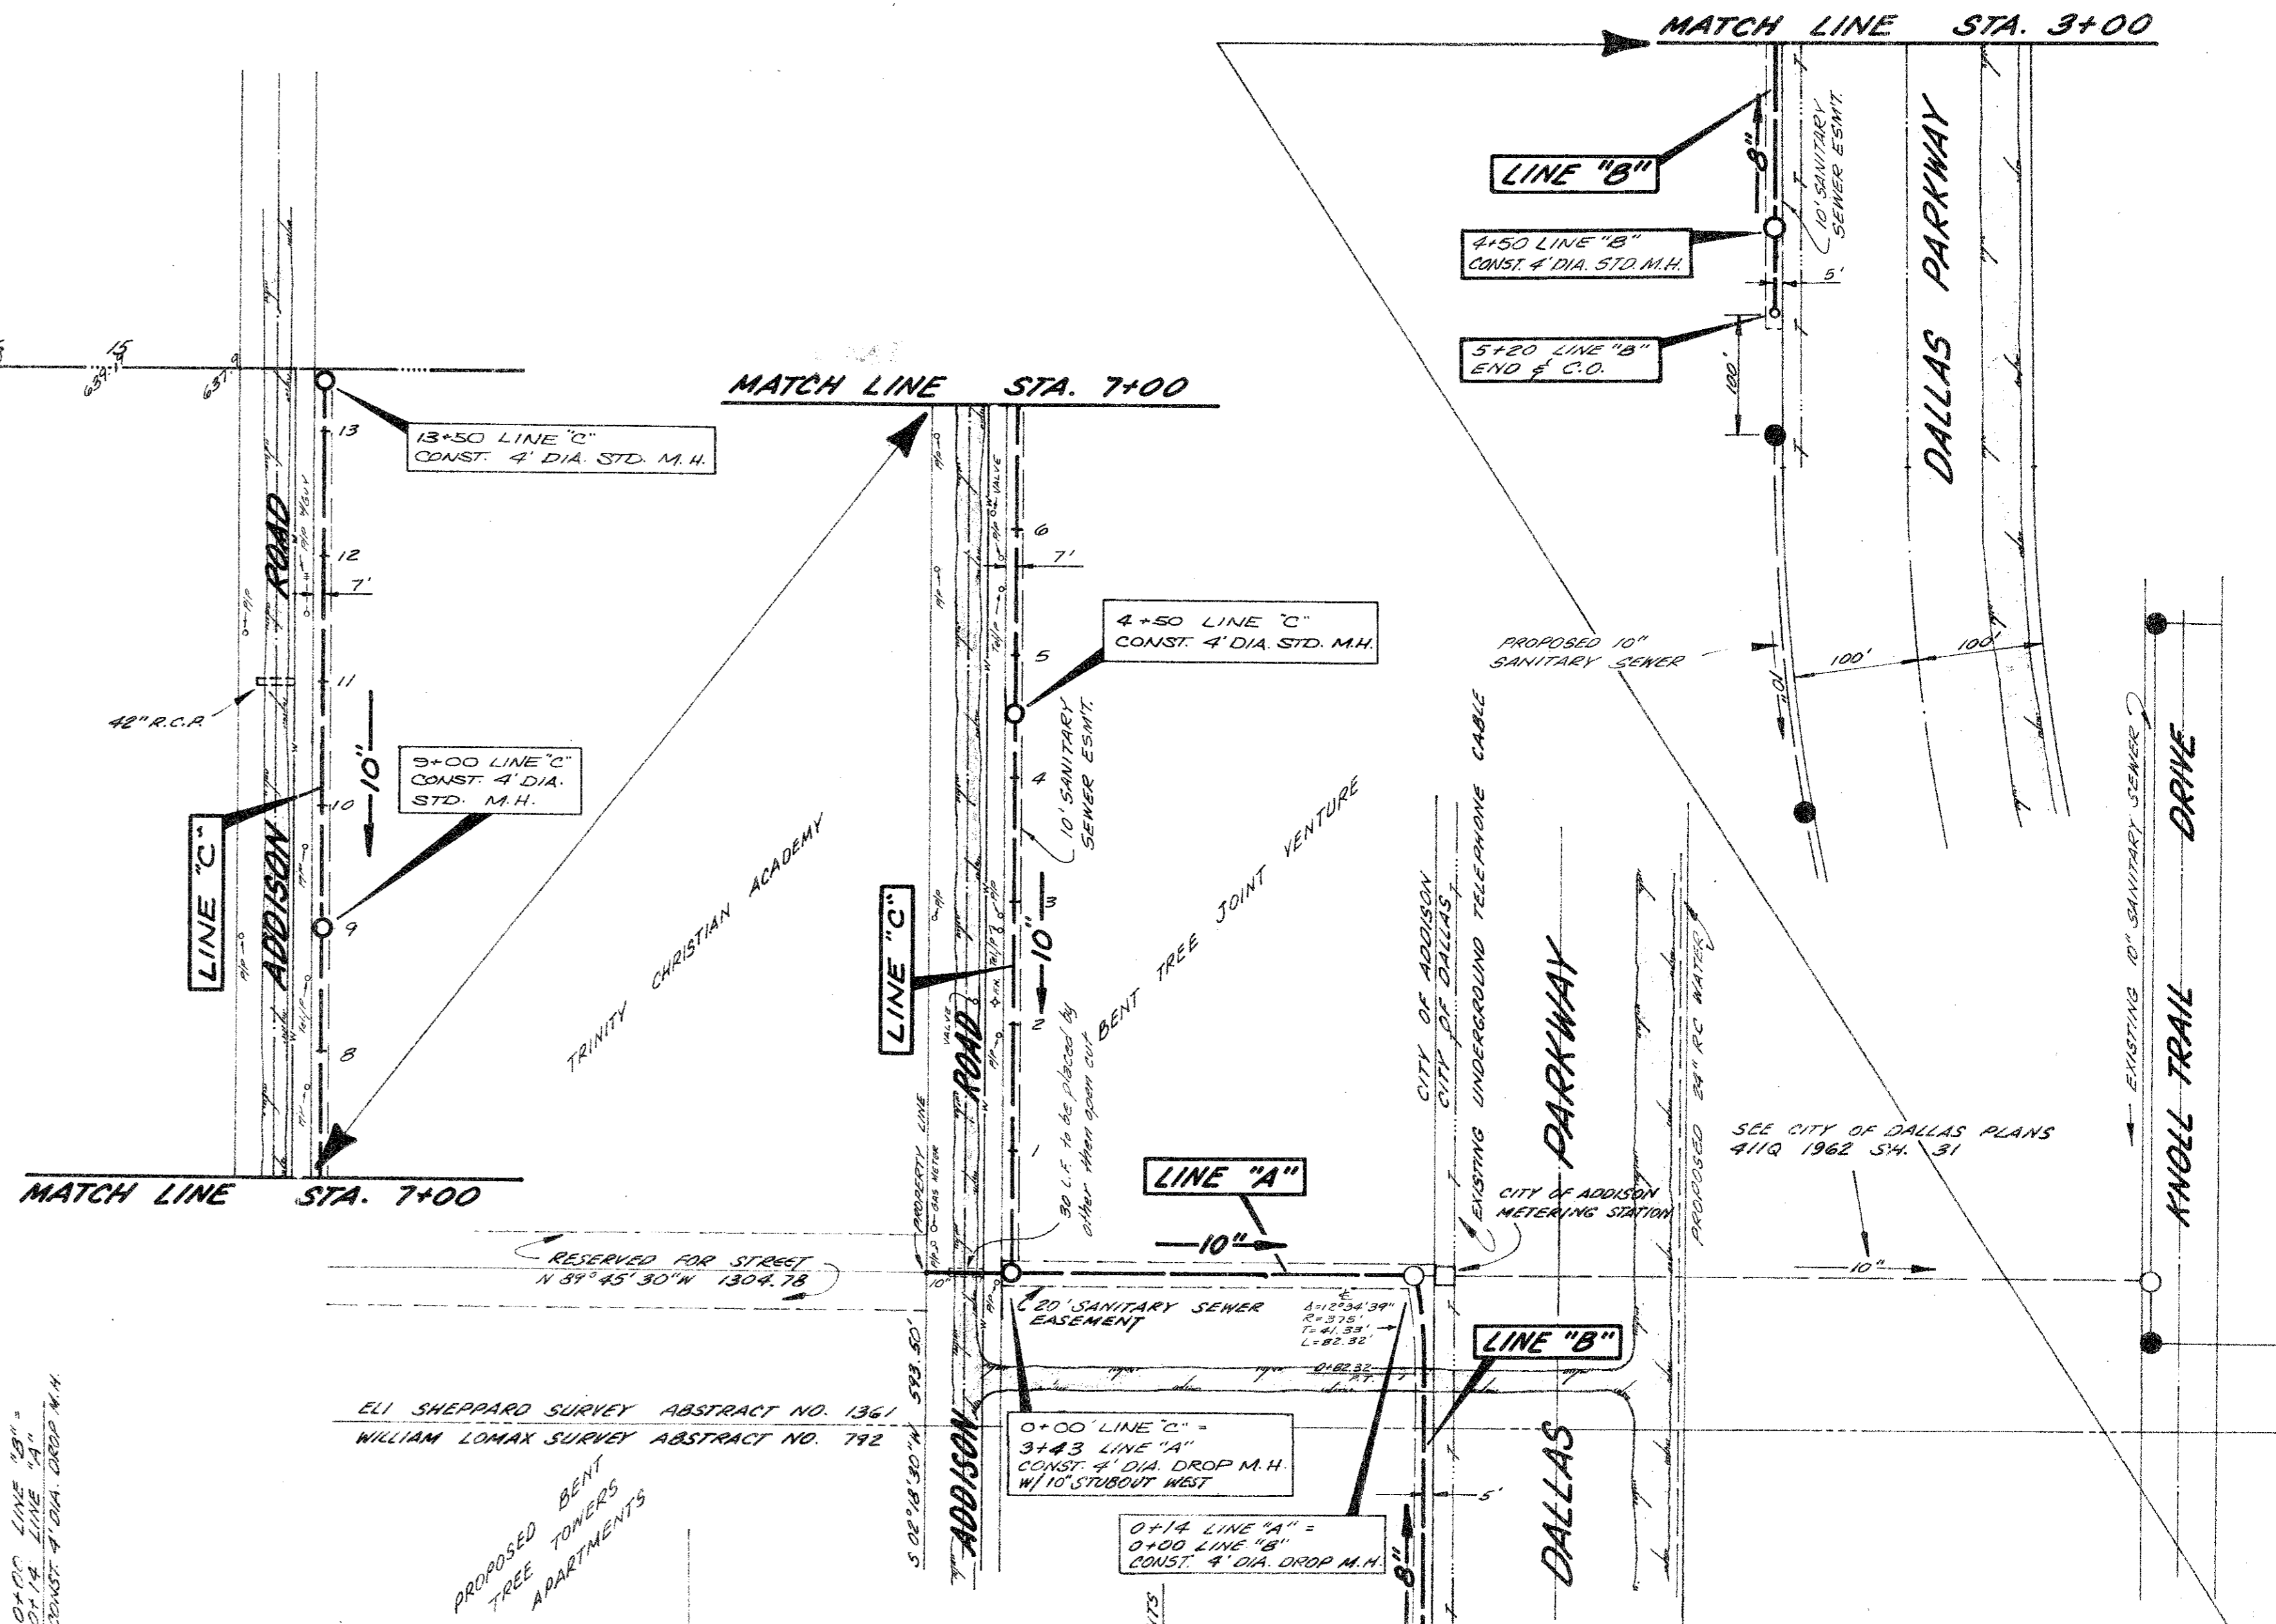

DRAINAGE AREA MAP

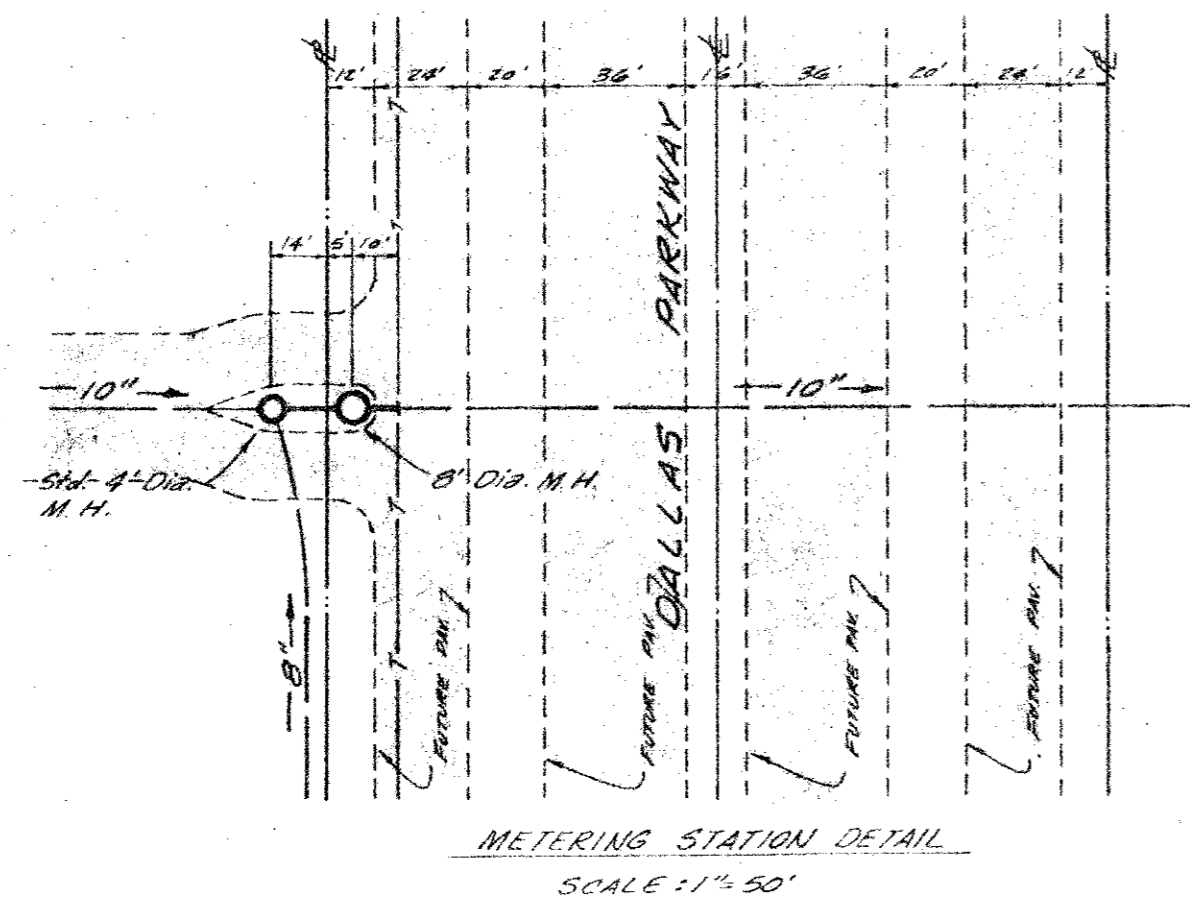


BENCH MARK

R.R. SPINE IN POWER POLE POINT OF STA. 0+00 (DALLAS PARKWAY PLANS) AT THE INTERSECTION OF HASTINGS DRIVE AND DALLAS PARKWAY DRIVE AND DALLAS PARKWAY DRIVE. ELEV. 617.84

NOTE:

IT WILL BE THE CONTRACTOR'S RESPONSIBILITY TO VERIFY THE LOCATION AND TO PROTECT ALL EXISTING UTILITIES.

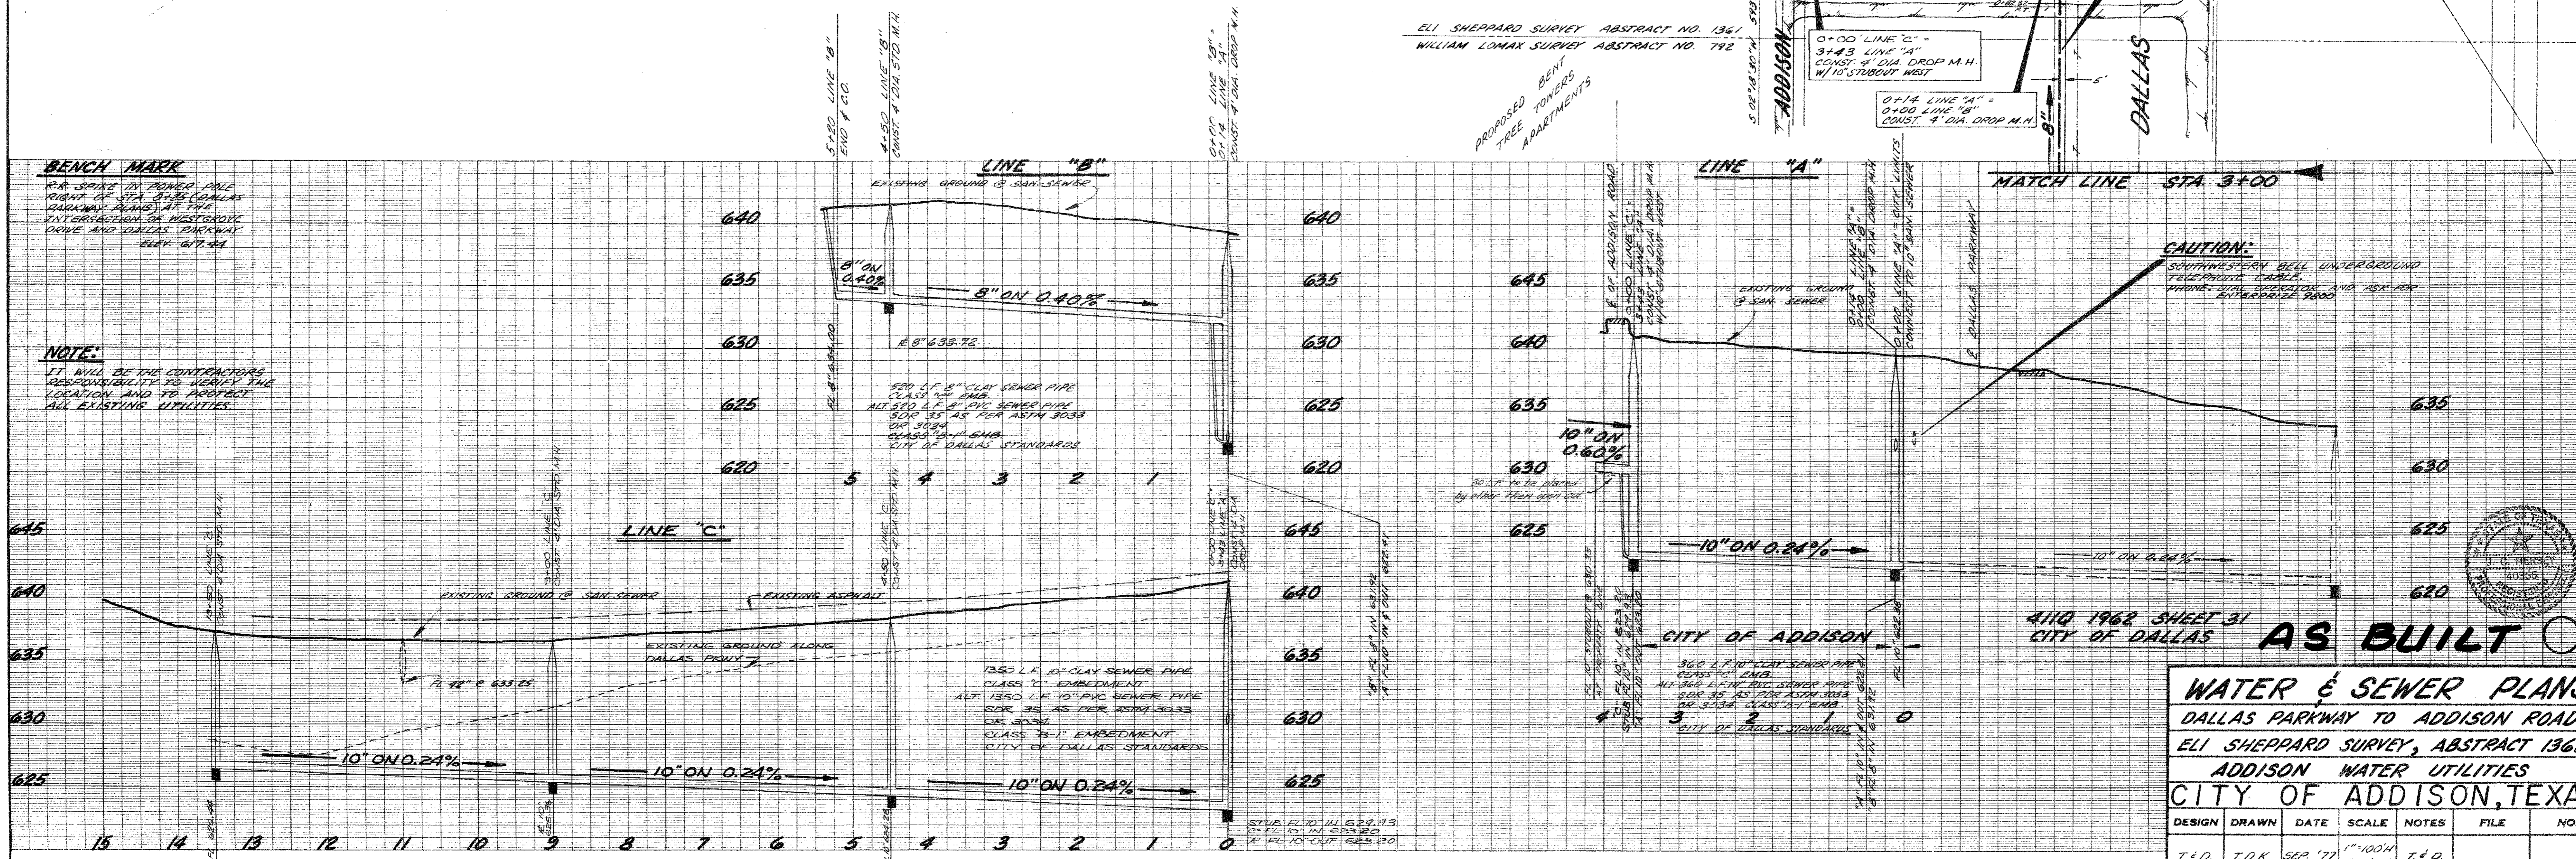

CAUTION:
SOUTHWESTERN BELL UNDERGROUND TELEPHONE CABLES. VERIFY CABLE DEPTH AND ASK FOR PROTECTIVE COVERING. 1980C

411Q 1962 SHEET 31
CITY OF DALLAS
AS BUILT

WATER & SEWER PLANS
DALLAS PARKWAY TO ADDISON ROAD
ELI SHEPPARD SURVEY, ABSTRACT 1361
ADDISON WATER UTILITIES
CITY OF ADDISON, TEXAS

DESIGN	DRAWN	DATE	SCALE	NOTES	FILE	NO.
T. & D.	T. O. K.	SEP '77	1"=100' 1"=6' V.	T. & D.		