
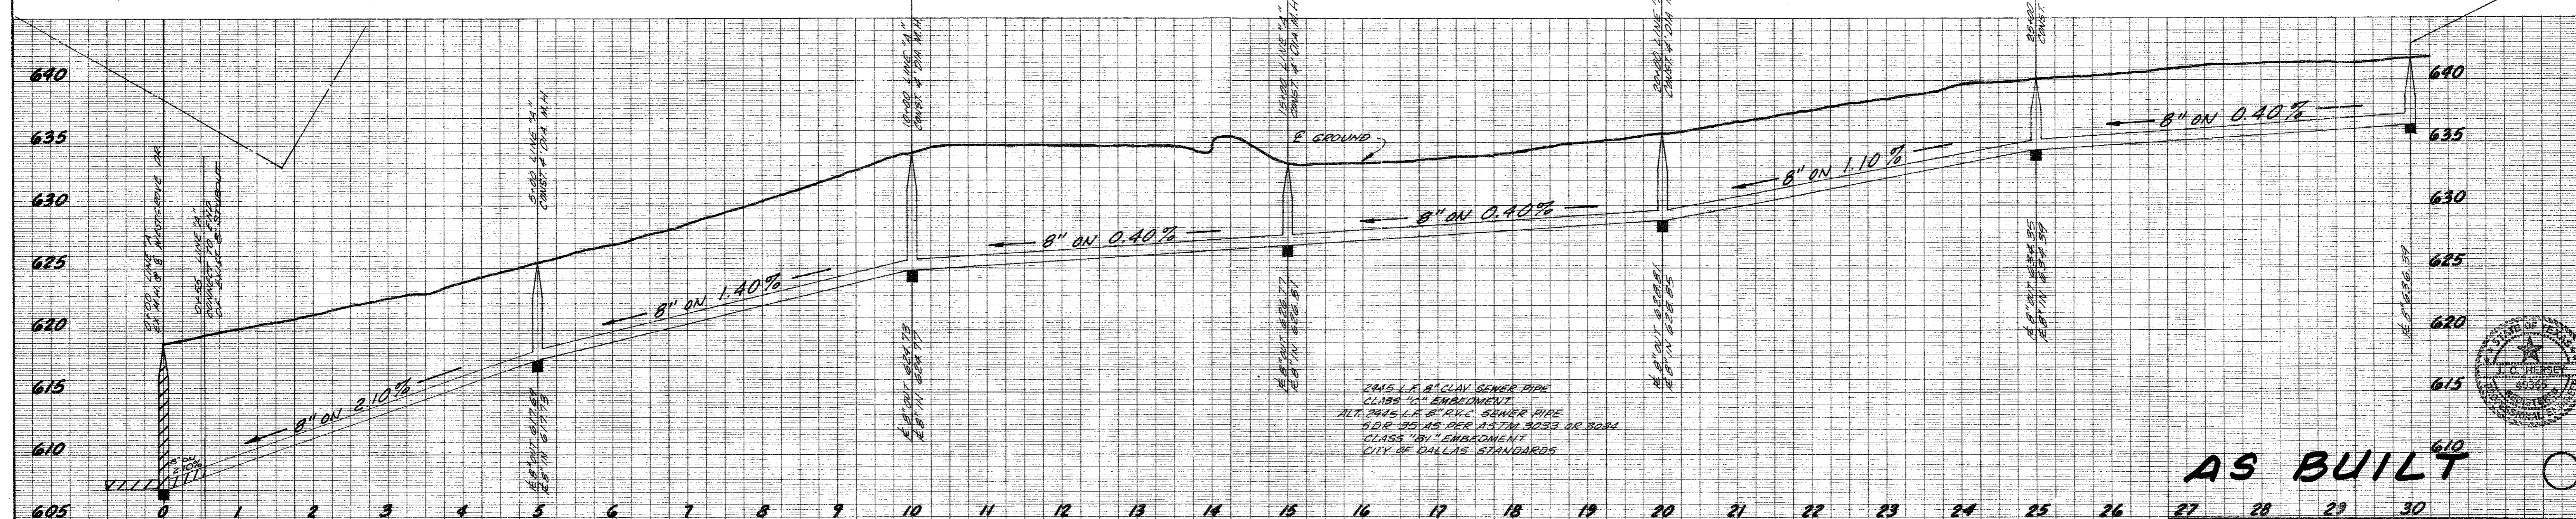


JACK ROUGE, W.R. SANFORD, CHRISTIAN CONCERN FOUNDATION INC., FIRST BAPTIST CHURCH OF DALLAS, W.A. CRISWELL FOUNDATION, INC.

ABSTRACT 792

R.S.F. LAND CORPORATION & OAK CLIFF SAVINGS & LOAN ASSOCIATION

SAN SEWER CURVE DATA	
CI	D = 50° 01' 00"
	R = 1605.00'
	T = 748.71'
	L = 1401.09'

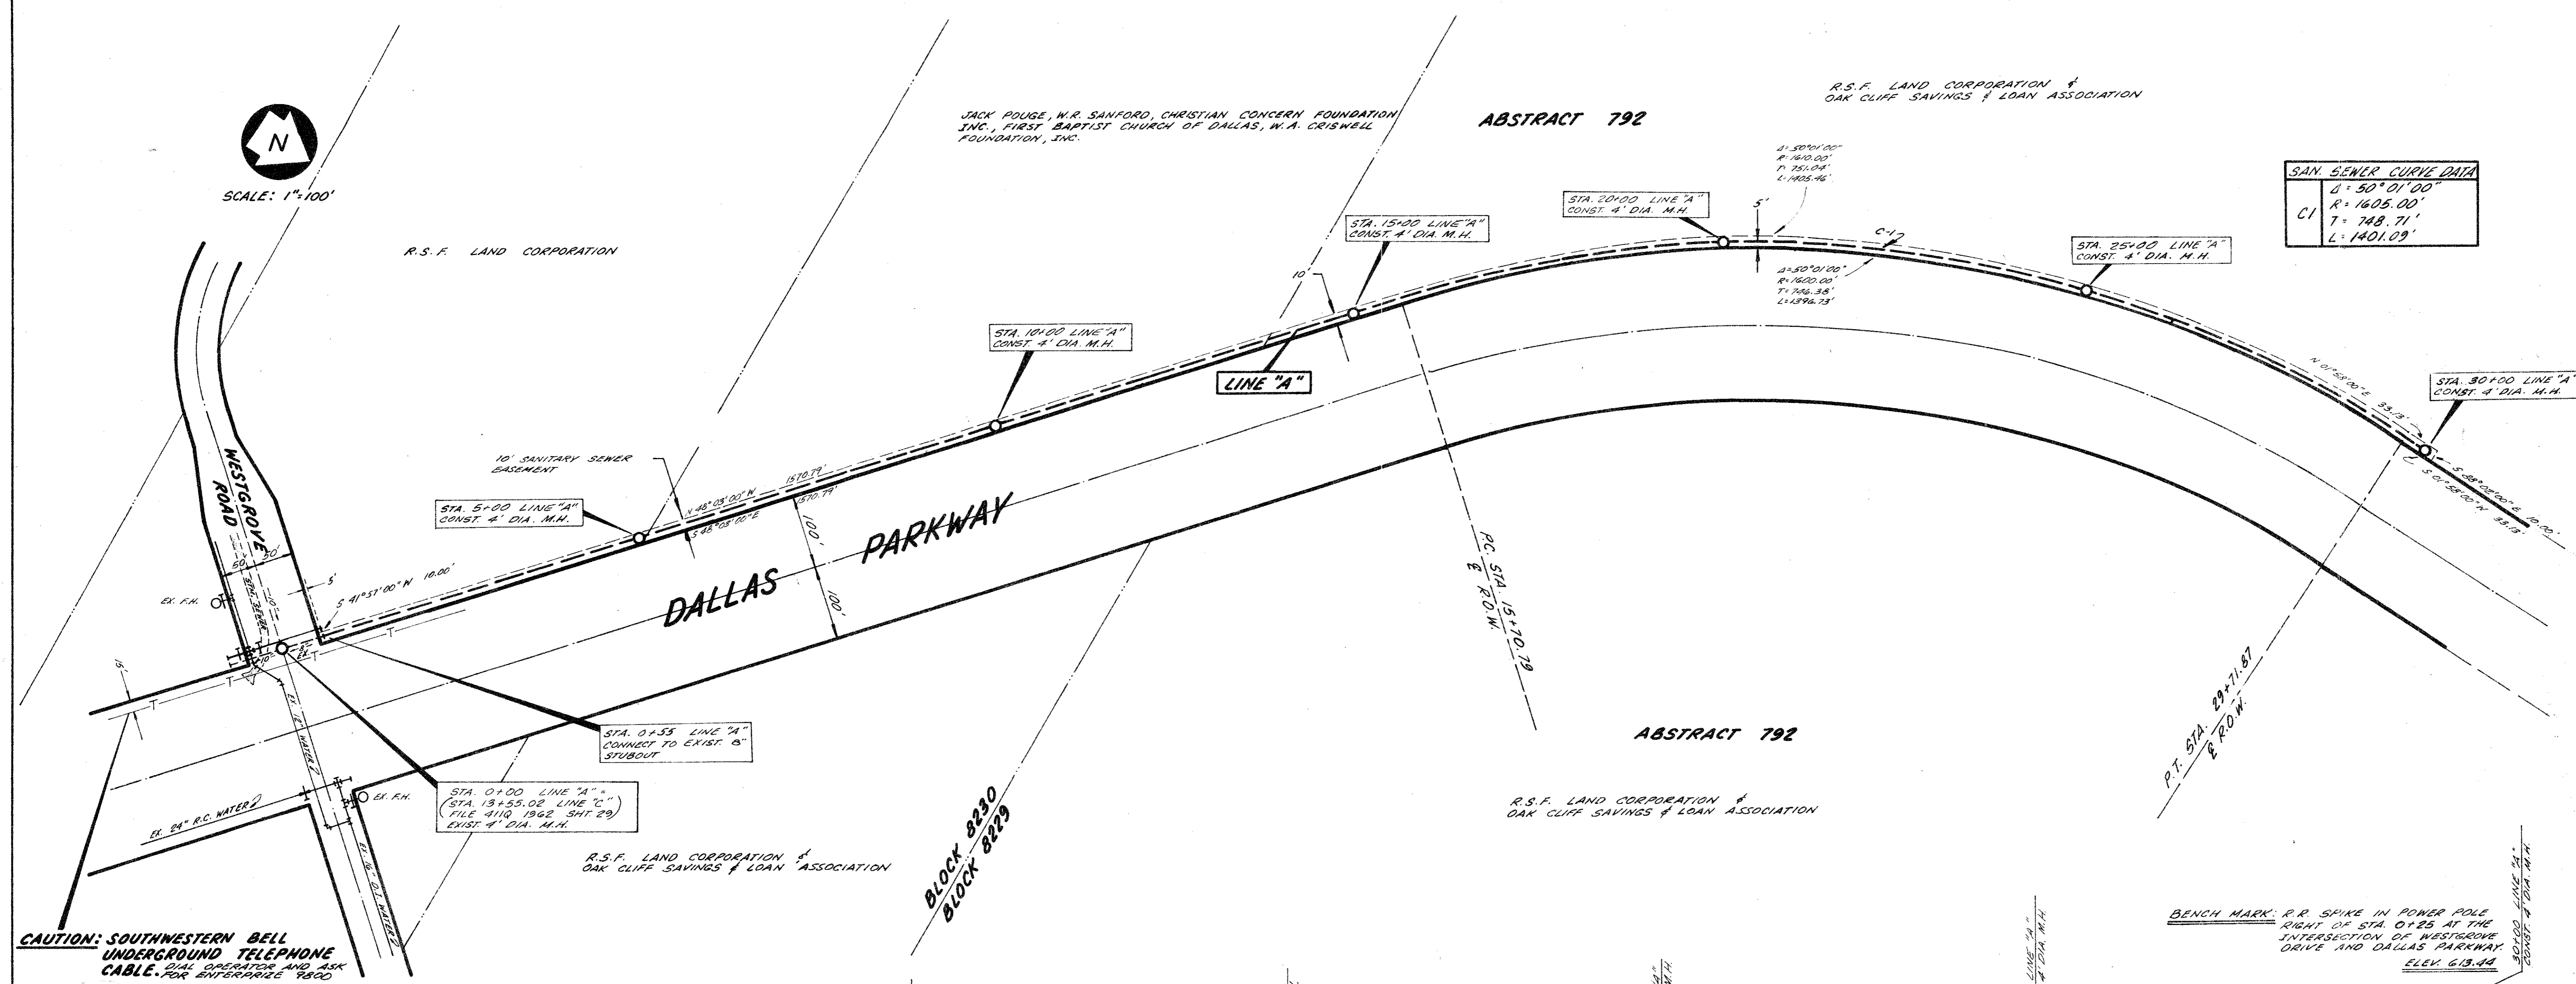

AS BUILT

WATER & SAN. SEWER PLANS
 DALLAS PARKWAY
 WESTGROVE DRIVE TO COUNTY LINE
 ADDISON WATER UTILITIES
 CITY OF ADDISON, TEXAS

DESIGN	DRAWN	DATE	SCALE	NOTES	FILE	NO.
THURGOOD	DOWNEY	APR 77	1"=100'	T & D		