




COLLIN COUNTY 28 27 26 25 24 23 22 21 20 19 18 17 16 15 14 13 12 11 10 9 8 7 6 5 4 3 2 1 0  
 DALLAS COUNTY

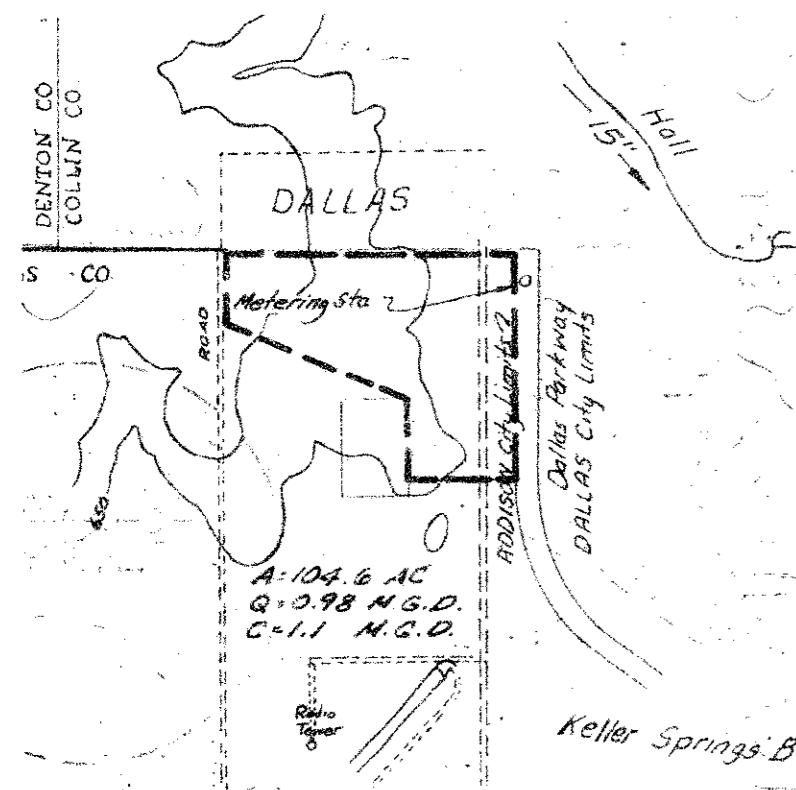

DRAINAGE AREA MAP

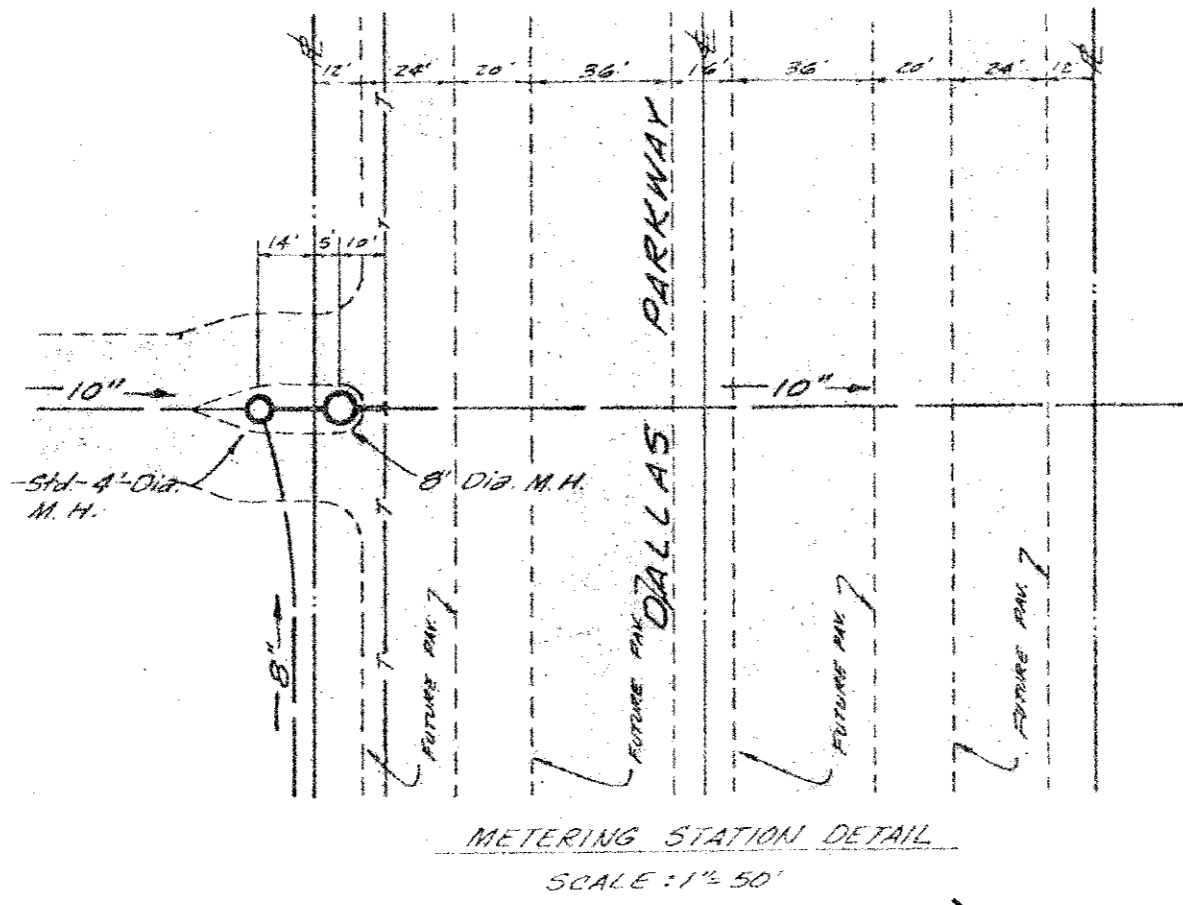

METERING STATION DETAIL  
SCALE: 1" = 50'

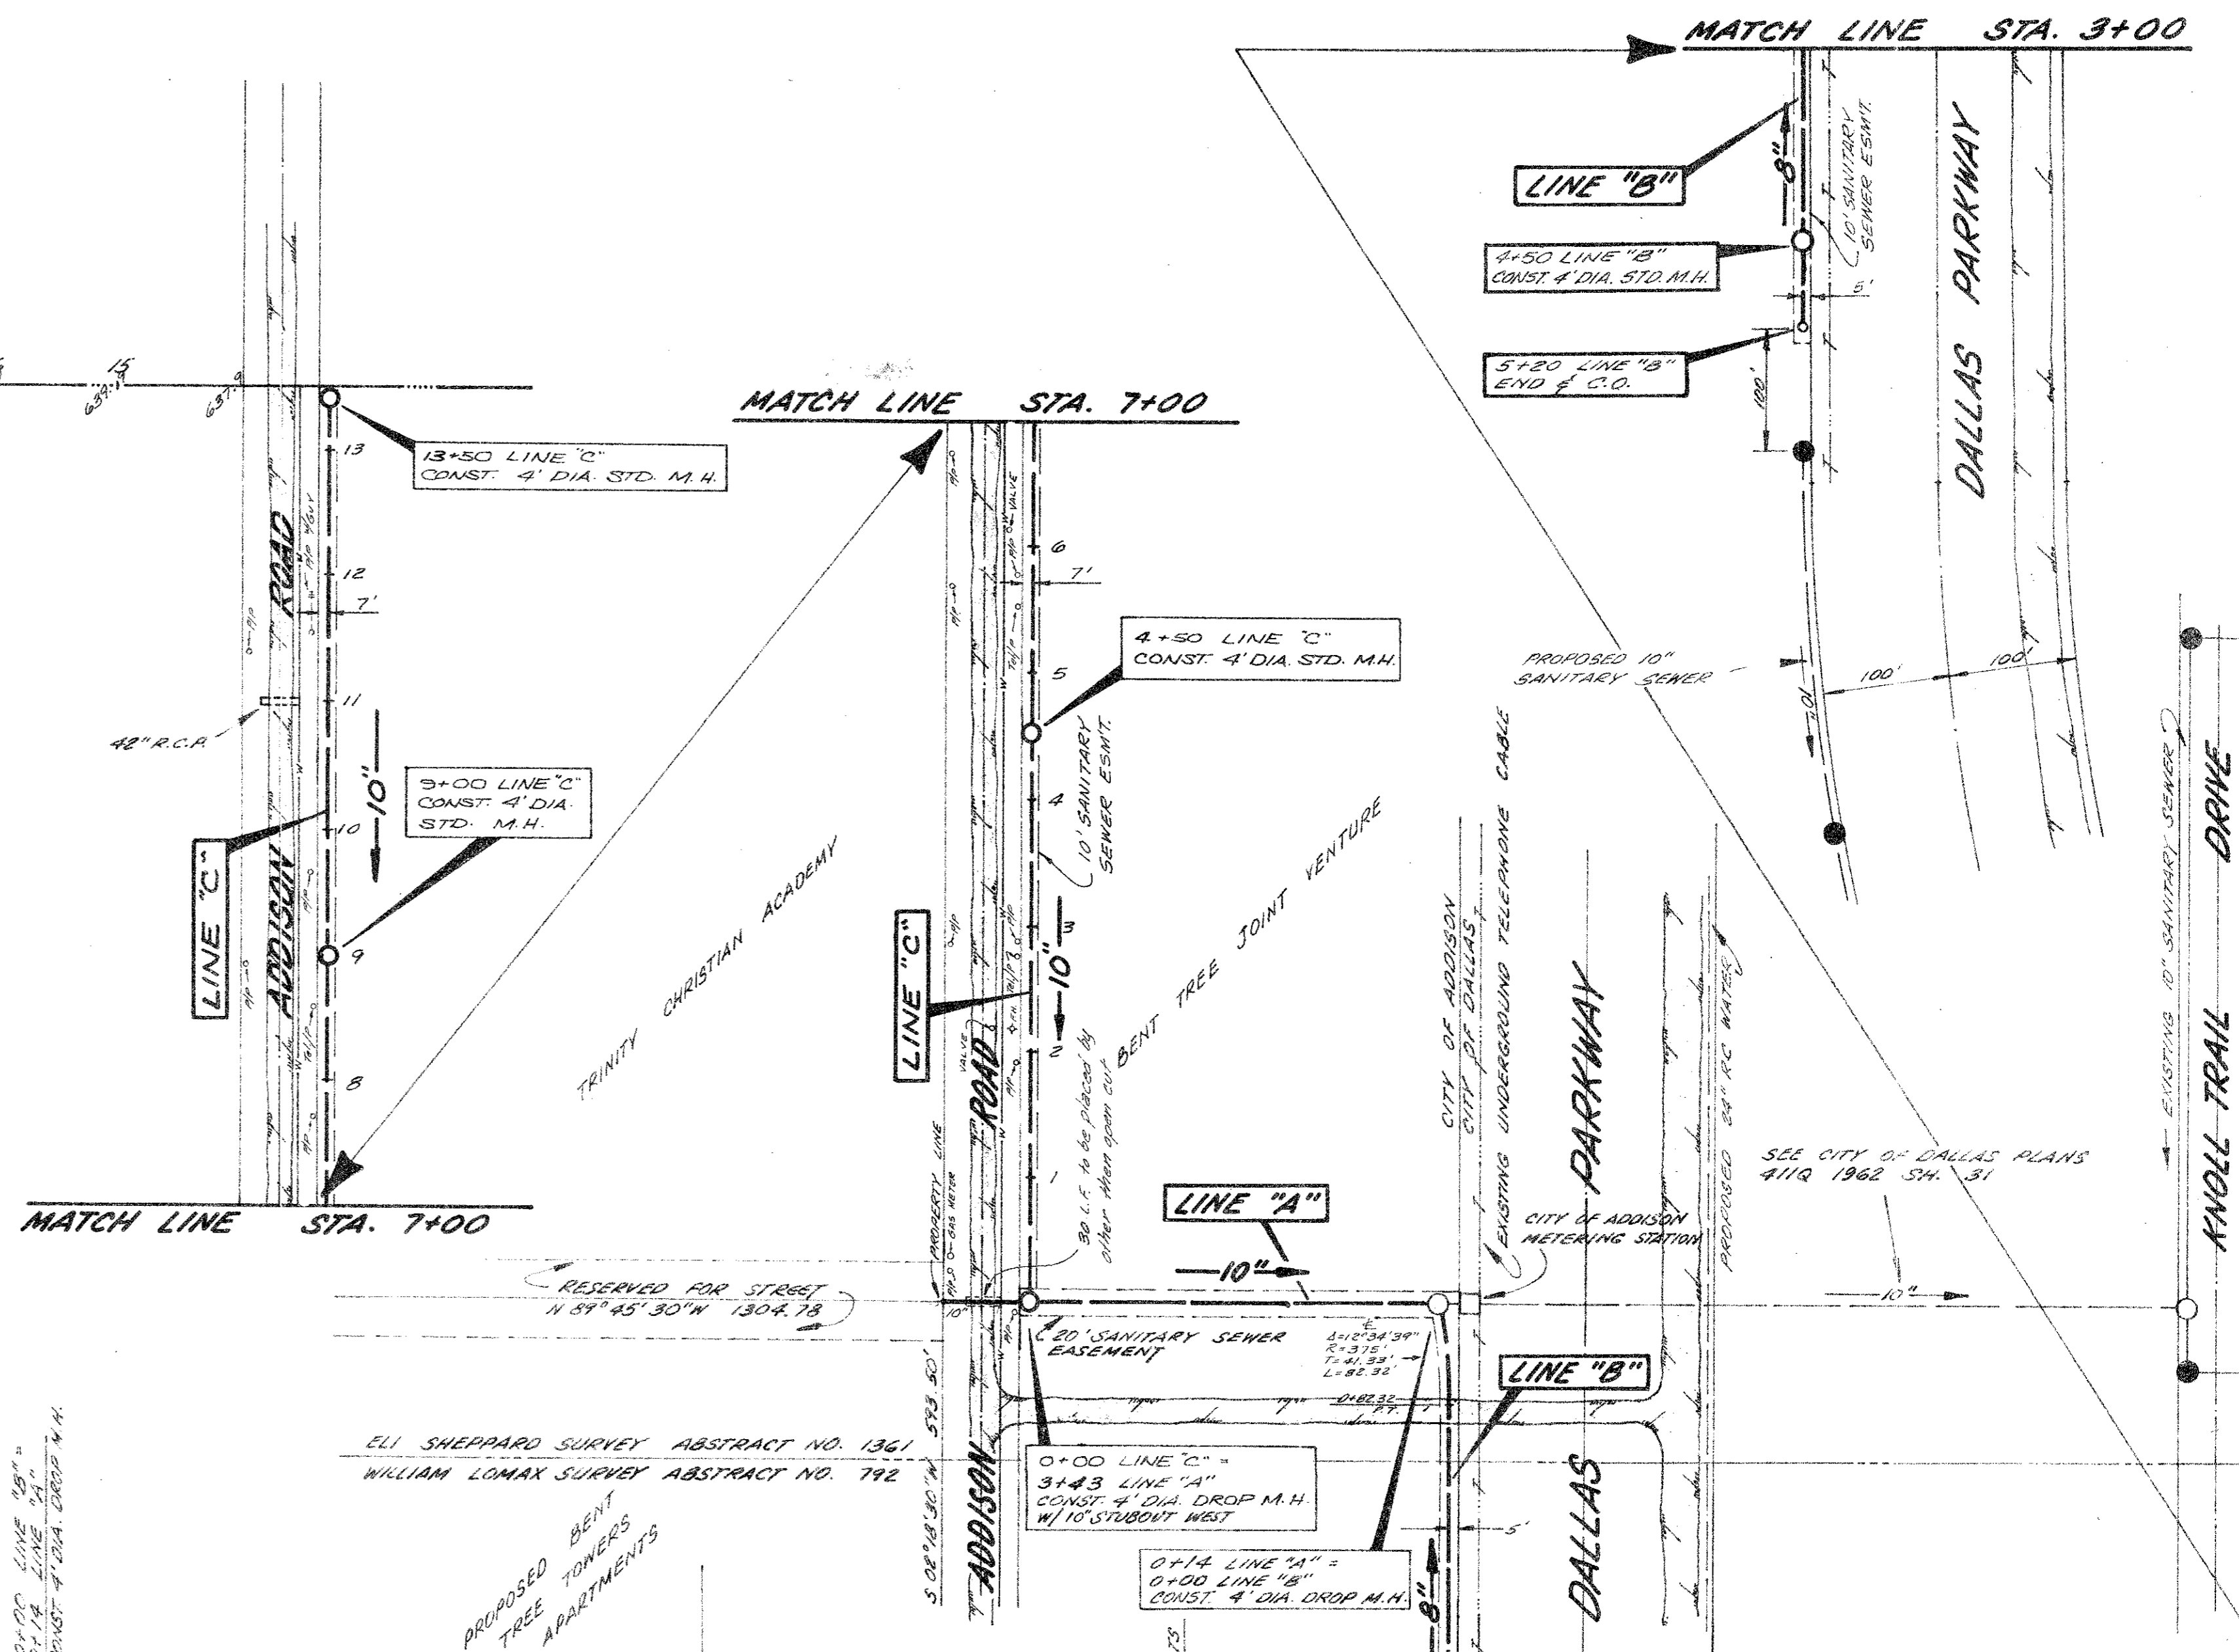

**BENCH MARK**

R.R. SPIKE IN POWER POLE POINT OF STA. 0+15 (DALLAS PARKWAY PLANS) AT THE EXTENSION OF MISSOURI DRIVE AND DALLAS PARKWAY PLAN 417.34

**NOTE:**

IT WILL BE THE CONTRACTOR'S RESPONSIBILITY TO VERIFY THE LOCATION AND TO PROTECT ALL EXISTING UTILITIES.



**CAUTION:**  
SOUTHWESTERN BELL UNDERGROUND TELEPHONE CABLES. EXISTING UNDERGROUND TELEPHONE CABLES. SEE CITY OF DALLAS PLANS 411Q 1962 SHEET 31

**AS BUILT**

**WATER & SEWER PLANS**  
 DALLAS PARKWAY TO ADDISON ROAD  
 ELI SHEPPARD SURVEY, ABSTRACT 1361  
 ADDISON WATER UTILITIES  
 CITY OF ADDISON, TEXAS

DESIGN	DRAWN	DATE	SCALE	NOTES	FILE	NO.
T.F.D.	T.O.K.	SEP '77	1" = 100' H 1" = 6' V	T.F.D.		

MAY 17, 1978

