





SCALE: 1"=100'

JACK ROUGE, W.R. SANFORD, CHRISTIAN CONCERN FOUNDATION INC., FIRST BAPTIST CHURCH OF DALLAS, W.A. CRISWELL FOUNDATION, INC.

ABSTRACT 792

R.S.F. LAND CORPORATION & OAK CLIFF SAVINGS & LOAN ASSOCIATION

SAN. SEWER CURVE DATA	
C1	D = 50° 01' 00"
	R = 1605.00'
	T = 748.71'
	L = 1401.09'

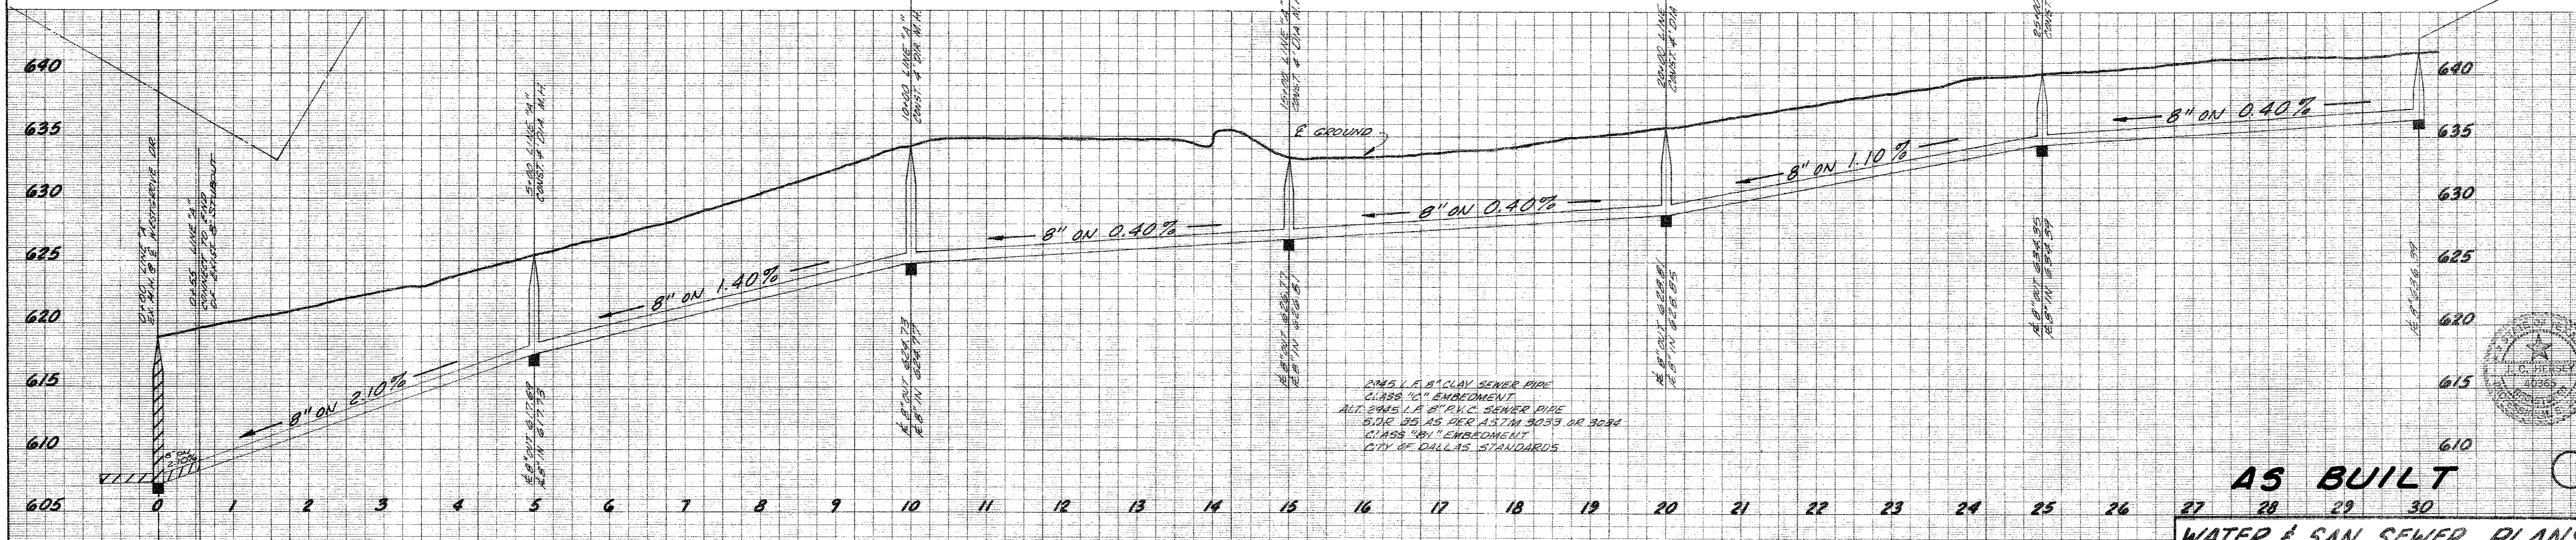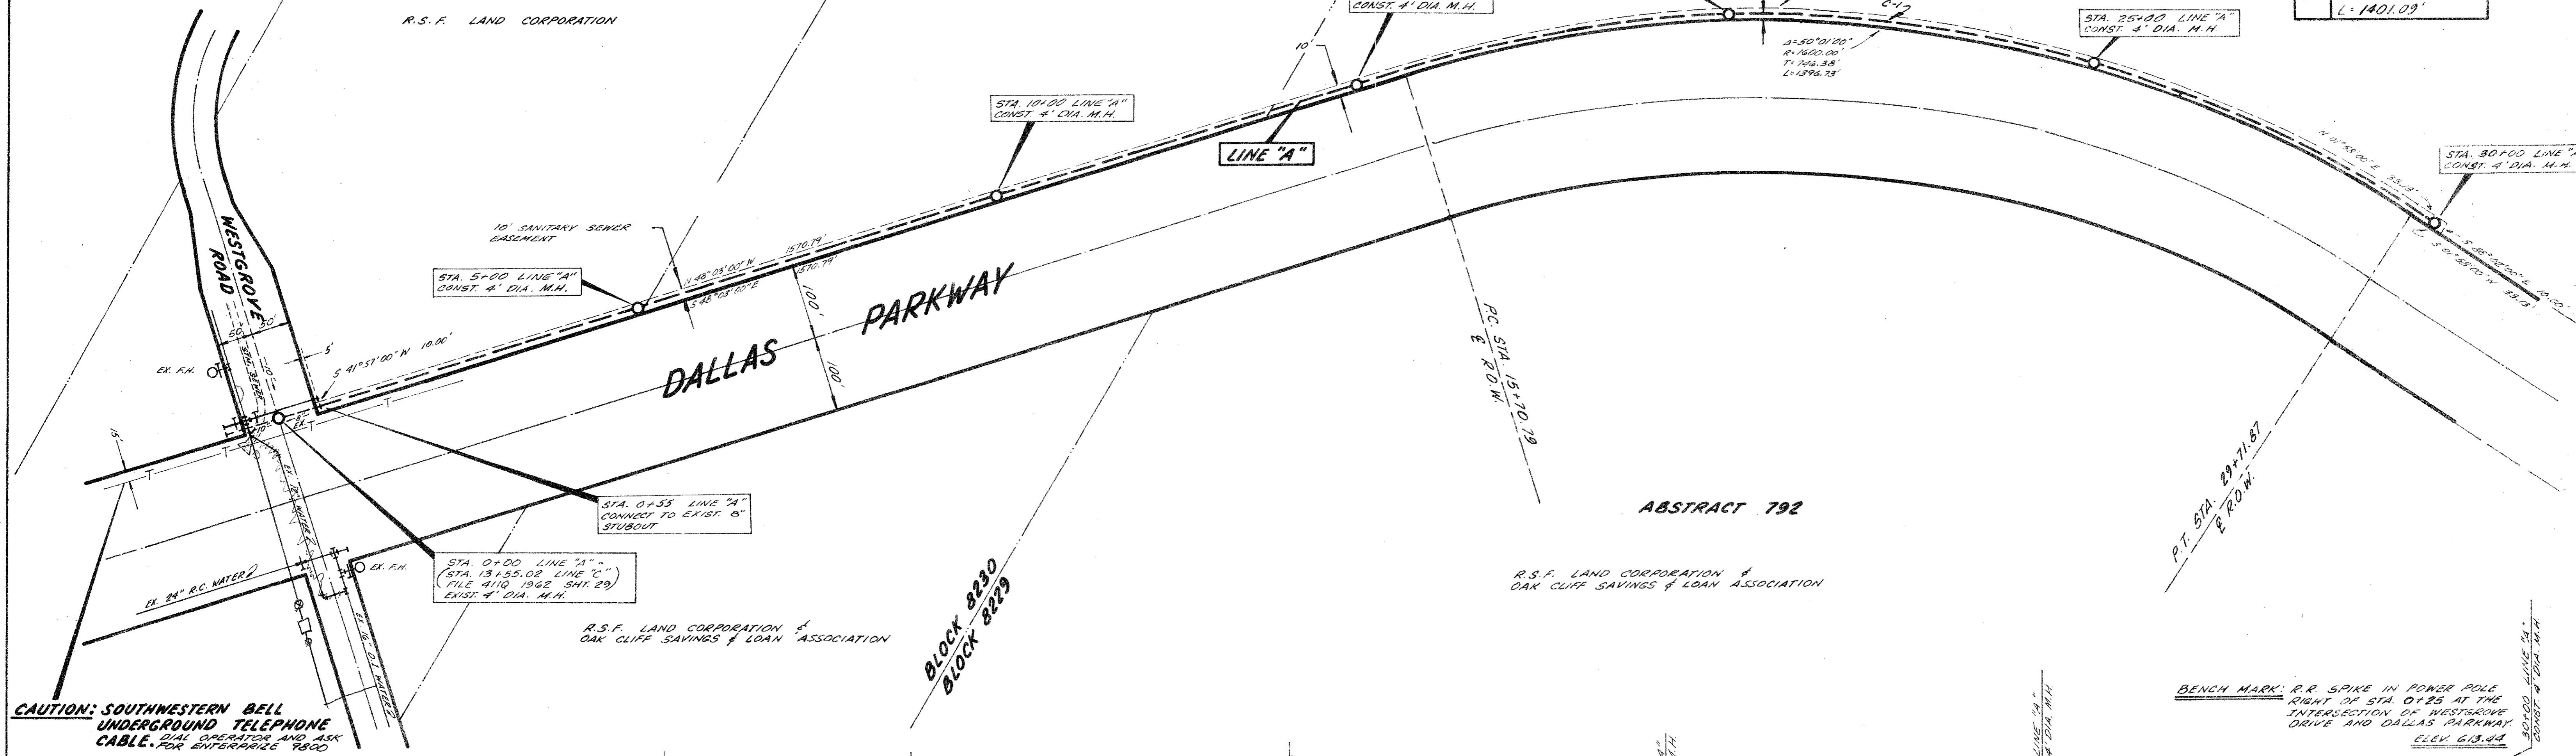

24" S. L. F. CLAY SEWER PIPE  
 CLASS "C" EMBROIDMENT  
 ALT. 24" S. L. F. R.C. SEWER PIPE  
 S.D.R. 35 AS PER A.S.T.M. 3023 OR 3024  
 CLASS "B1" EMBROIDMENT  
 CITY OF DALLAS STANDARDS

**AS BUILT**

**WATER & SAN. SEWER PLANS**

DALLAS PARKWAY  
 WESTGROVE DRIVE TO COUNTY LINE  
 ADDISON WATER UTILITIES  
 CITY OF ADDISON, TEXAS

MAY 17, 1978

DESIGN	DRAWN	DATE	SCALE	NOTES	FILE	NO.
THREADGILL-DOWNEY & ASSOCIATES		APR 77	1"=100'H 1"=6'V	T & D		

