


A.S.C. Versailles-Dallas Inc.
 30' Eas't. for Maintaining Water Main or Mains
 or Appurtenances.
 Abt. 524 Block 8164
 Vol. 82157 Pg. 2545
 C.O. Date:

WHITE Jefferson Oaks Ph II
 411Q 1960 SH. 121A-123

Station	LT	RT	Description	Station	LT	RT	Description	Station	LT	RT	Description	Station	LT	RT	Description
118+00			Asp	118+00			Asp	118+00			Asp	118+00			Asp
118+05			Asp	118+05			Asp	118+05			Asp	118+05			Asp
118+10			Asp	118+10			Asp	118+10			Asp	118+10			Asp
118+15			Asp	118+15			Asp	118+15			Asp	118+15			Asp
118+20			Asp	118+20			Asp	118+20			Asp	118+20			Asp
118+25			Asp	118+25			Asp	118+25			Asp	118+25			Asp
118+30			Asp	118+30			Asp	118+30			Asp	118+30			Asp
118+35			Asp	118+35			Asp	118+35			Asp	118+35			Asp
118+40			Asp	118+40			Asp	118+40			Asp	118+40			Asp
118+45			Asp	118+45			Asp	118+45			Asp	118+45			Asp
118+50			Asp	118+50			Asp	118+50			Asp	118+50			Asp
118+55			Asp	118+55			Asp	118+55			Asp	118+55			Asp
118+60			Asp	118+60			Asp	118+60			Asp	118+60			Asp
118+65			Asp	118+65			Asp	118+65			Asp	118+65			Asp
118+70			Asp	118+70			Asp	118+70			Asp	118+70			Asp
118+75			Asp	118+75			Asp	118+75			Asp	118+75			Asp
118+80			Asp	118+80			Asp	118+80			Asp	118+80			Asp
118+85			Asp	118+85			Asp	118+85			Asp	118+85			Asp
118+90			Asp	118+90			Asp	118+90			Asp	118+90			Asp
118+95			Asp	118+95			Asp	118+95			Asp	118+95			Asp
119+00			Asp	119+00			Asp	119+00			Asp	119+00			Asp

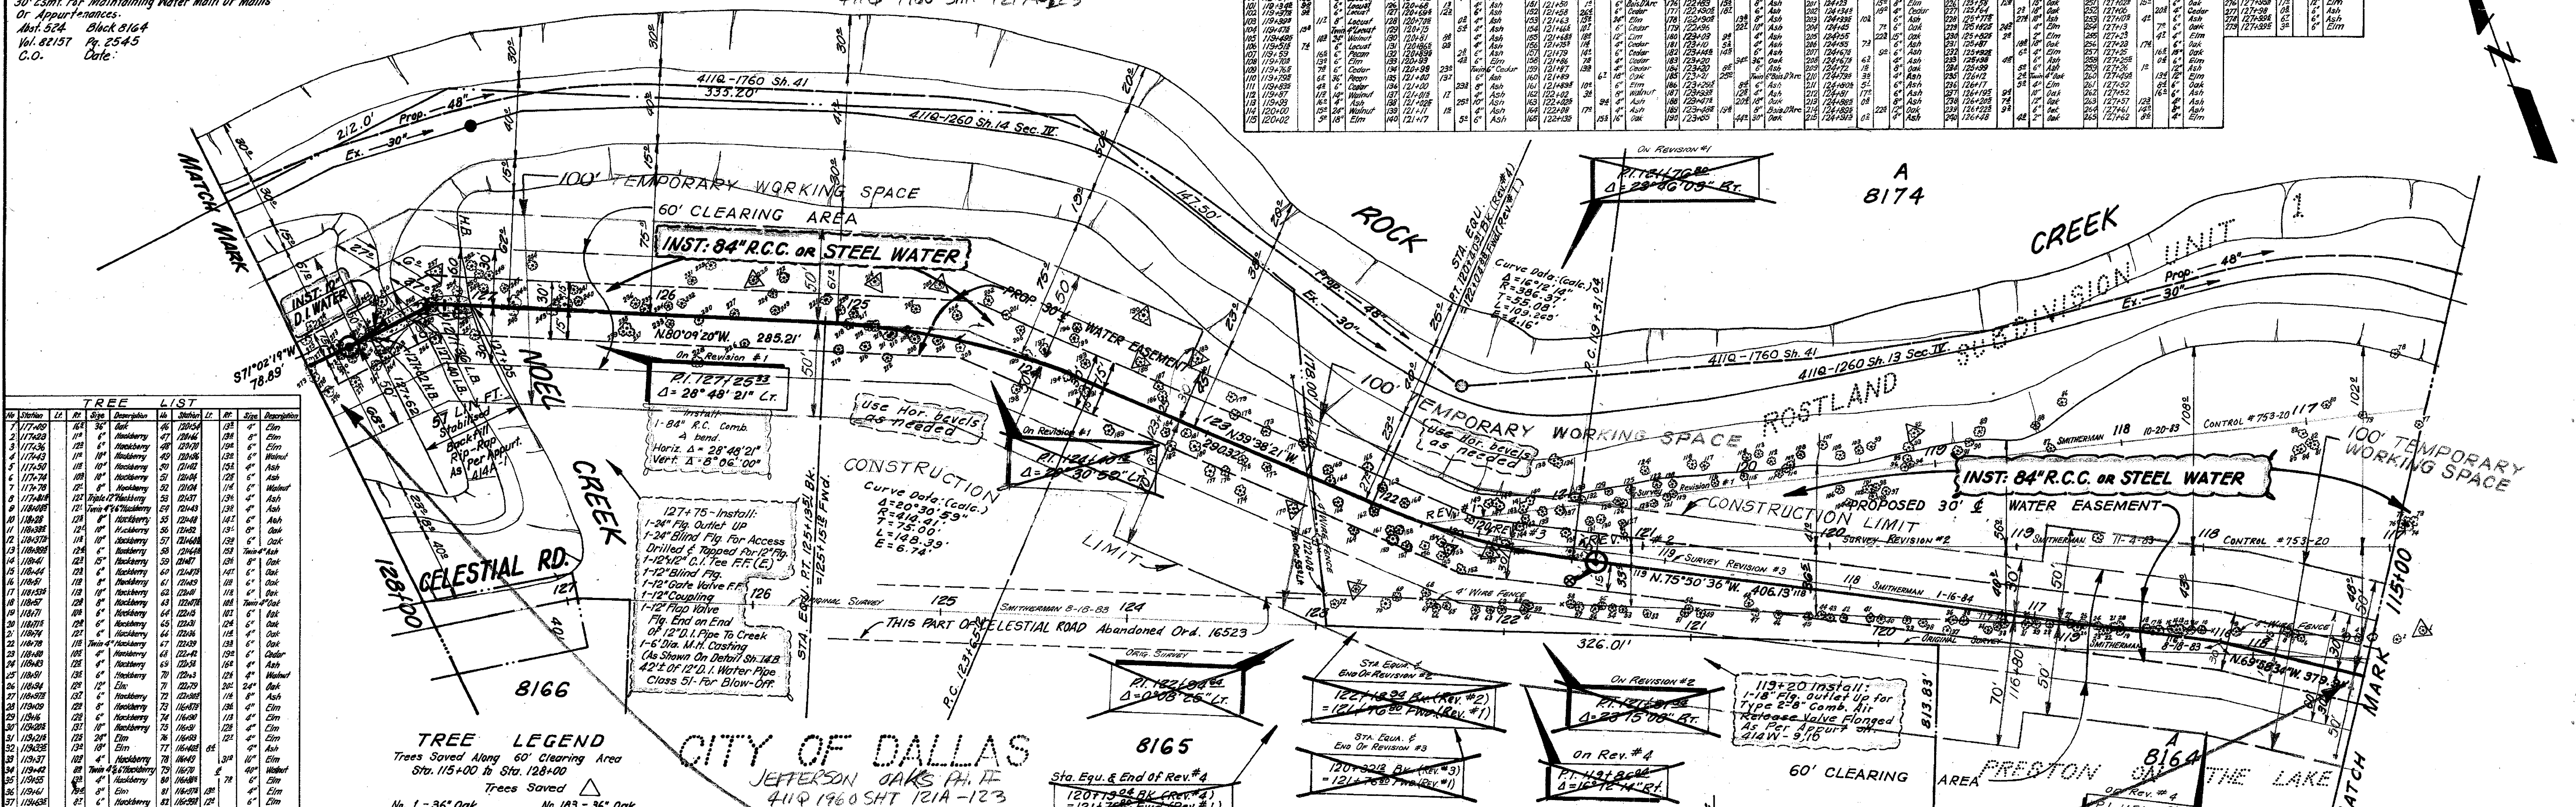


Station	LT	RT	Description	Station	LT	RT	Description
117+00			Asp	117+00			Asp
117+05			Asp	117+05			Asp
117+10			Asp	117+10			Asp
117+15			Asp	117+15			Asp
117+20			Asp	117+20			Asp
117+25			Asp	117+25			Asp
117+30			Asp	117+30			Asp
117+35			Asp	117+35			Asp
117+40			Asp	117+40			Asp
117+45			Asp	117+45			Asp
117+50			Asp	117+50			Asp
117+55			Asp	117+55			Asp
117+60			Asp	117+60			Asp
117+65			Asp	117+65			Asp
117+70			Asp	117+70			Asp
117+75			Asp	117+75			Asp
117+80			Asp	117+80			Asp
117+85			Asp	117+85			Asp
117+90			Asp	117+90			Asp
117+95			Asp	117+95			Asp
118+00			Asp	118+00			Asp


TREE LEGEND
 Trees Saved Along 60' Clearing Area
 Sta. 115+00 to Sta. 128+00

No. 1 - 36" Oak	No. 183 - 36" Oak
No. 71 - 24" Oak	No. 188 - 18" Oak
No. 92 - 36" Walnut	No. 190 - 30" Oak
No. 145 - 16" Pecan	No. 205 - 15" Oak
No. 150 - 34" Elm	No. 214 - 12" Oak
No. 153 - 24" Elm	No. 225 - 15" Oak
No. 170 - 18" Oak	No. 257 - 15" Oak

CONT. NO. 84-45

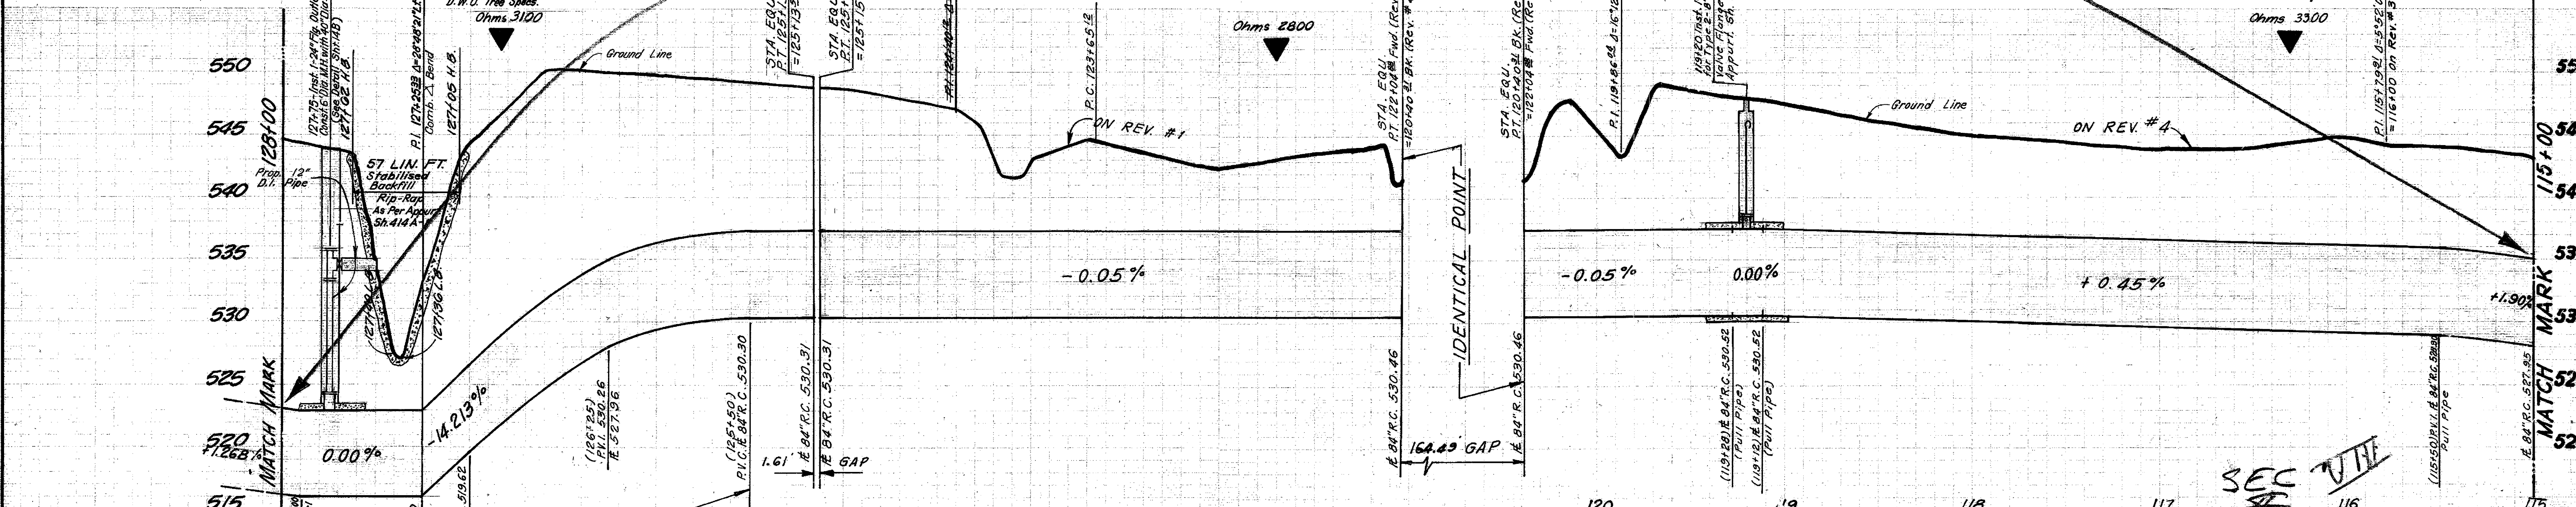

1134 LIN. FT. 84" DIA. PRESTRESSED CONCRETE EMBEDDED CYLINDER PIPE - CLASS 100
 ALTERNATE: 1134 LIN. FT. 84" DIA. STEEL PIPE (AS PER PART "T" SPECIAL SPECIFICATIONS)

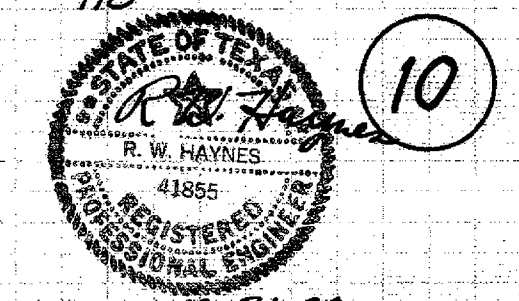

84" R.C. WATER MAIN					
Along WHITE ROCK CREEK					
From SPRING VALLEY TO DALLAS N. PKWY.					
DALLAS WATER UTILITIES DEPT.					
CITY OF DALLAS, TEXAS					
DESIGN	DRAWN	DATE	SCALE	NOTES	FILE NO.
M. RAY	M. RAY	JAN '88	1/8" = 1'-00"		085W6608

B.M. - STD. W.D.B.M. ON S.E. CORNER OF CONC. BRIDGE OF WHITE ROCK CREEK & PRESTON RD. ELEV. -554.05
 B.M. - GOD NAIL IN PIP#12N-1W-107 17 1/2" LT. STA. 131+93.3 S. SIDE OF CELESTIAL RD. & 200' E. OF WINWOOD RD. ELEV. -555.46
 T.B.M. - TOP OF I.R. @ STA. 115+54.25 OF ORIG. SURVEY. ELEV. -541.62