

61730
1.5

CITY OF ADDISON

BELT LINE

Estimate Owners: Rene Ann Julian Smith, John E. Julian Sr. & S.L. Christie (Agent for Mildred Julian Christie) - Dec. 2, 1975
15 Semi Sewer Esmt.
Parallel With N. ROW's Adjacent To Belt Line Rd. From E. ROW of Dallas Hwy. To N. ROW of Noel Rd.
Temp. Working Space Granted.
C.O. - 753736
Vol. - 78293 Pg. - 012/013 Date - Dec. 31, 1975

City of Addison - Dec. 5, 1975
Authorized Construction
of Water & Sewer Mains
to Reach Prop. Prestonwood
National Bank
C.T. Webster
A. City Administrator
Also: See Letter From County
Director of Public Works.
Dec. 1, 1975

Simons Land Co. - Acting Through
President Herman Ruppel - Nov. 25, 1975
To - Semi Sewer Esmt.
Adjacent To And Parallel With the N. ROW
of Belt Line Rd. From E. ROW of Noel Rd.
East To End of Esmt. 53.
Temp. Working Space Granted.
C.O. - 753736
Vol. - 78293 Pg. - 014/013 Date - Dec. 31, 1975

ABSTRACT 1580
CITY OF DALLAS
BLK. 8222
CITY OF DALLAS

PROP. 54" R.C.P. RELOCATION (DUE TO DALLAS N. TOLLWAY EXTENSION) SEE 411Q 1909 A SH 16

Prestonwood National Bank
Note! Polyethylene Wrap to be Used on all Prop. D.I. Water Pipe, D.I. Fittings and Fire Hydrant Bases.

CITY OF DALLAS Ordinance No. 15119, March 1, 1976
HOCKADAY SCHOOL, INC.

INSTALL 54" R.C. WATER MAIN

28'-80" INSTALL:
1-16" F.L.G. OUTLET (NORTH).
1-16" VALVE, H.E.

INSTALL:
1-16" X 8" ECCENTRIC REDUCERS.
1-48" W.O.R.Z. GATE VALVE, H.E.
WITH 5" DIA. M.H. OVER GEARS AS PER APPURT. 414D-II.

CONTRACT NO. 61-45


NOTE!!
ALL R.C. FLANGE OUTLET CONNECTIONS ON CONCRETE PRESSURE PIPES MADE TO C.I. FLANGE FITTINGS, SHALL BE INSULATED, AS SHOWN ON APPURT. SHEET 414D-II

C.B.K. 2453 Pg. 31, 32
C.B.K. 2481 Pg. 11
F.B.K. 287 Pg. 59, 60
F.B.K. 321 Pg. 9
F.B.K. 306 Pg. 43

Semi Sewer Survey Along N. Side of Belt Line Rd. From Noel Rd. West. Control # 571-13

TEMP BENCH MARK:
R.R. Spike in pole at S.W. corner of Belt Line Rd. and Noel Rd. ELEV. 626.77

NOTE! BORINGS BY:
MASON-JOHNSTON & ASSOCIATES.
BORING B-5 DRY AT 24" HR.
WATER CHECK. 30 Nov, 1960.

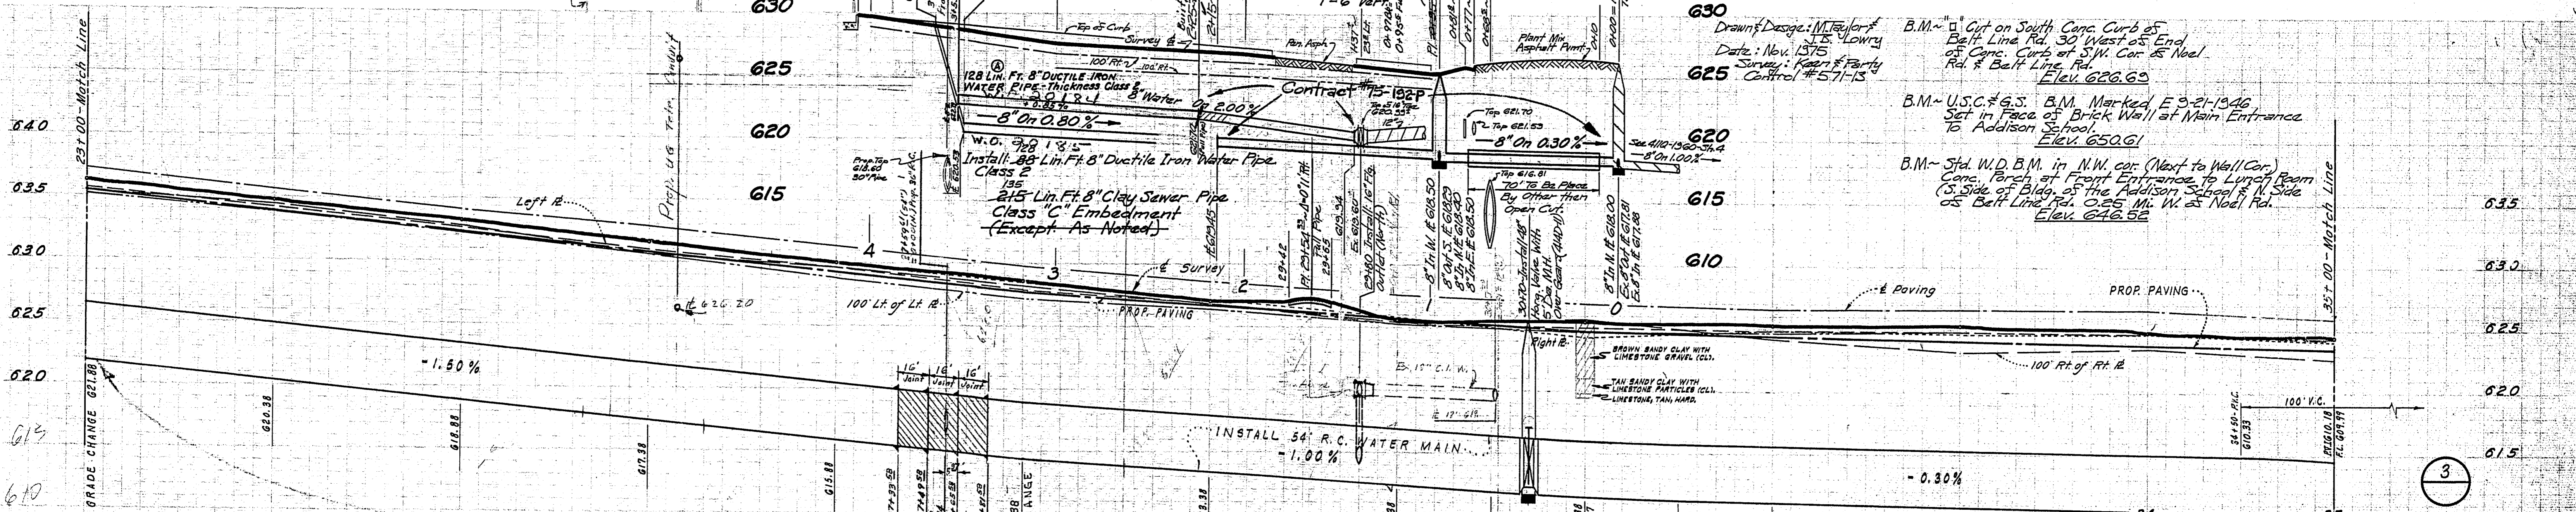

1200 LIN. FT. OF 8" DOUBLE-WRAP PRETENSIONED CONC. CYLINDER PIPE CLASS 125 OR 1200 LIN. FT. OF 8" PRESTRESSED REINFORCED CONC. EMBEDDED CYLINDER PIPE CLASS 125 CLASS 3 EMBEDMENT

CONTRACT NO. 61-45

ROW Approved by [Signature] Date - 12/23/75
C.L. Moon, Inc. Engineers
Designed by [Signature] Date - 12-23-75
Engineer of Design - Dallas City Waterworks
Contract No. - 75-192-P - Welch Const. Co. 12-75
Approved by [Signature] Date - July 8, 1976
Engineer of Design - Dallas City Waterworks

Designed by: [Signature]
C.L. Moon, Inc. Engineers
Approved by: [Signature]
Engineer of Design - Dallas City Waterworks

54" R.C. WATER MAIN
IN BELT LINE ROAD
FROM INWOOD RD. TO DULUS RD.
DALLAS CITY WATERWORKS
CITY OF DALLAS, TEXAS

DESIGN	DRAWN	DATE	SCALE	NOTES	FILE
C.L. Moon Engineers	D.P.	May '80	H: 1/240 V: 1/48	Standard	685-W-60

3