


PRESTON RD. (STATE H.W. NO. 289)

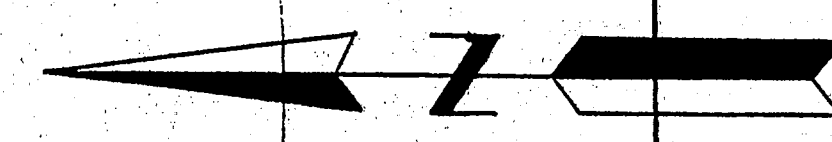

411Q1951  
Sh 28

8174

SHEET 16

WHITE ROCK CREEK  
8173

WINNWOOD RD.

CONT. NO. 66-208

SHEET 15

235+162 White Rock =  
0400 MS Kamy Const.  
Type 5" Manhole With  
10" Stubout S.E.

214+25 Const. Type  
5" Manhole With 10"  
Stubout N.W. & 12"  
Stubout S.E.

224+30 Const. Type  
5" Manhole With 10"  
Stubout S.E.

P.I. 7+14 Const.  
Type 5" Manhole  
With 8" Stubout N. &  
10" Stubout S.

Rt. 237+27 White Rock =  
0100 Addison Br.  
Const. Type 5" MANHOLE

P.C. 17+62 Const.  
Type 5" Manhole  
With 10" Stubout  
West.

CITY CONTRACT NO. 66-68  
WHITE ROCK CREEK TRUNK SEWER  
FROM STA. 12+60 TO STA. 23+129.4  
ADDISON BRANCH SEWER  
FROM STA. 0+00 TO STA. 21+00

Paid on MS 36104 B to C D E F G @ 290.41 1825.13

ESTIMATED COST  
A - B 5,567. FT. @ \$21.00 = \$120,907.00  
REVISED 3-4-68

PRO RATA COST  
D - C 1782.63 FT. @ \$21.30 = \$38,169.83  
E - D 2100.09 FT. @ \$21.30 = \$44,741.90  
F - E 2084.00 FT. @ \$23.00 = \$47,932.00  
G - F 2709.00 FT. @ \$14.50 = \$39,280.50

RUSSELL T. COOK  
3-4-68  
D to E is Paid  
Lynn A. GIBBLEMAN  
3-4-68

TRUNK SANITARY SEWER  
WHITE ROCK CREEK  
SECTION IV  
DALLAS CITY WATERWORKS  
CITY OF DALLAS, TEXAS

SCALE NOTED FILE NO.  
HUT-200 FOLDER 411Q 12