


LOT CORNER COORDINATES

#	Y	X
49	1416.196	2697.396
50	1416.196	2399.684
54	1416.196	2272.684
56	1416.196	2008.133
59	1543.196	2399.684
60	1747.419	2399.684
61	1543.196	2583.245
62	1385.925	2722.604

Prestonwood Pond II
 AIR 1960 Sh. 92, 93
 ABST. 191
 CITY OF ADDISON

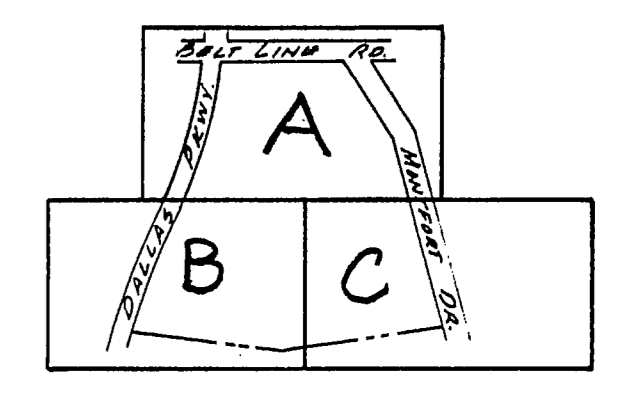

MARY T. MENTIRE KNIGHT
 5,000 ACRES
 VOL. 76010 PAGE 12
 DATE: 1-15-74

Prestonwood Junction
 411A 1960 Sh. 47, 48

MARY T. MENTIRE KNIGHT
 VOL. 7124 PAGE 155

STA. 5+50
 INSTALL:
 1-12" 45° TEE
 1-12" VALVE
 1-6" VALVE
 1-FIRE HYDRANT

STA. 7+35.8
 INSTALL:
 1-12" 22 1/2° BEND
 REMOVE & REPLACE ASPHALT PAVEMENT

Note: FOR GENERAL NOTES SEE SHEETS 6 FOR SANITARY SEWER PROFILES SEE SHEET 7 FOR ELECTRICAL NOTES SEE SHEET 8 FOR FISHING MOUNTFORD DRIVE

34

FOR WATER RELOCATION
 SEE 411Q-1909 A SH. 15

BENCHMARK: STANDARD WATER DEPT. BENCHMARK CENTER INLET NORTHWEST CORNER BELT LINE ROAD AND DALLAS PKWY. ELEV. 632.08

LOCATION: VILLAGE ON THE PARKWAY - PHASE I
 DESIGNED: ALBERT H. HALFF ASSOCIATES, INC. - ENGINEERS
 DATE: 1-19-79
 ENGINEER OF DESIGN: DALLAS WATER UTILITIES DEPT.
 CONTRACT NO. 78-2619, 78-2622 STIMMONS & SEPT. 25, 1978

LOCATION: VILLAGE ON THE PARKWAY - PHASE I
 DESIGNED: ALBERT H. HALFF ASSOCIATES, INC. - ENGINEERS
 DATE: 1-19-79
 ENGINEER OF DESIGN: DALLAS WATER UTILITIES DEPT.
 CONTRACT NO. 78-2619, 78-2622 STIMMONS & SEPT. 25, 1978

WATER & SANITARY SEWER PLANS						
VILLAGE ON THE PARKWAY						
VILLAGE PARKWAY VENTURE						
ALBERT H. HALFF ASSOCIATES, INC. - ENGINEERS						
CITY OF ADDISON, TEXAS						
DESIGN	DRAWN	DATE	SCALE	NOTES	FILE	NO.
AHH	T.P.	MAY 1978	1"=40'	6143	411Q	1960

REVISIONS:
 1. 1/31/79 CHANGED 8" WATER MAIN TO 12" MAIN BETWEEN LOT B & C, CHANGED FIRE HYDRANT AND SERVICE LINE LOCATIONS.
 2. CHANGED 8" WATER SERVICE FOR LOT B 05' EAST