
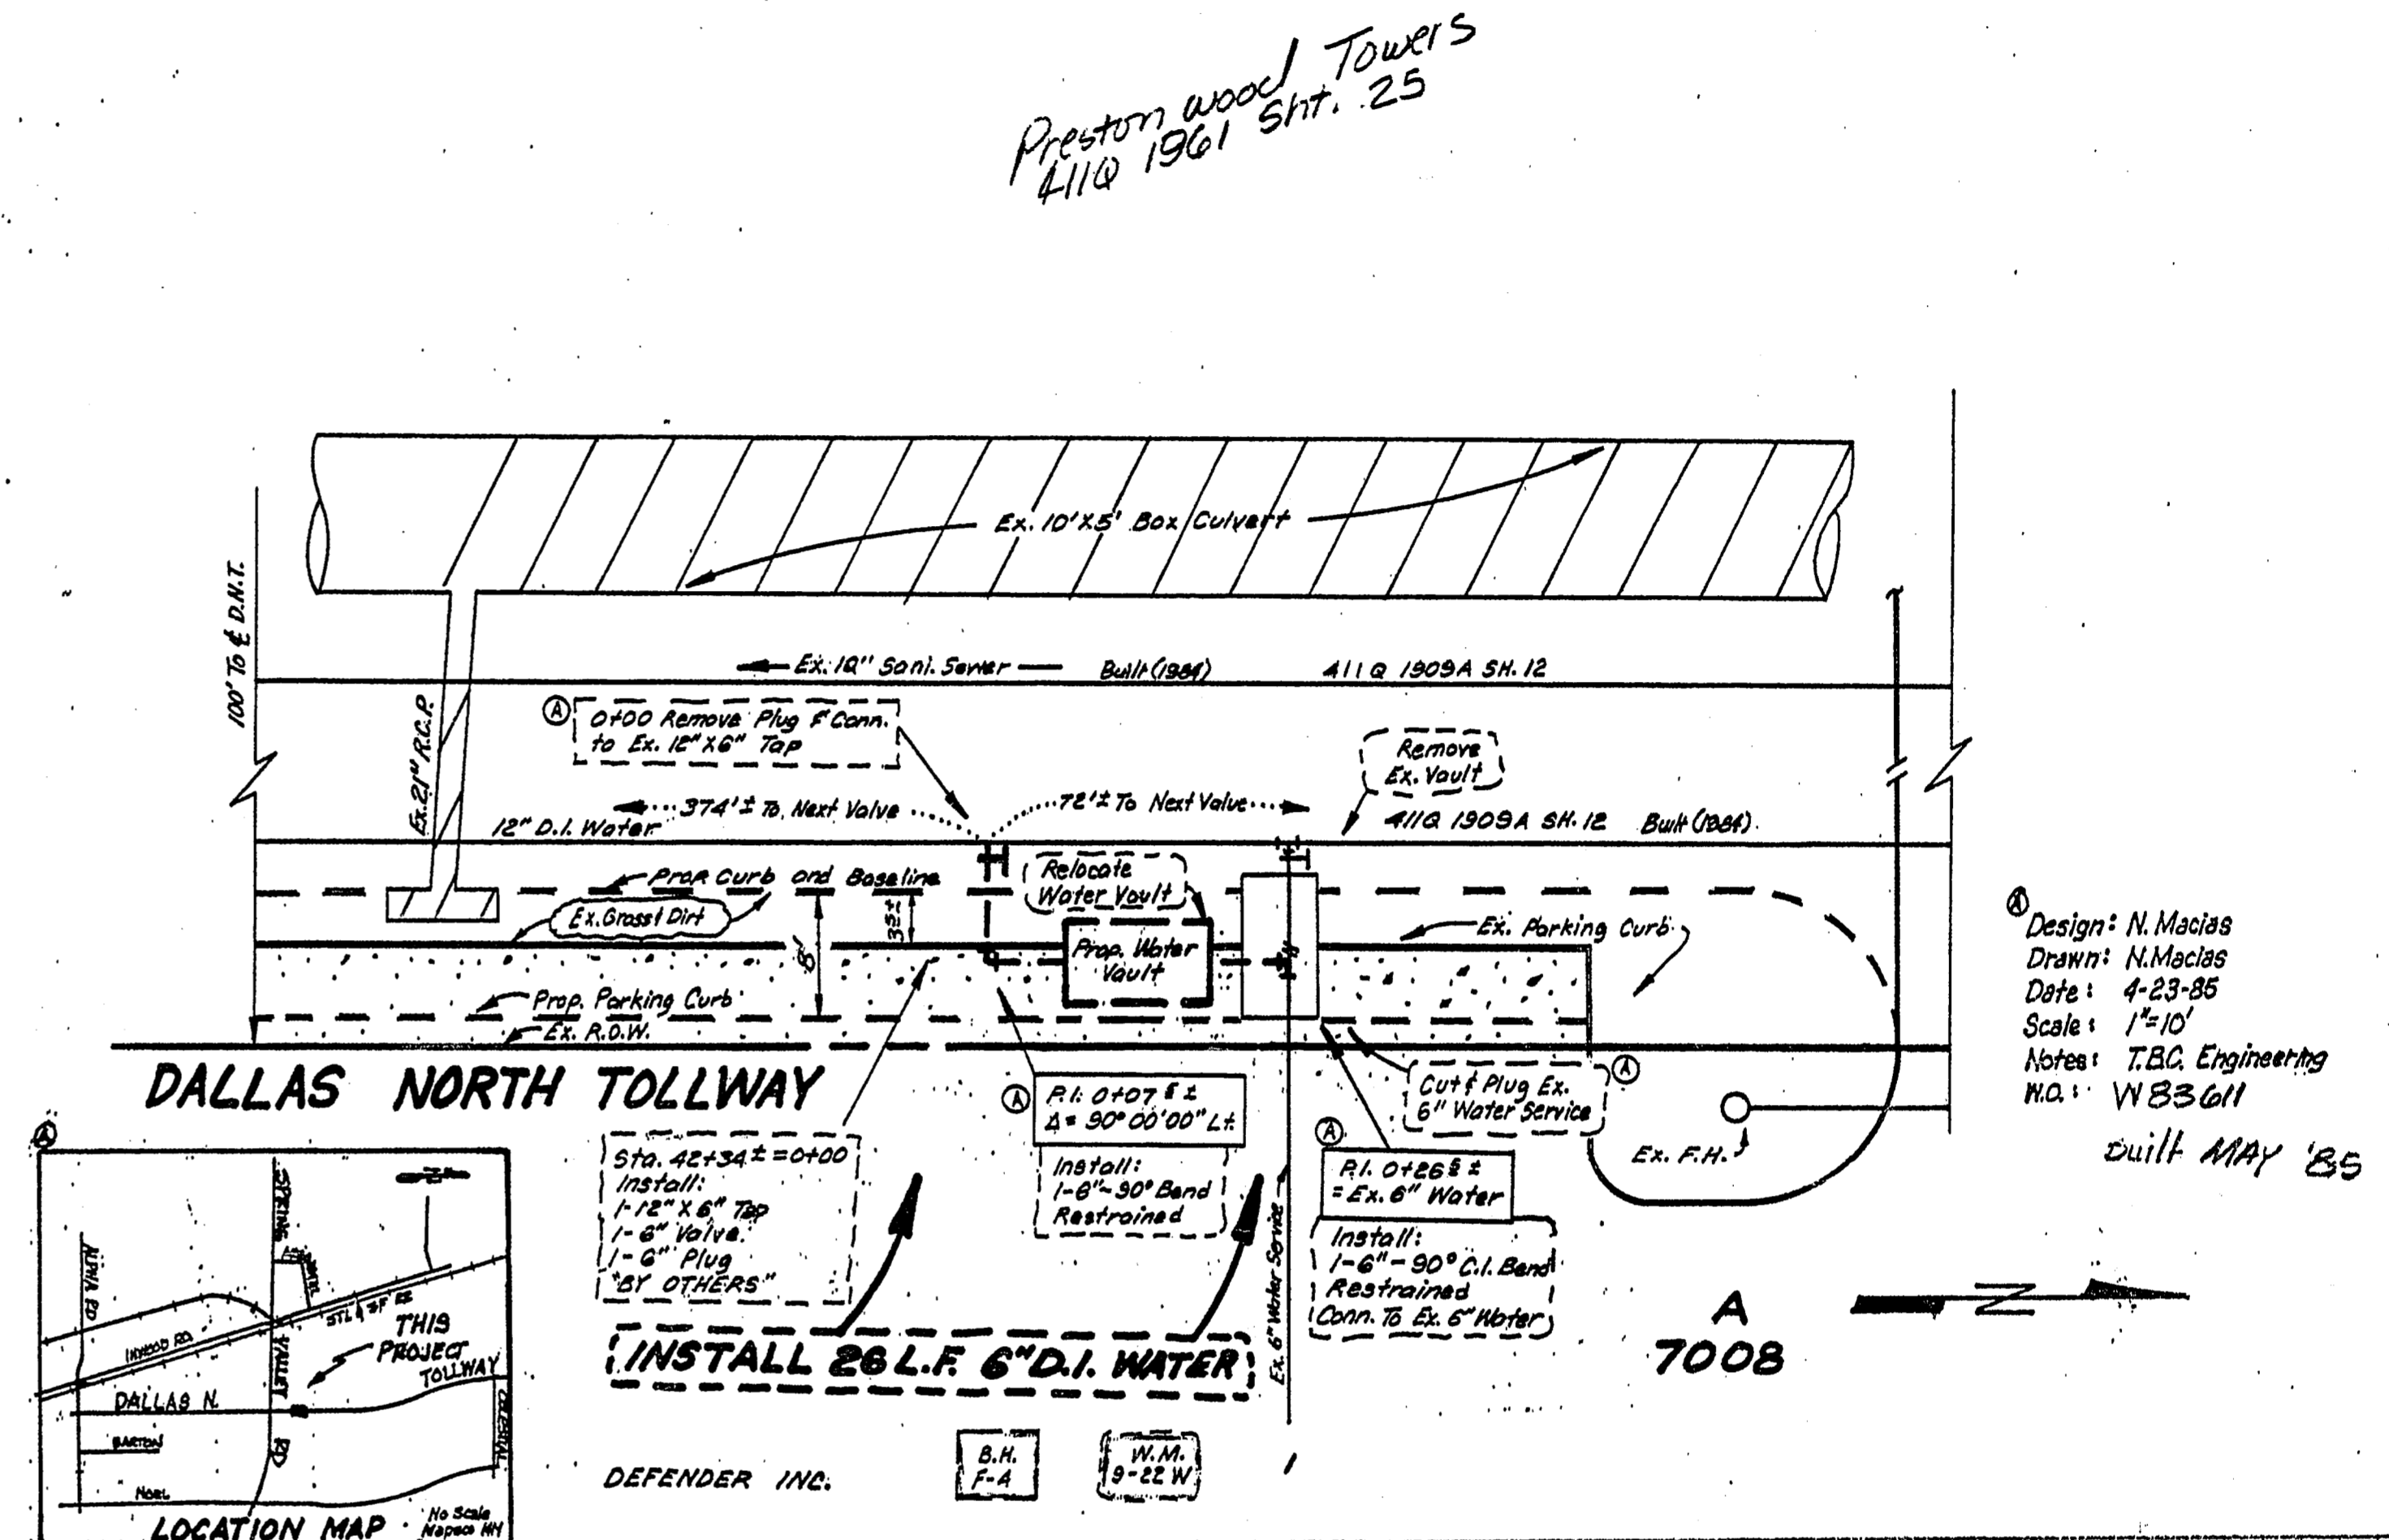
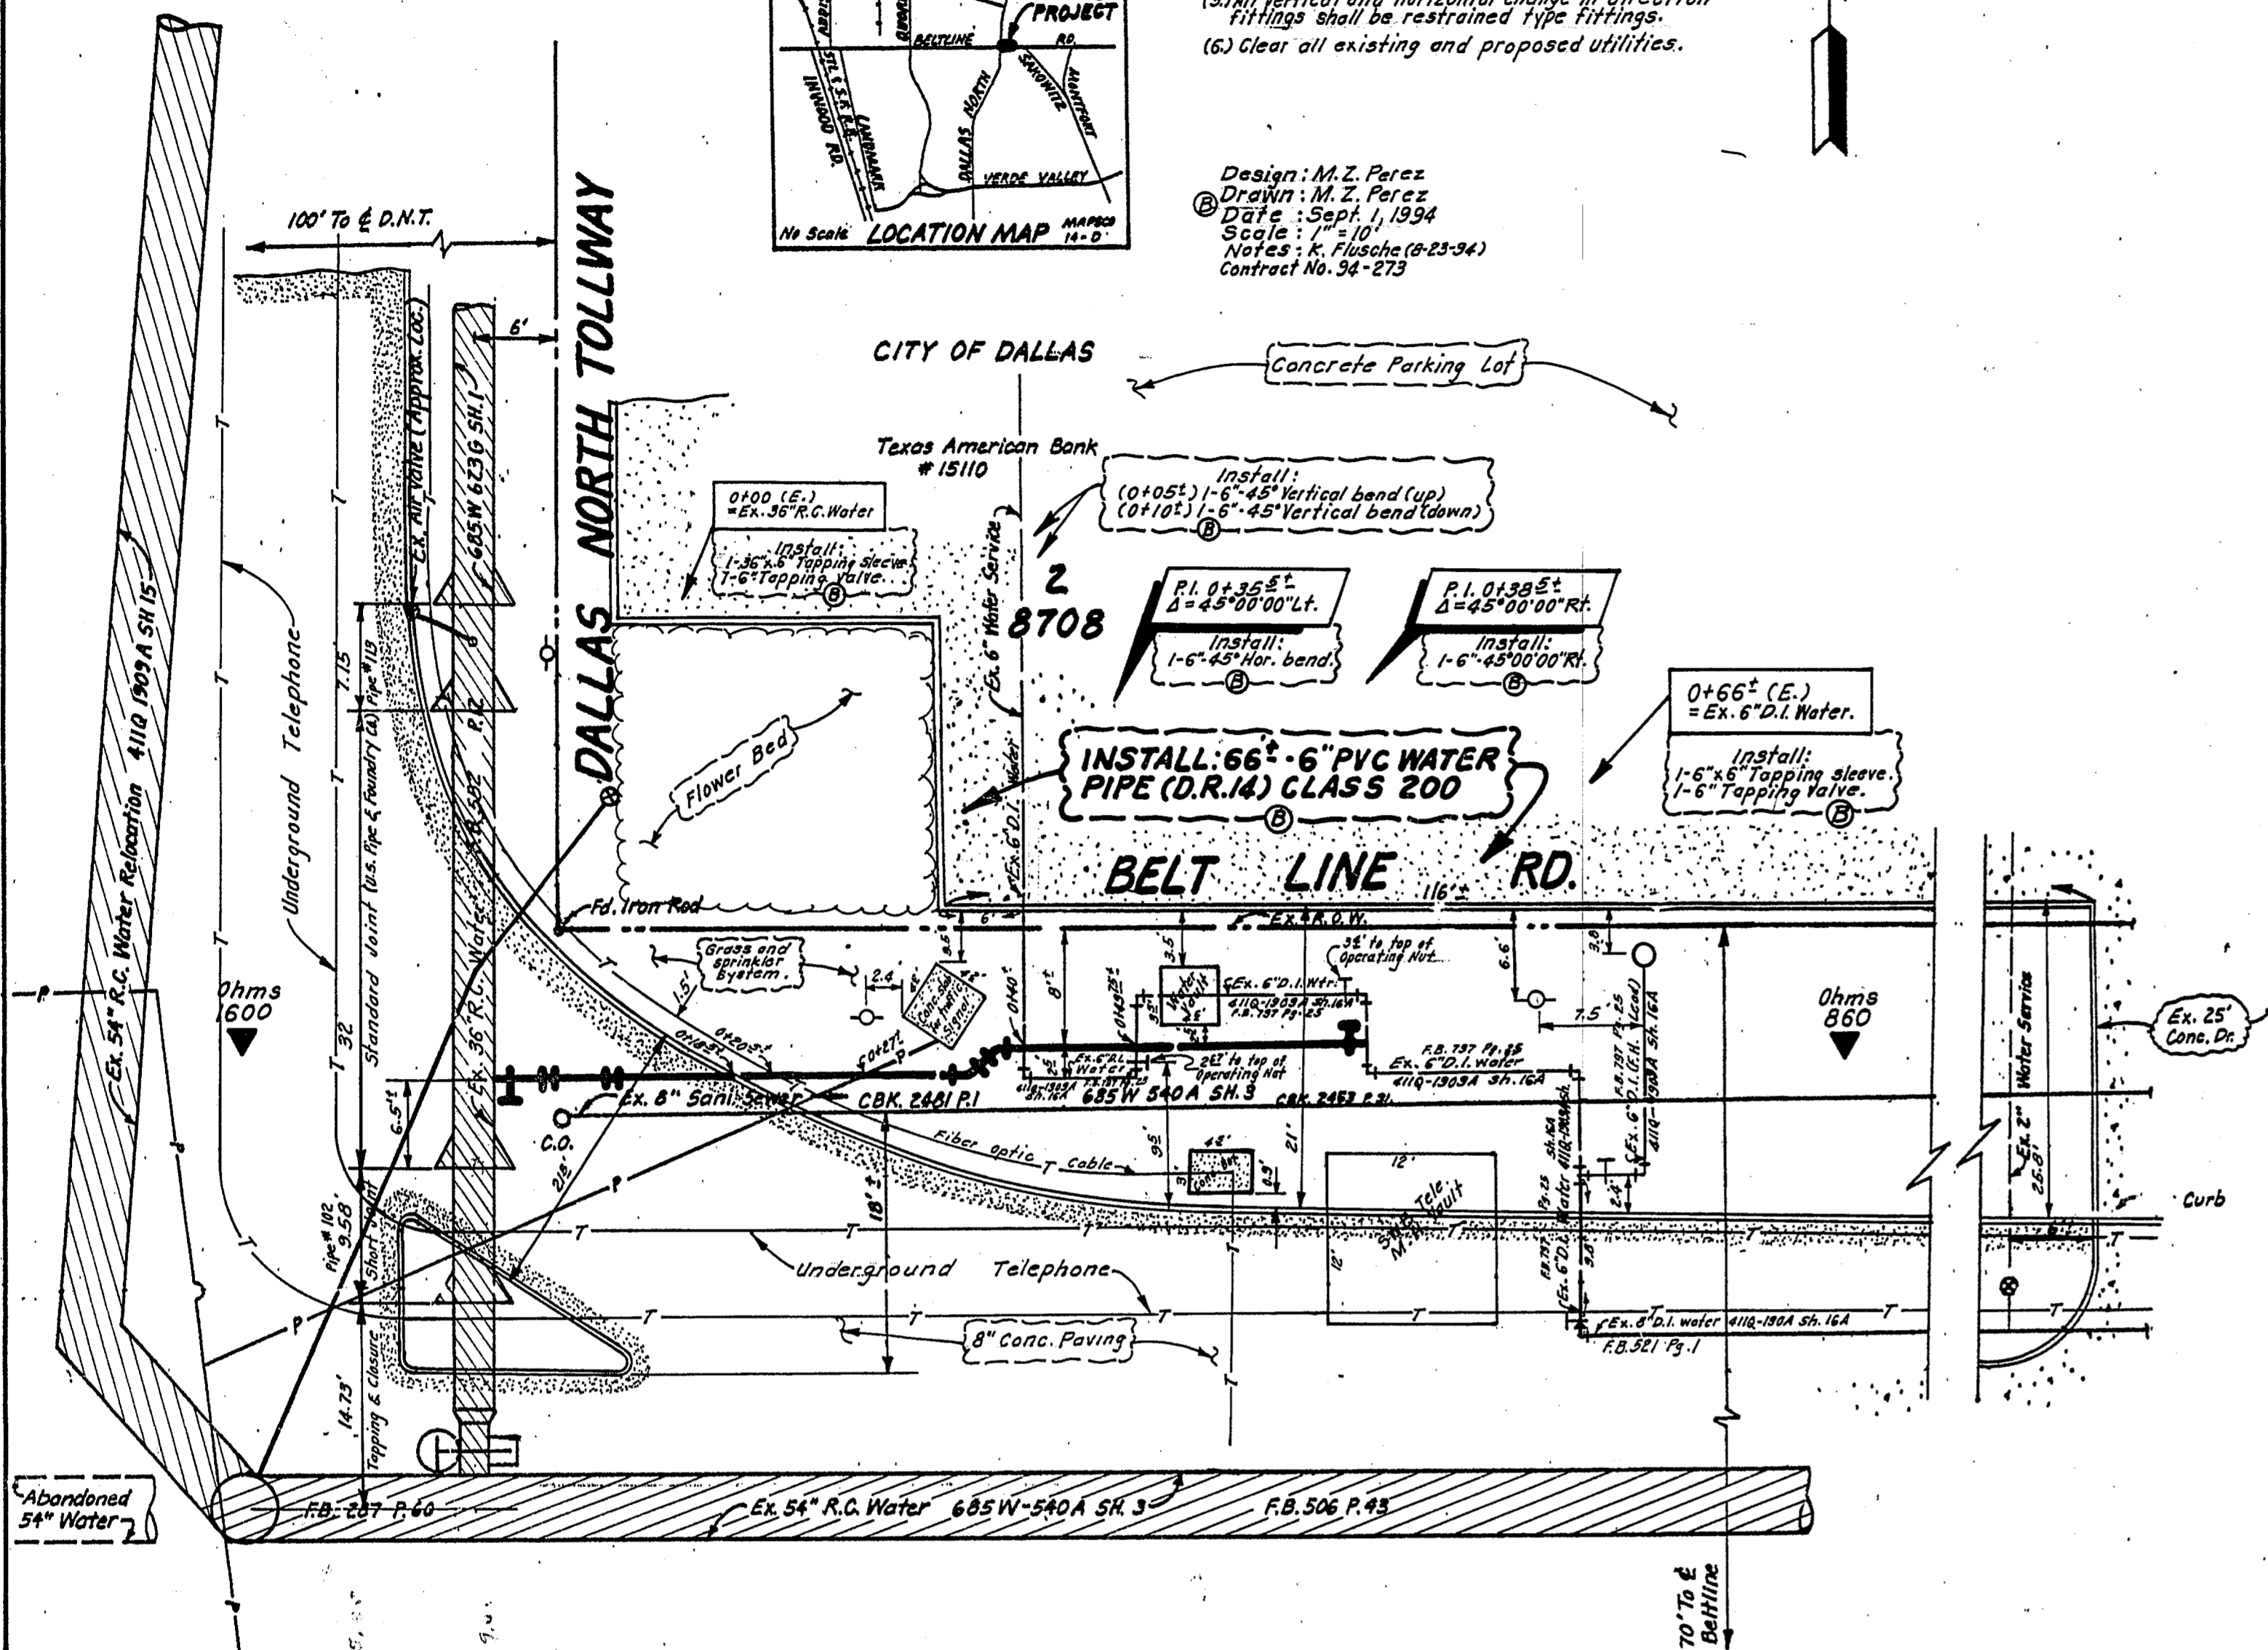


GENERAL NOTES:

- (1) All 6" & 8" water mains to be PVC D.R.14 class 200, with polyethylene wrap on fittings and fire hydrant bases.
- (2) All water mains (with no profile) shall have a minimum cover as follows: 6" & 8" - 48" below finished street grade or 60" depth in unimproved streets or as required to clear other utilities.
- (3) Soil resistivity ranges from 860 ohms to 1600 ohms.
- (4) Compact fittings are not authorized.
- (5) All vertical and horizontal change in direction fittings shall be restrained type fittings.
- (6) Clear all existing and proposed utilities.

Design: M.Z. Perez
 Drawn: M.Z. Perez
 Date: Sept. 1, 1994
 Scale: 1"=10'
 Notes: K. Flusche (0-23-94)
 Contract No. 94-273

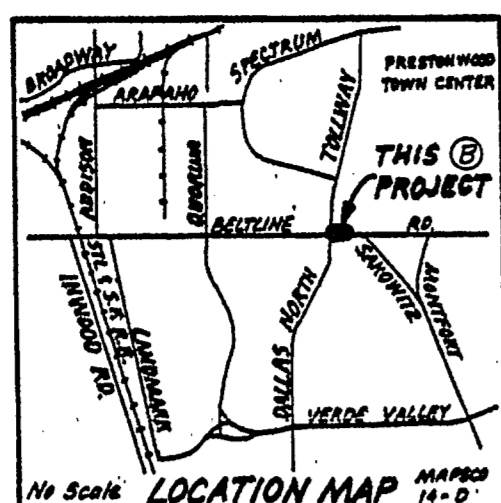

Design: N. Macias
 Drawn: N. Macias
 Date: 4-23-85
 Scale: 1"=10'
 Notes: TBC Engineering
 M.O.: W83 G11
 Built MAY '85

A 7008

**VARIOUS WATER RELOCATIONS
 IN BELT LINE ROAD
 AT DALLAS NORTH TOLLWAY
 WATER UTILITIES DEPARTMENT
 CITY OF DALLAS, TEXAS**

16B

DESIGN	DRAWN	DATE	SCALE	NOTES	FILE	NO.
NOTED	NOTED	NOTED	1"=10'	Turner Cullen Bryson	411Q	1909A