


ROOM SCHEDULE	
RM NO	ROOM NAME
G1	LOBBY
G2	ELEVATOR MACHINE ROOM
G3	STAIR PRESSURIZATION
L1	UNASSIGNED
L2	CABLE CHASE
L3	VESTIBULE
M1	ELECTRICAL EQUIPMENT
M2	CABLE CHASE
M3	VESTIBULE
T1	ELECTRONIC EQUIPMENT
T2	CABLE CHASE
T3	VESTIBULE
J1	CORRIDOR
J2	CABLE CHASE
J3	RESTROOM
J4	VESTIBULE
S1	STAIR

- NOTES:**
- REFERENCE SHEET A024 FOR PARTITION TYPES.
 - REFERENCE SHEETS A017 AND A019 FOR ROOM FINISH SCHEDULES AND DOOR SCHEDULE.
 - REFERENCE SHEET G003 FOR ABBREVIATIONS.
 - REFERENCE STRUCTURAL DRAWINGS FOR SIZE AND LOCATION OF FLOOR OPENINGS.
 - PROVIDE 1 HOUR INTUMESCENT FIREPROOFING AT ALL STRUCTURAL STEEL AT TOWER. APPLY DECORATIVE TOPCOAT WHERE STEEL IS EXPOSED TO VIEW. PROVIDE 1 HOUR CEMENTITIOUS FIREPROOFING AT ALL METAL DECKING AT TOWER. RESTORE ANY FIREPROOFING DAMAGED DURING CONSTRUCTION AT NO ADDITIONAL COST TO THE GOVERNMENT.
 - SEAL ALL JOINTS AND PENETRATIONS THRU CHASE WALLS TO PREVENT AIR LEAKAGE, TYPICAL AT ALL LEVELS. SEE MECH SPECS FOR PRESSURE REQUIREMENTS.

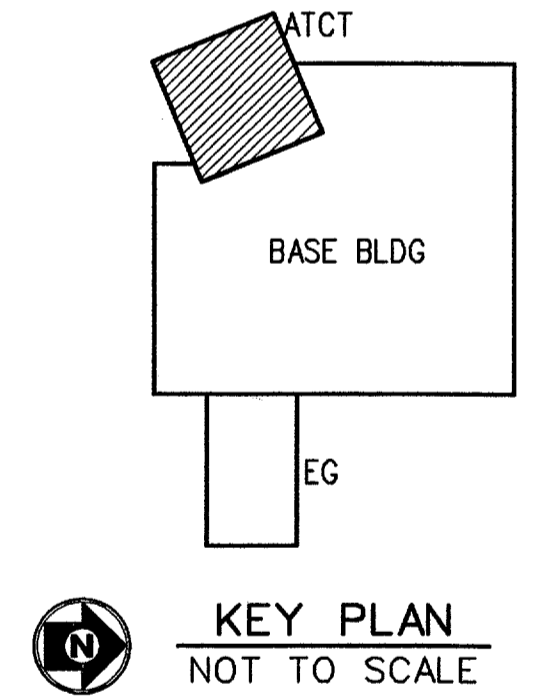

A 06-23-03		FAA REDESIGN OF HVAC, JON 21874.	9700164	06-23-03
REV	DATE	DESCRIPTION	JCN	REDLINE DATE
DEPARTMENT OF TRANSPORTATION FEDERAL AVIATION ADMINISTRATION FORT WORTH IMPLEMENTATION CENTER FORT WORTH, TX LOW ACTIVITY LEVEL ATCT FLOOR PLANS ATCT				
ADDISON	ADDISON AIRPORT			TX
REVIEWED BY	SUBMITTED BY		APPROVED BY	
	<i>Edward Hackett</i>		<i>Antonio Borquez</i>	
	PROJECT ENGINEER, ANI-640		PLATFORM MANAGER, ANI-640	
DESIGNED	ED HACKETT	ISSUED BY	DATE	JCN
DRAWN	KS	NAS IMPLEMENTATION ANI-600	06-23-03	9700164
CHECKED			DRAWING NO	REV
			ADS-D-ATCT-A002	A