
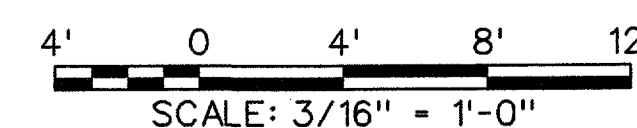
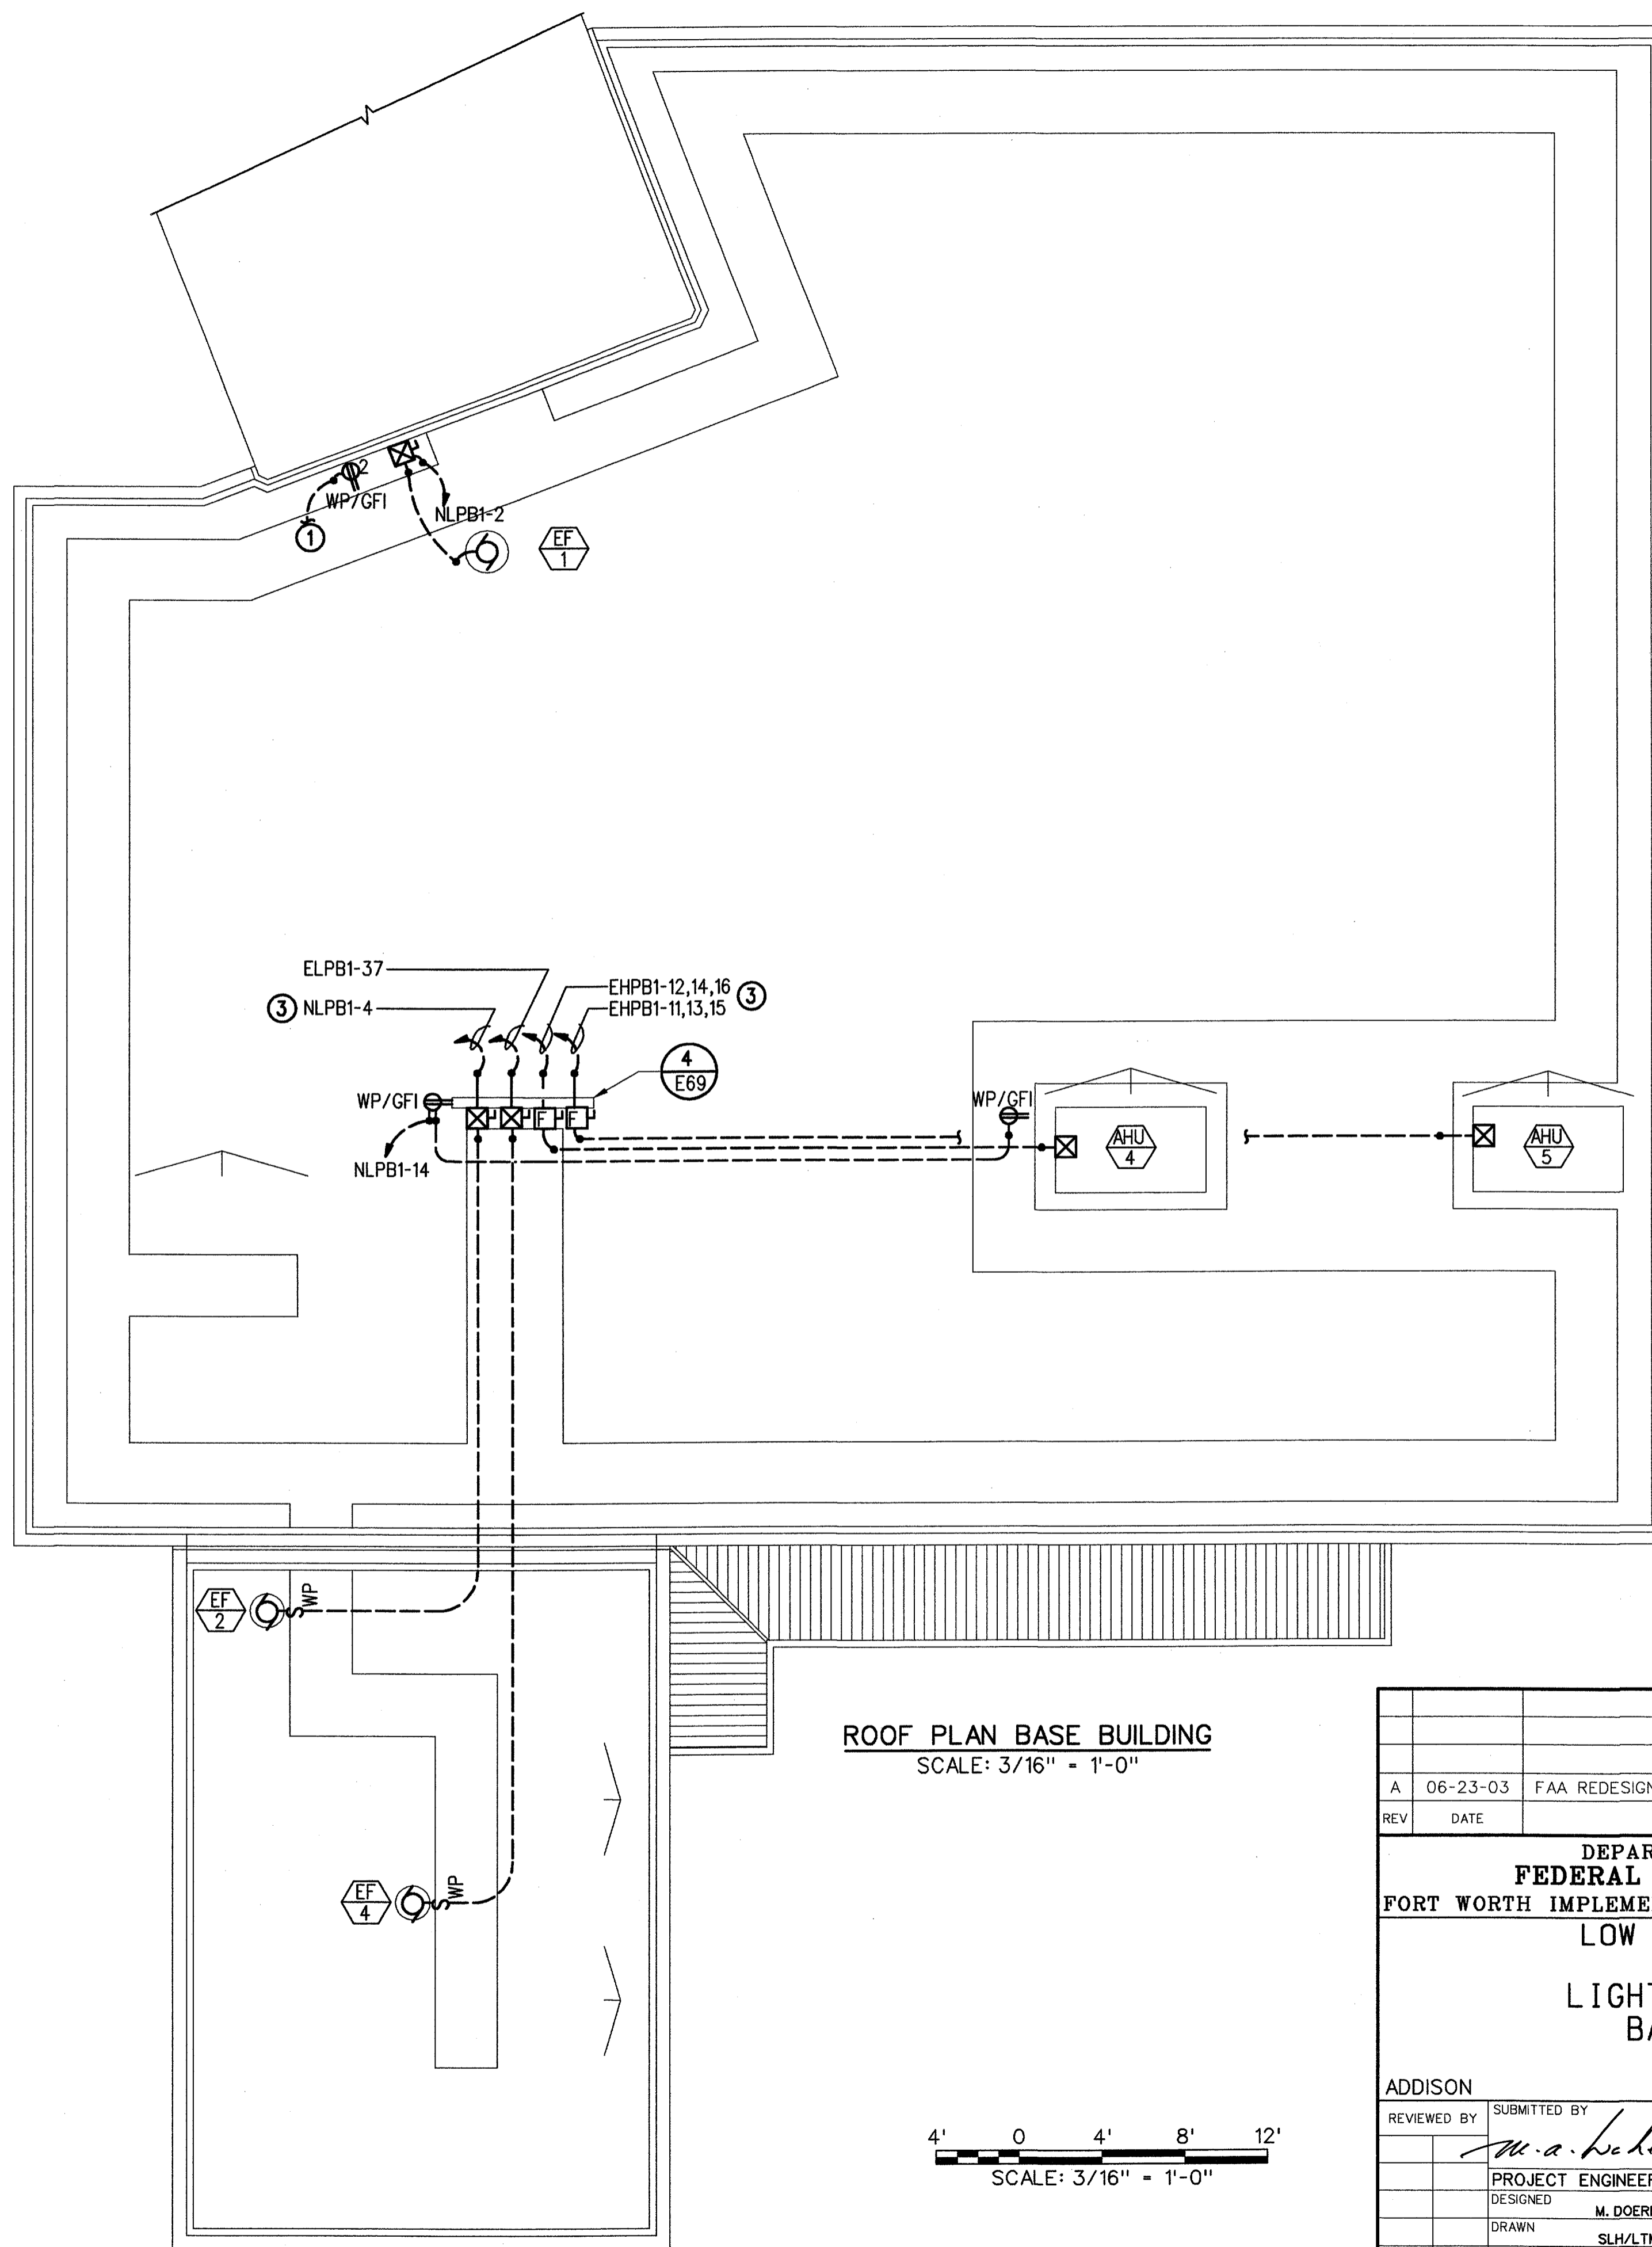


ROOM SCHEDULE	
RM NO.	ROOM NAME
125	TOILET/SHOWER
126	E/G ROOM
127	WORKROOM
128	UPS

NOTES:

- ① DOWN TO RECEPTACLE, SEE DRAWING E013.
- ② SEE DRAWINGS A010 AND A011 FOR EXACT EXTERIOR FIXTURE LOCATIONS AND MOUNTING HEIGHTS.
- ③ SEE DRAWINGS E041 FOR SIZES OF FEEDERS, SWITCH/STARTER FOR HVAC EQUIPMENT.
- ④ MOUNT LIGHTING FIXTURES 9'-0" ABOVE FINISHED FLOOR.

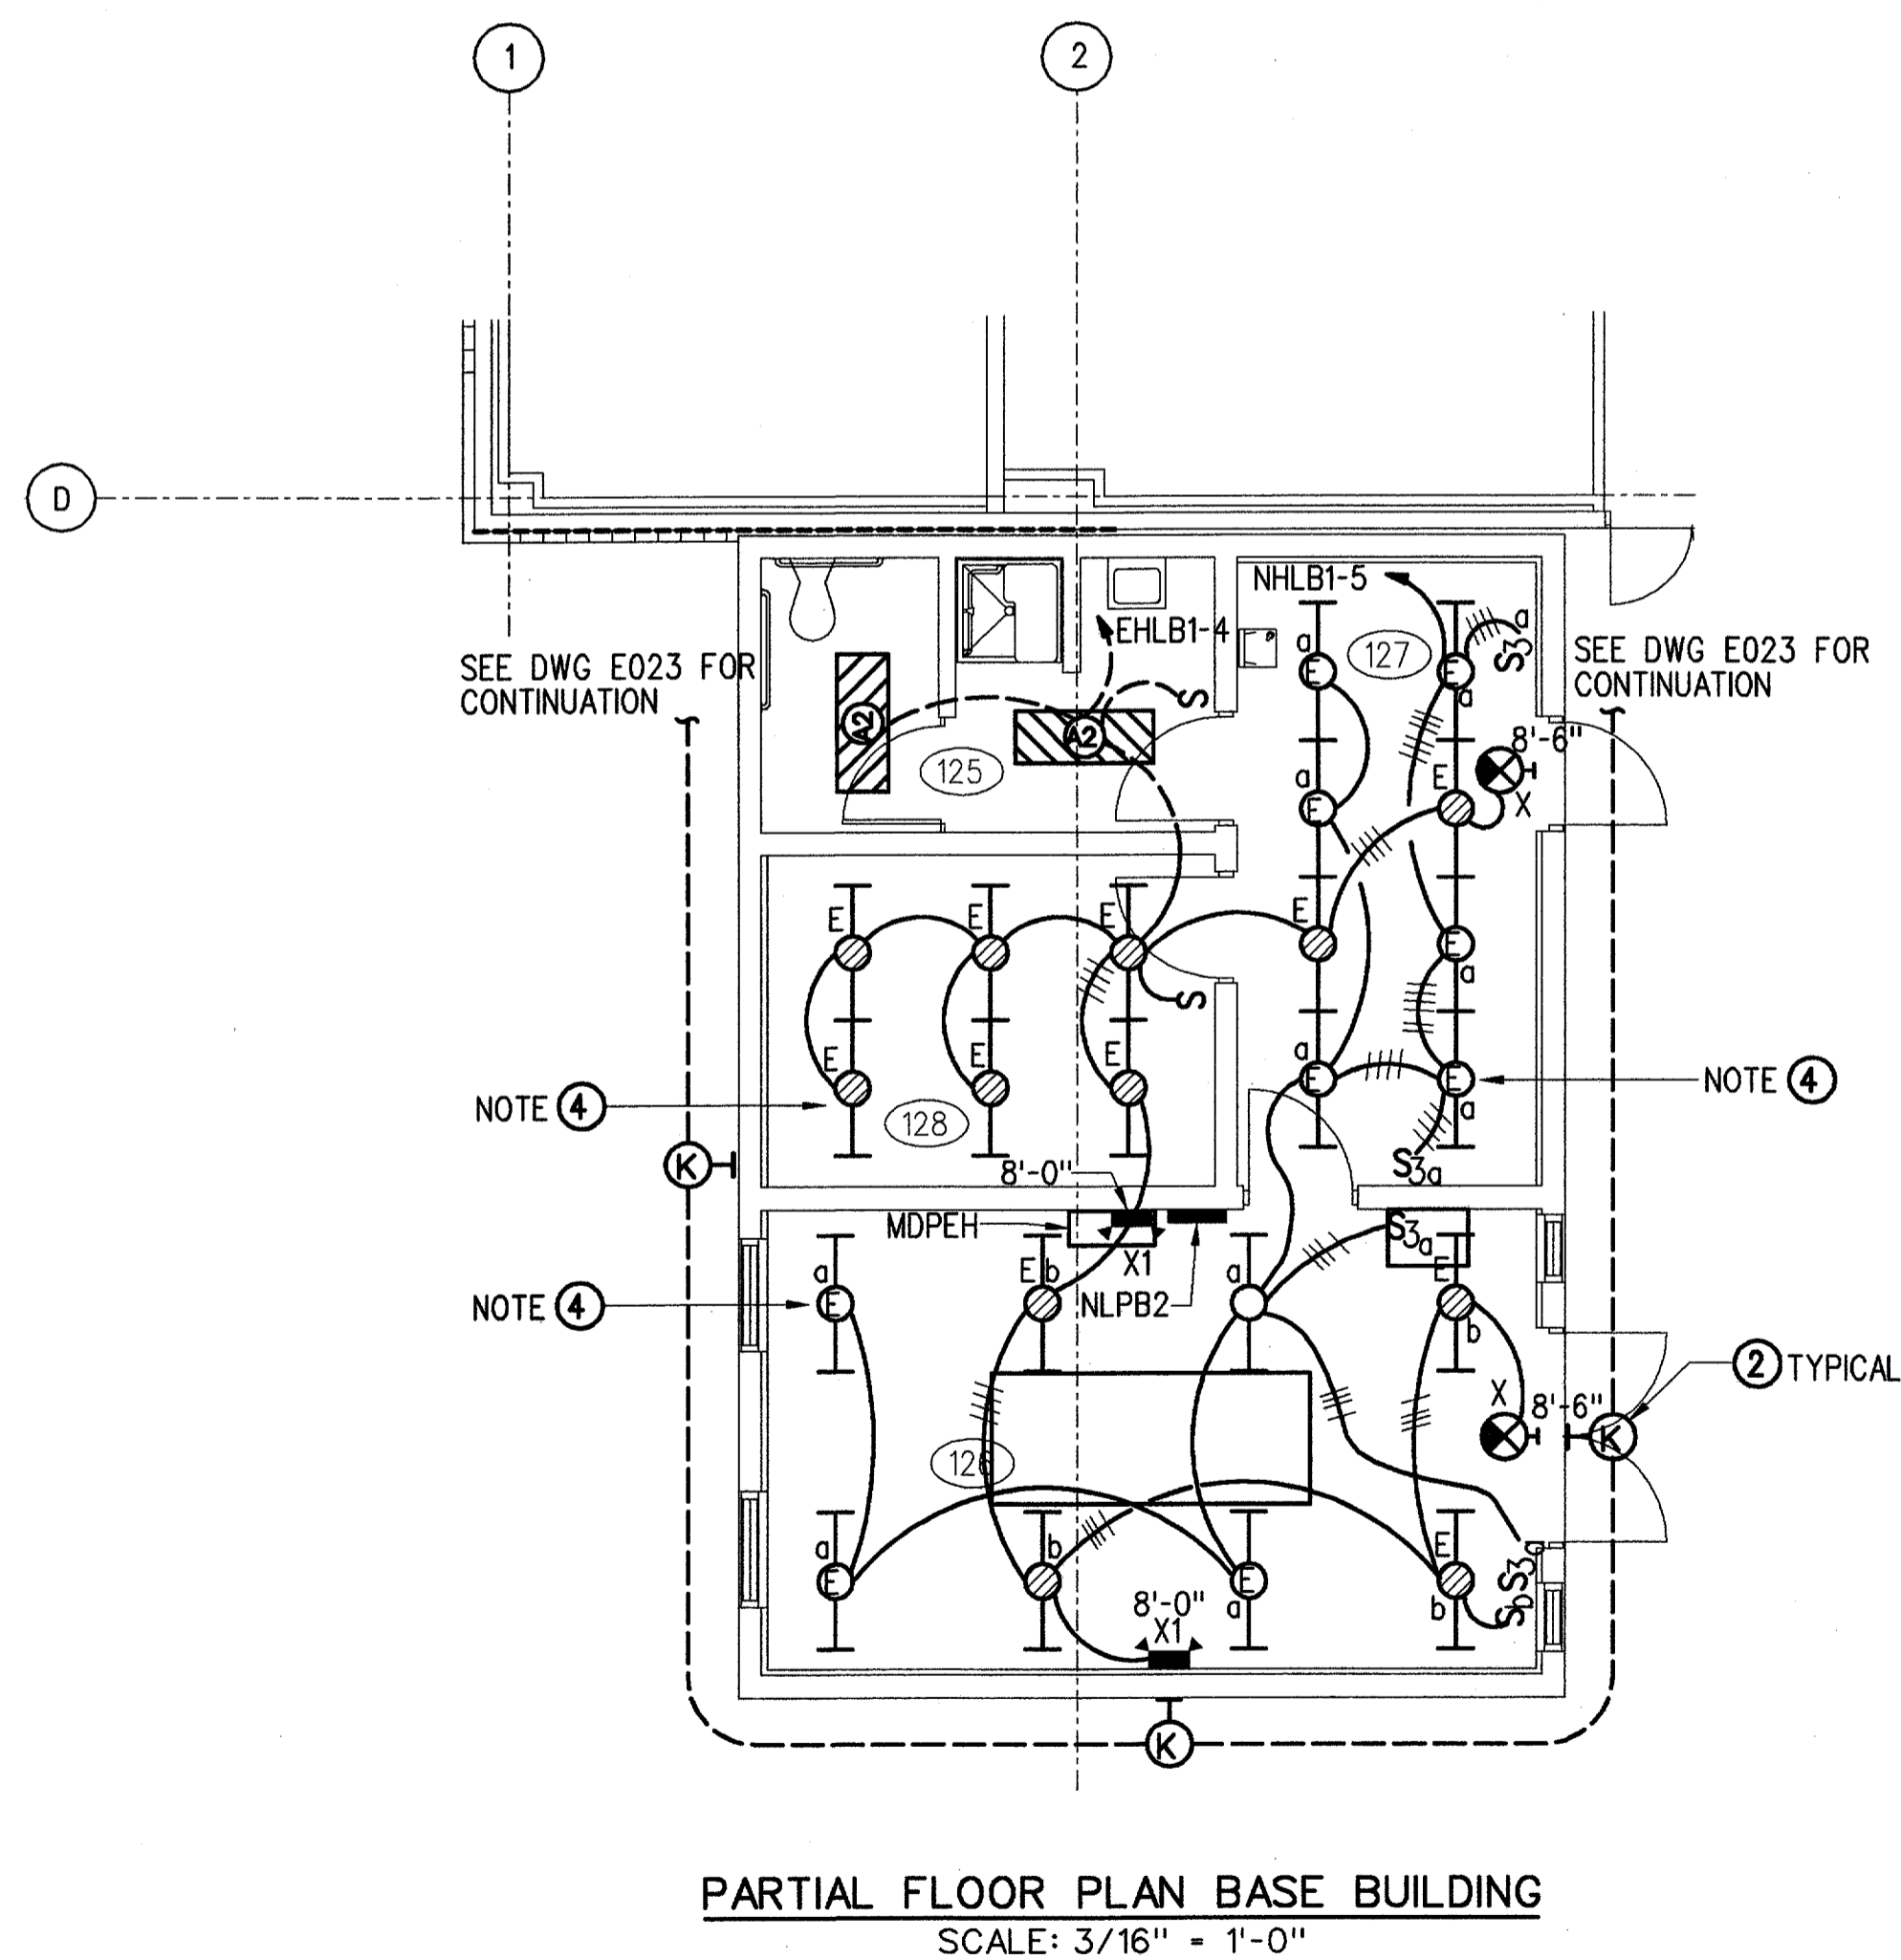

REV	DATE	DESCRIPTION	JCN	REDLINE DATE	APVD
A	06-23-03	FAA REDESIGN OF HVAC, JCN 21874.	9700164	06-23-03	

**DEPARTMENT OF TRANSPORTATION
FEDERAL AVIATION ADMINISTRATION
FORT WORTH IMPLEMENTATION CENTER FORT WORTH, TX**

LOW ACTIVITY LEVEL ATCT

**LIGHTING AND POWER PLAN
BASE-EG BUILDING**

ADDISON	ADDISON AIRPORT	TX
REVIEWED BY	SUBMITTED BY	APPROVED BY
	<i>M. A. Lebeck</i> 7/18/03	<i>Johnnie R. White</i> 7/18/03
DESIGNED	ISSUED BY	PLATFORM MANAGER, ANI-630
M. DOERR		
DRAWN	NAS IMPLEMENTATION	DATE
SLH/LTM	ANI-600	06-23-03
CHECKED		JCN
		9700164
		REV
		A