


AS BUILT DRAWINGS

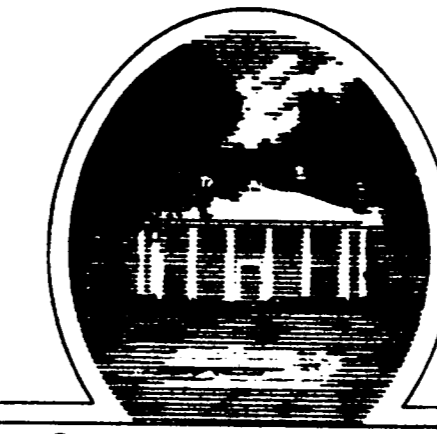

TOWN OF
ADDISON
DALLAS COUNTY, TEXAS

CONSTRUCTION PLANS FOR

KELLER SPRINGS, DOOLEY ROAD IMPROVEMENTS


MAYOR :
Honorable JERRY REDDING

CITY MANAGER:
RON WHITEHEAD

COUNCIL MEMBERS:
GREG COLE Mayor pro tem
BOBBY HATFIELD
RICHARD RODER
LYNN SPRULL
JOHN NOFLAN

Approved by: Jerry Redding Date: _____
Jerry Redding, Mayor of Addison

GINN, INC.
Consulting Engineers Dallas, Texas
JUNE 1986

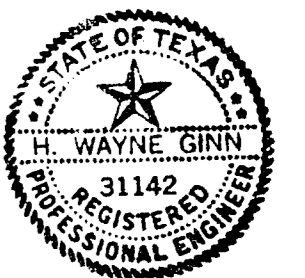

FF-23