


TBM - "□" cut on S.E. top curb corner, the back side parking lot, Building 15950 Midway Road. Elevation 637.75

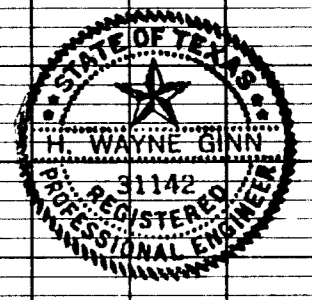

Added Exist. Gas Line Location		RLO	8/18/96
No.	Revision	By	Date
TOWN OF ADDISON DALLAS COUNTY, TEXAS			
KELLER SPRINGS/DOOLEY RD. IMPROVEMENTS			
DOOLEY ROAD PLAN & PAVING STA. 10+00 TO 15+00 PROFILE			
GINN, INC. Consulting Engineers Dallas, Texas			
Designed - G7/JK	Drawn - RLO	Date - DECEMBER 1995	Job No. - 263
Approved - HWG	Checked - JCK	Scale - 1" = 20' H/1" = 5' V	Sheet 6 of 30