


Changed location in the field as shown

services added as shown on meter box and NOT A SEPARATE PAY ITEM

PROPERTY HAS ONE EXCHANGE LEASING @ TIME CONSTRUCTION

FOR MISC. DETAIL SEE SHT. 2

NOTE: CONTRACTOR SHALL INSTALL OR TIE-IN SERVICES AS DIRECTED BY ENGINEER

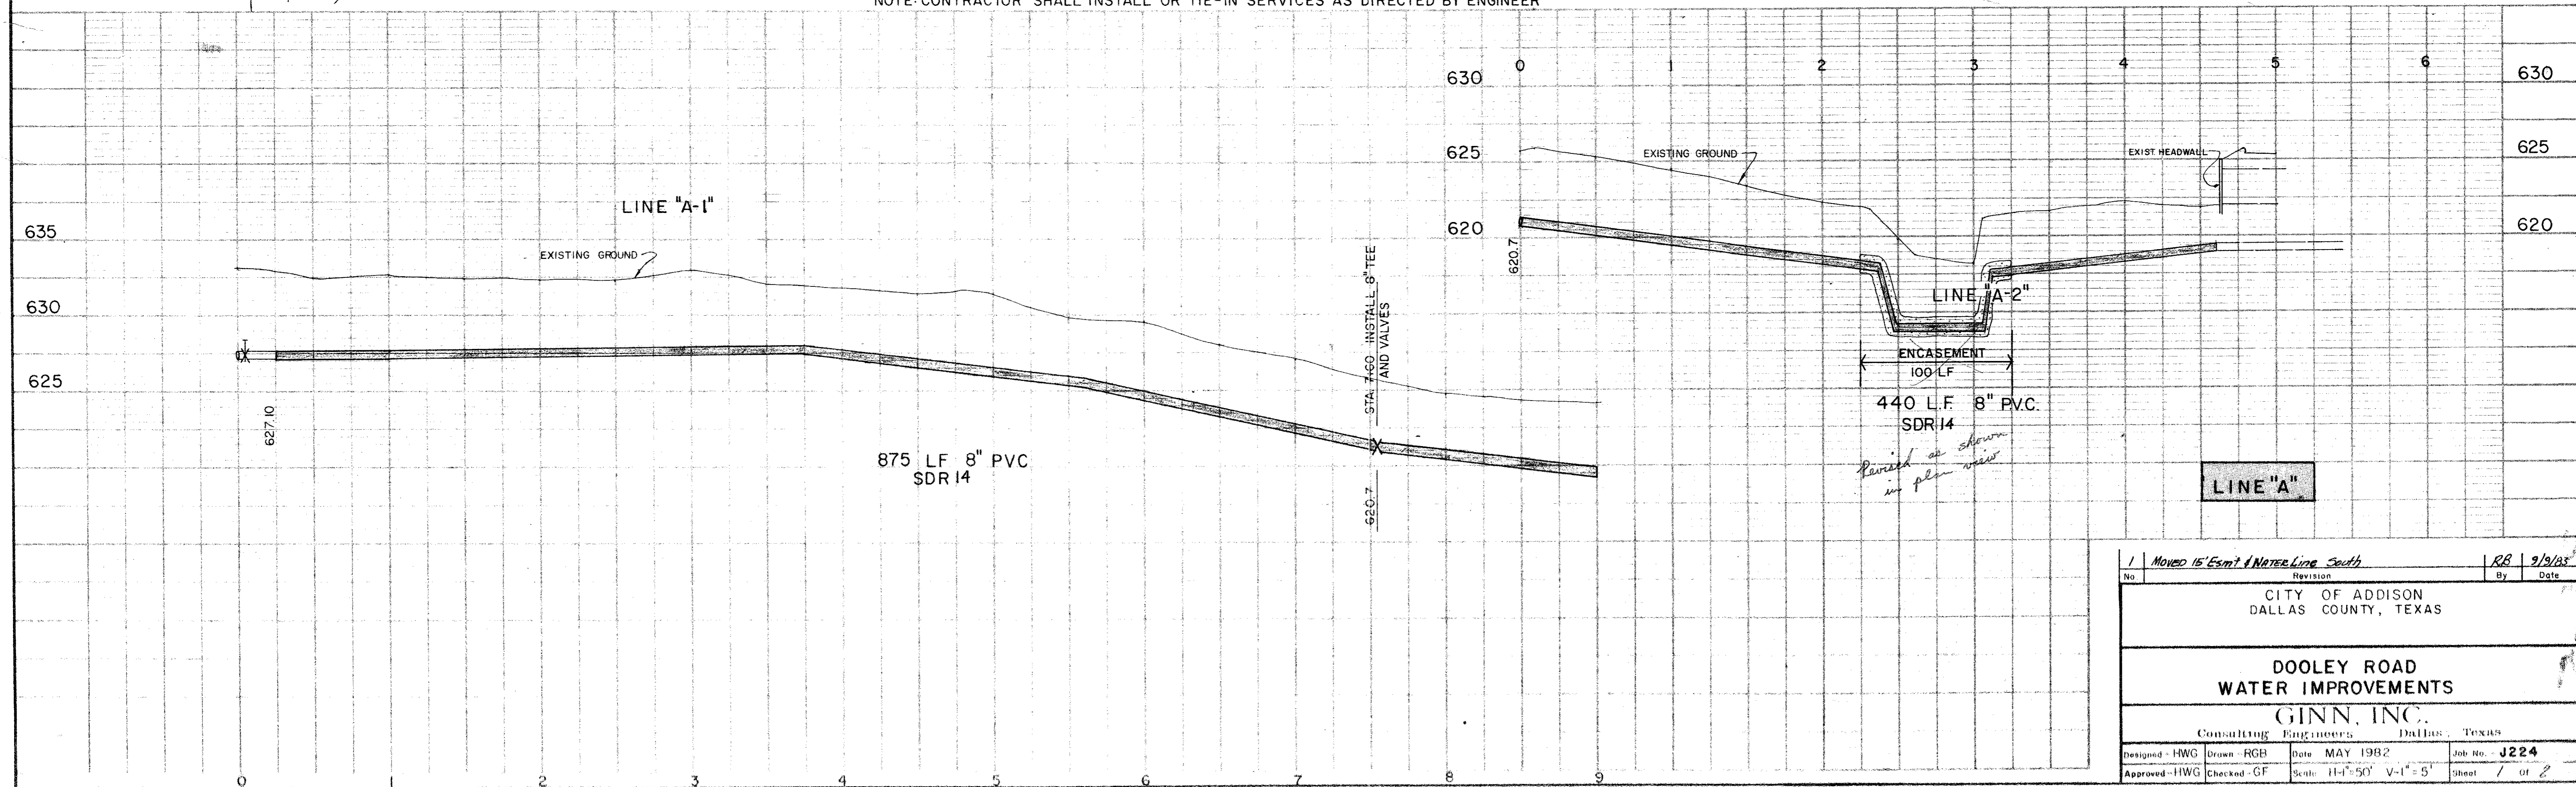

1 Moved 15' Esm't Water Line South		RB	9/9/83
No.	Revision	By	Date
CITY OF ADDISON DALLAS COUNTY, TEXAS			
DOOLEY ROAD WATER IMPROVEMENTS			
GINN, INC. Consulting Engineers Dallas, Texas			
Designed - HWG	Drawn - RGB	Date - MAY 1982	Job No. - J224
Approved - HWG	Checked - GF	Scale - H=1"=50' V=1"=5'	Sheet 1 of 2