


	6" CAL RED OAK B & B - 3
	3 GAL BUFORD HOLLY • 30" OC
	4" POTS - ASIAN JASMINE • 12" OC BW (by Ordinance 8" oc)
	GRASS - BERMDA SEEDED (Sod)

NOTES: SEE SITE UTIL. FOR SPRINKLER METR. SLEEVE APPROACHES FOR SPRINKLER.

*Called Mt. Lambert
11/5/97 to correct
plans & send
revised set to TOA
for review
Rjae 11/5/97*

DATE 10/29/97
EXISTING

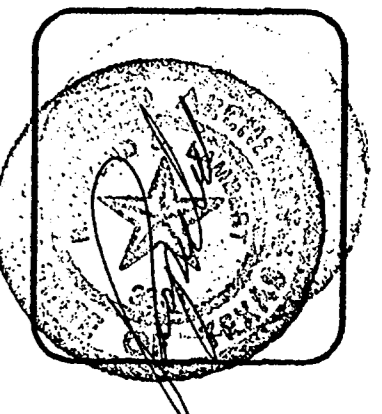

AIRPORT HANGAR RELOCATION
ADDISON AIRPORT OF TEXAS, INC.
4505 CLAIRE CHENNAULT
DALLAS, TEXAS 75248
PHONE (972) 248-1133, EXT. 103
FRES. - SAM STUART

raymond s. lambert & associates
architect-planners
1224A Inwood rd
DALLAS, TEXAS 75244
214 387-4288

OWN OF ADDISON
This is a preliminary plan...
made by...
all the...
res...
ordin...
This...
and is...
their request...
delay approval of a requested inspection.

LANDSCAPE

sheet no. 101
LS

LANDSCAPE PLAN SCALE 1"=10'