

SANITARY SEWER LINE 'SS-1' PROFILE

SANITARY SEWER LINE 'SS-2' PROFILE

- BENCH MARKS:**
- "D" OUT ON S.E. CORNER OF SIDEWALK AT THE ENTRANCE TO 4805 ARAPAHO RD. APPROX ±400 FEET EAST OF ADDISON RD. ELEV. 630.66
 - "D" ON SOUTH RIM OF MANHOLE LOCATED ON THE SOUTH SIDE OF ARAPAHO RD AT THE NORTHEAST CORNER OF SITE, APPROX. 16.5' EAST OF THE WEST END OF SIDEWALK. ELEV. 632.25

RECORD DRAWING

THIS DRAWING HAS BEEN REVISED TO REFLECT CONSTRUCTION RECORDS MAINTAINED AND PROVIDED BY THE CONTRACTOR FOR THIS PROJECT.

CONTRACTOR: SOUTHERN MECHANICAL PLUMBING, INC.
400 S. ASTON
SUNNYVALE, TEXAS 75182

DATE REVISED: 29 MARCH 1996



- REVISED: MARCH 29, 1996
- REVISED: JULY 13, 1995

PACHECO KOCH 9401 LBJ Freeway, Suite 300
Consulting Engineers, Inc. Dallas, Texas 75243
Civil Engineering • Land Surveying (214) 255-3031

SANITARY SEWER PROFILE
SUMMERFIELD SUITES HOTEL
ARAPAHO ROAD
QUORUM CENTER ADDITION
CITY OF ADDISON, TEXAS

DESIGN	DRAWN	DATE	SCALE	NOTES	FILE	NO.
JAK	BB	5/3/95	1"=40'H 1"=5'V			


PRINTS ISSUED

DATE	PURPOSE	NO.

FOR CONSTRUCTION:

REVISIONS

DATE	ITEM	NO.

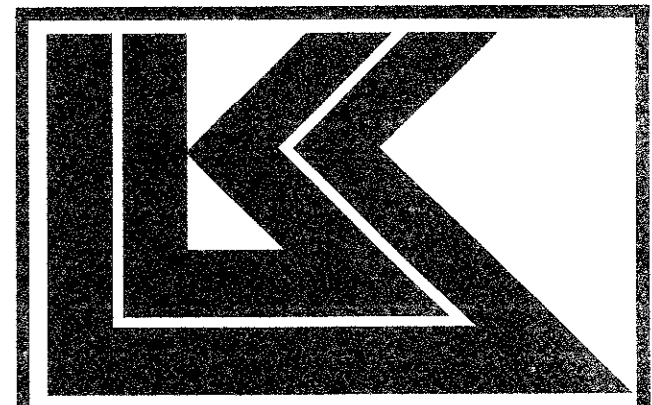

LAW/KINGDON, INC.
ARCHITECTS & ENGINEERS
345 RIVERVIEW, WICHITA, KS 67205
Phone: (316) 268-0200 Fax: (316) 268-6000
Copyright © 1994

DRAWN	CHECKED
BB	JAK

RELATED DRAWINGS

SHELL	DETAILS	STRUCTURE	MECHANICAL	ELECTRICAL	OTHER

SEQUENCE NUMBER: _____ OF _____ SHEETS

SUMMERFIELD SUITES HOTEL

ADDISON, TEXAS

PROJECT NUMBER 94780

SANITARY SEWER PROFILE

SHEET TITLE: _____
SHEET NUMBER: _____

C-6

6 OF 7 SHEETS