

**PRINTS ISSUED**

DATE	PURPOSE	NO.

**FOR CONSTRUCTION**

REVISIONS		
NO.	DATE	ITEM



**LAW/KINGDON, INC.**  
 ARCHITECTS & ENGINEERS  
 514 N. ...  
 Phone (972) ...  
 Copyright © 1994

BRANN	CHECKED
BB	JAK

RELATED DRAWINGS		
SHELL	DETAILS	STRUCTURE
MECHANICAL	ELECTRICAL	OTHER

**SUMMERFIELD SUITES HOTEL**

ADDITION, TEXAS

PROJECT NUMBER: 94780

**PACHECO KOCH**  
 Consulting Engineers, Inc.  
 9401 LBJ Freeway, Suite 300  
 Dallas, Texas 75243  
 (214) 255-5651

**CITY OF ADDISON, TEXAS**

QUORUM CENTER ADDITION

ARAPAHO ROAD


SUMMERFIELD SUITES HOTEL

**SANITARY SEWER PROFILE**

SHEET NUMBER


**C-6**

6 OF 7 SHEETS

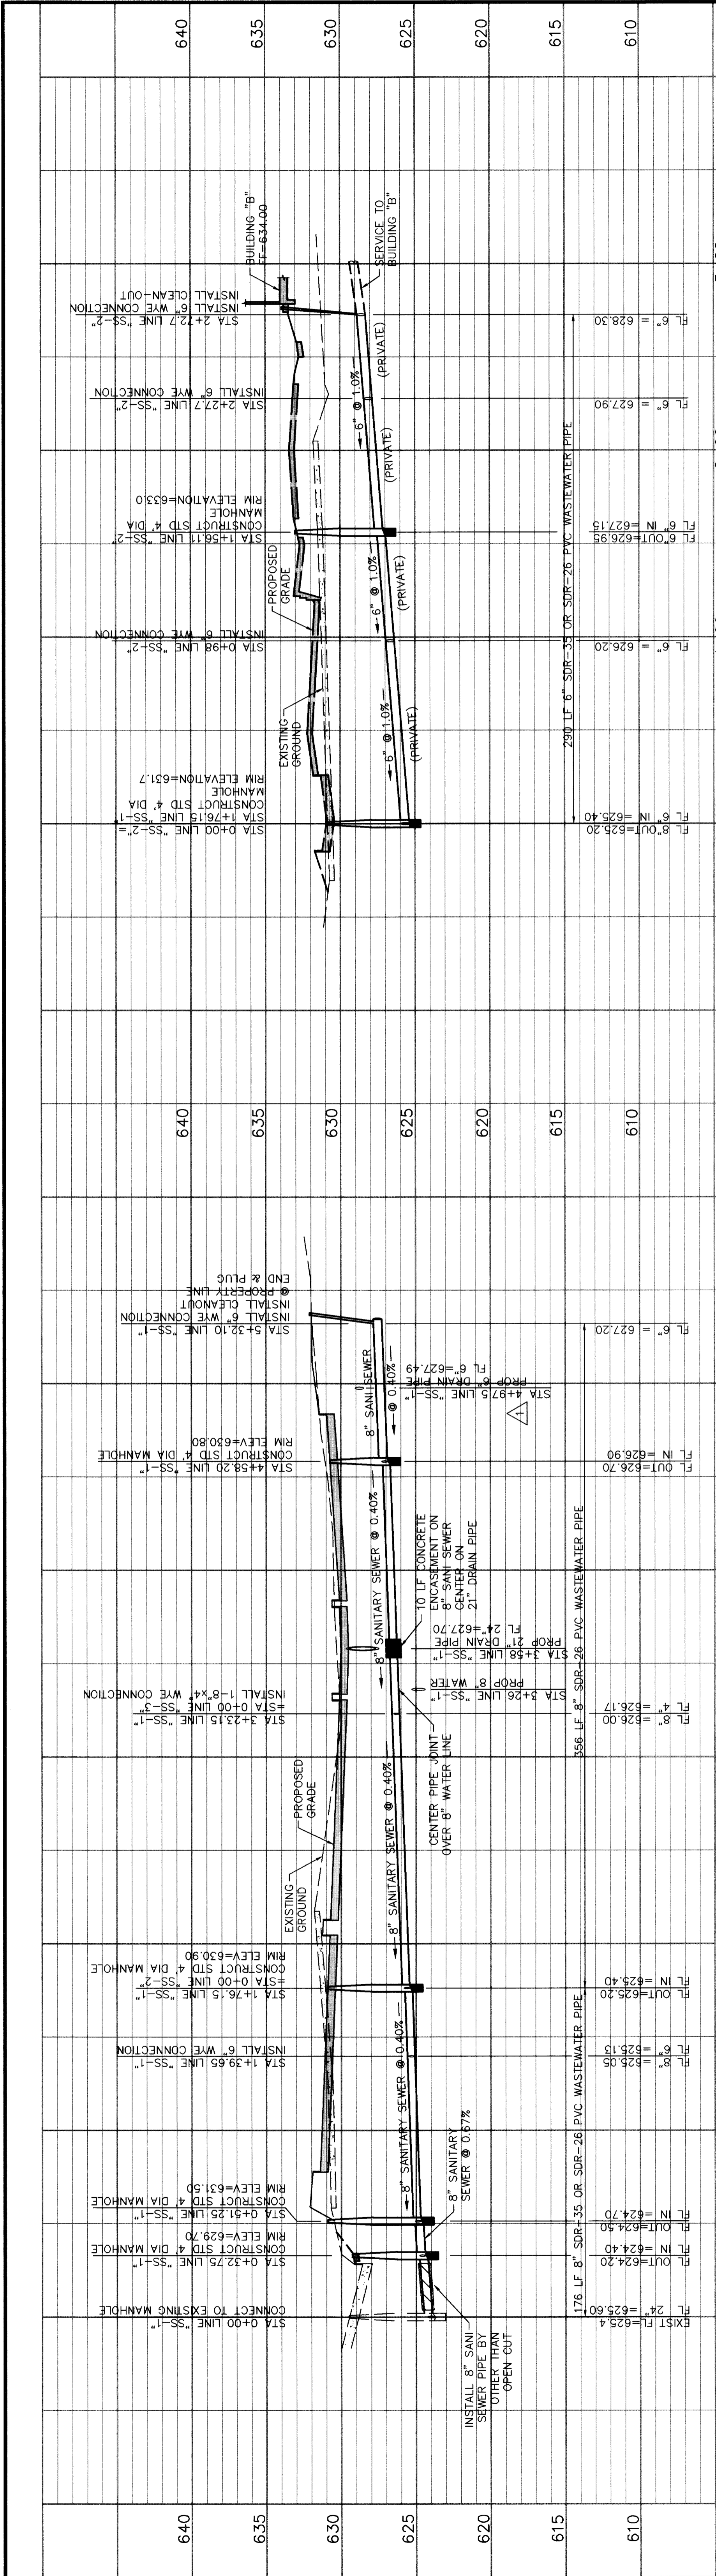

**SANITARY SEWER LINE 'SS-1' PROFILE**

**SANITARY SEWER LINE 'SS-2' PROFILE**

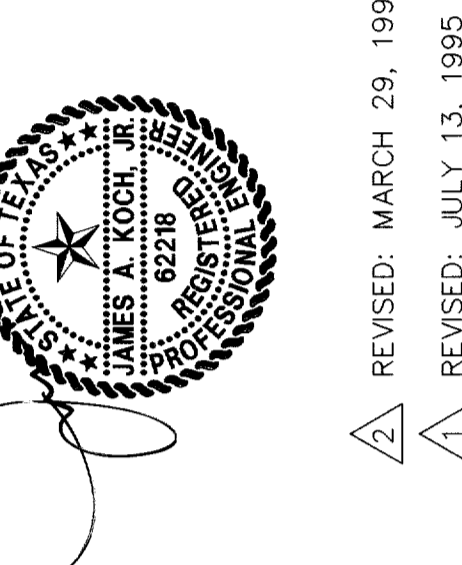

**RECORD DRAWING**

THIS DRAWING HAS BEEN REVISED TO REFLECT CONSTRUCTION RECORDS MAINTAINED AND PROVIDED BY THE CONTRACTOR FOR THIS PROJECT.

CONTRACTOR: SOUTHERN MECHANICAL PLUMBING, INC.  
 1000 EAST BAYVIEW BOULEVARD  
 SUNNYVALE, TEXAS 75182

DATE REVISED: 29 MARCH 1996

REVISED: MARCH 29, 1996  
 REVISED: JULY 13, 1995

**BENCH MARKS:**

1. "DT" CUT ON S.E. CORNER OF SIDEWALK AT THE ENTRANCE TO 4805 ARAPAHO RD.  
 APPROX 4400 FEET EAST OF ADDISON RD. ELEV. 630.66

2. "DT" ON SOUTH RIM OF MANHOLE LOCATED ON THE SOUTH SIDE OF ARAPAHO RD  
 APPROX 16.5' NORTH-EAST CORNER OF SITE. APPROX. 16.5' EAST OF THE WEST END OF  
 SIDEWALK. ELEV. 632.25

PK NO: 1487-90.01

DWG NO: 1487-05