



VICINITY MAP  
NOT TO SCALE

NOTES:

1. ALL CONSTRUCTION TO BE DONE IN STRICT ACCORDANCE TO THESE PLANS AND ALL APPLICABLE MUNICIPAL CODES AND STANDARDS.
2. ALL DIMENSIONS SHOWN ARE TO THE BACK OF CURB UNLESS OTHERWISE NOTED.
3. SEE ARCHITECTURAL PLANS FOR ALL BUILDING DIMENSIONS AND DETAILS.
4. SEE SHEET C-2 FOR ALL PAVING AND GRADING PLANS.
5. SEE SHEET C-3 FOR STORM DRAIN AND DETENTION BASIN PLANS.
6. SEE SHEET C-4 FOR STORM DRAIN PROFILES.
7. SEE SHEET C-5 FOR EROSION CONTROL PLANS.
8. SEE SHEET C-6 FOR PAVEMENT JOINT LOCATIONS AND DETAILS.
9. SEE SHEET C-7 FOR LOCATIONS AND DETAILS OF UTILITY SERVICES TO BUILDING.
10. SEE SHEET C-8 FOR DETENTIONS CALCULATIONS AND EROSION CONTROL DETAILS.
11. SEE SHEET C-9 FOR PAVING AND STORM DRAIN DETAILS.

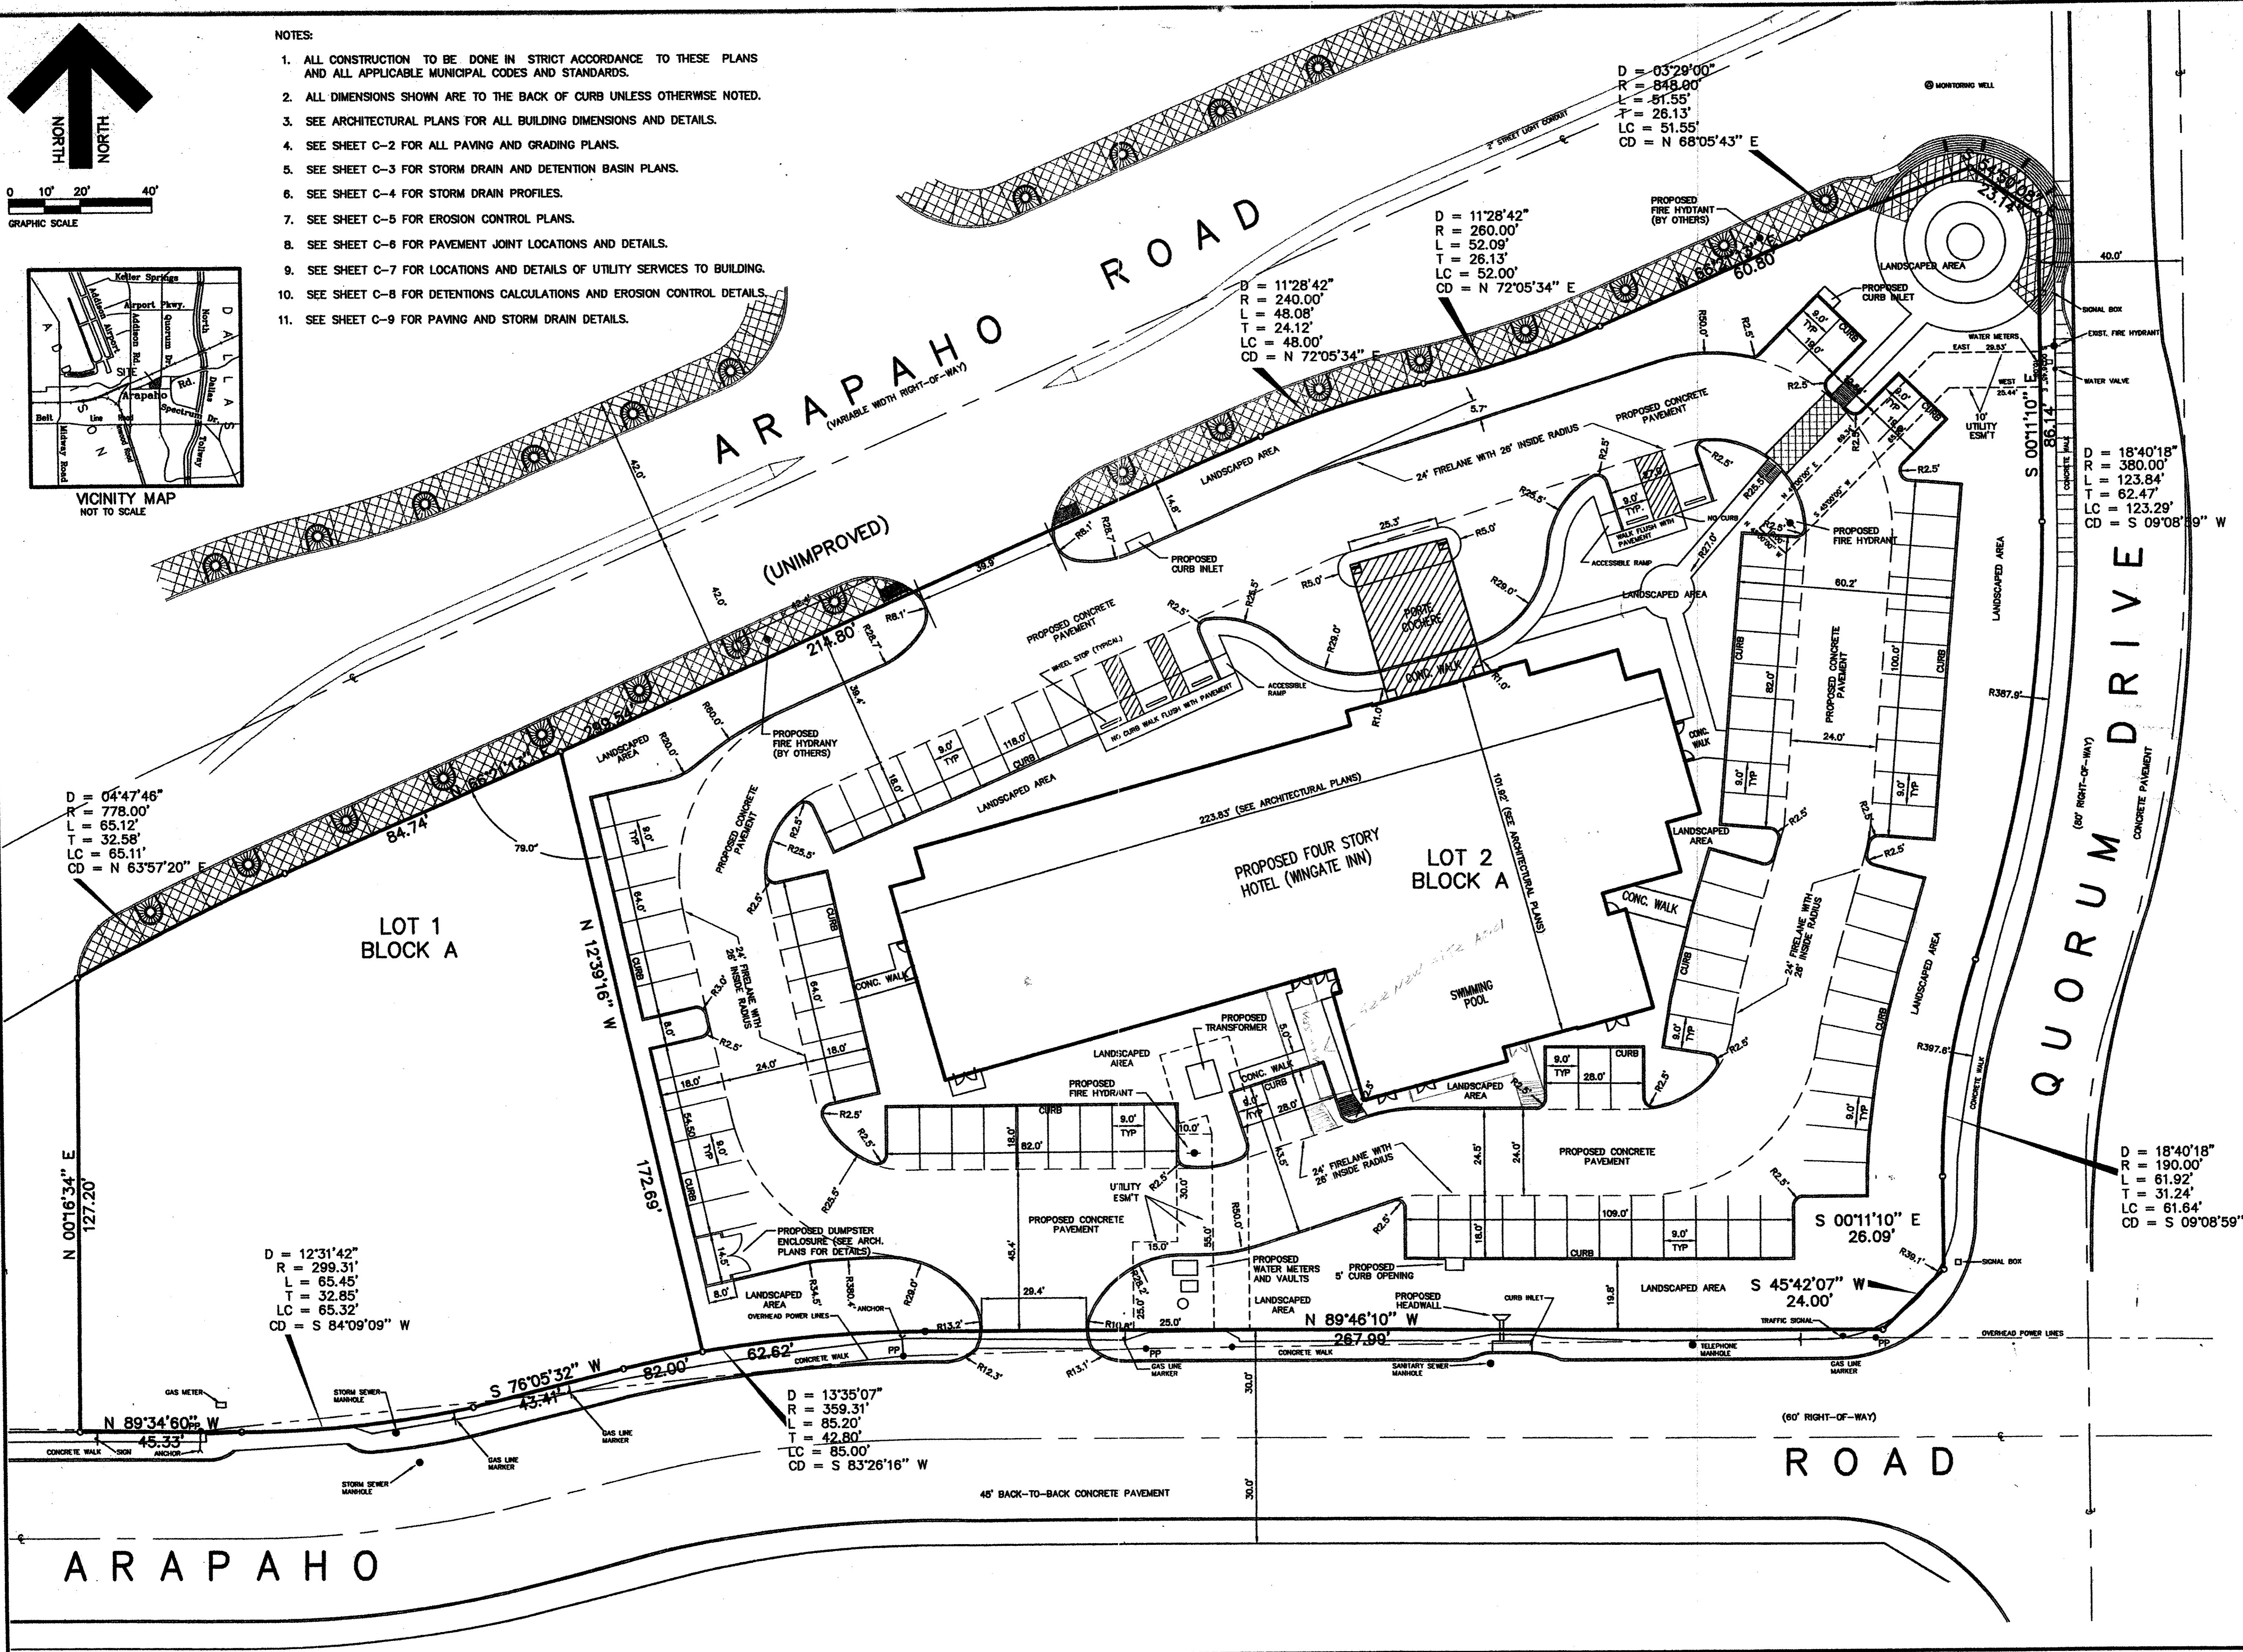

**JDJR ENGINEERS & CONSULTANTS, INC.**  
 ENGINEERS · LAND PLANNERS · CAD DESIGNS  
 2505 Texas Drive Suite 109 Irving, Texas 75062  
 Tel. 972-252-1001 (6367) Fax. 972-273-6880

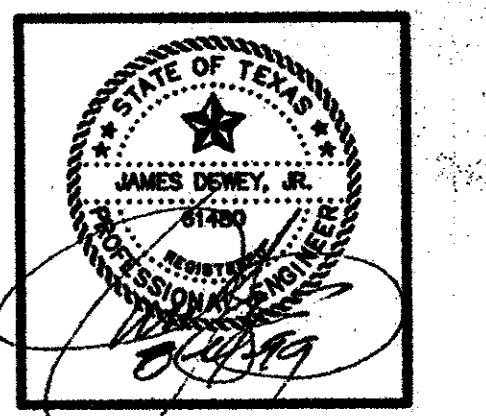

PROJECT: WINGATE INN  
 ARAPAHO ROAD AT QUORUM DRIVE  
 LOT 2 BLOCK "A"  
 WINGATE INN OF ADDISON ADDITION  
 ADDISON, TEXAS

REVISIONS:	
DATE	REVISION
6/22/98	CITY COMMENTS
7/08/98	CITY COMMENTS
7/20/98	REVISE LINE "A"
8/3/98	UPDATE SET

SHEET TITLE	
SITE DIMENSIONAL CONTROL PLAN	
DATE:	5-22-98
SCALE:	1" = 20'
DRAWN BY:	J.N.M.
CHECKED BY:	JDJR
SHEET NO.	C1 OF 9
JDJR FILE NO.	98-022

B18-11