



**LEGEND**

- EXPANSION JOINT
- CONTRACTION JOINT
- FLOWLINE OR INVERT

NOTE: SEE SHEET 9 OF 9 FOR ALL JOINT DETAILS

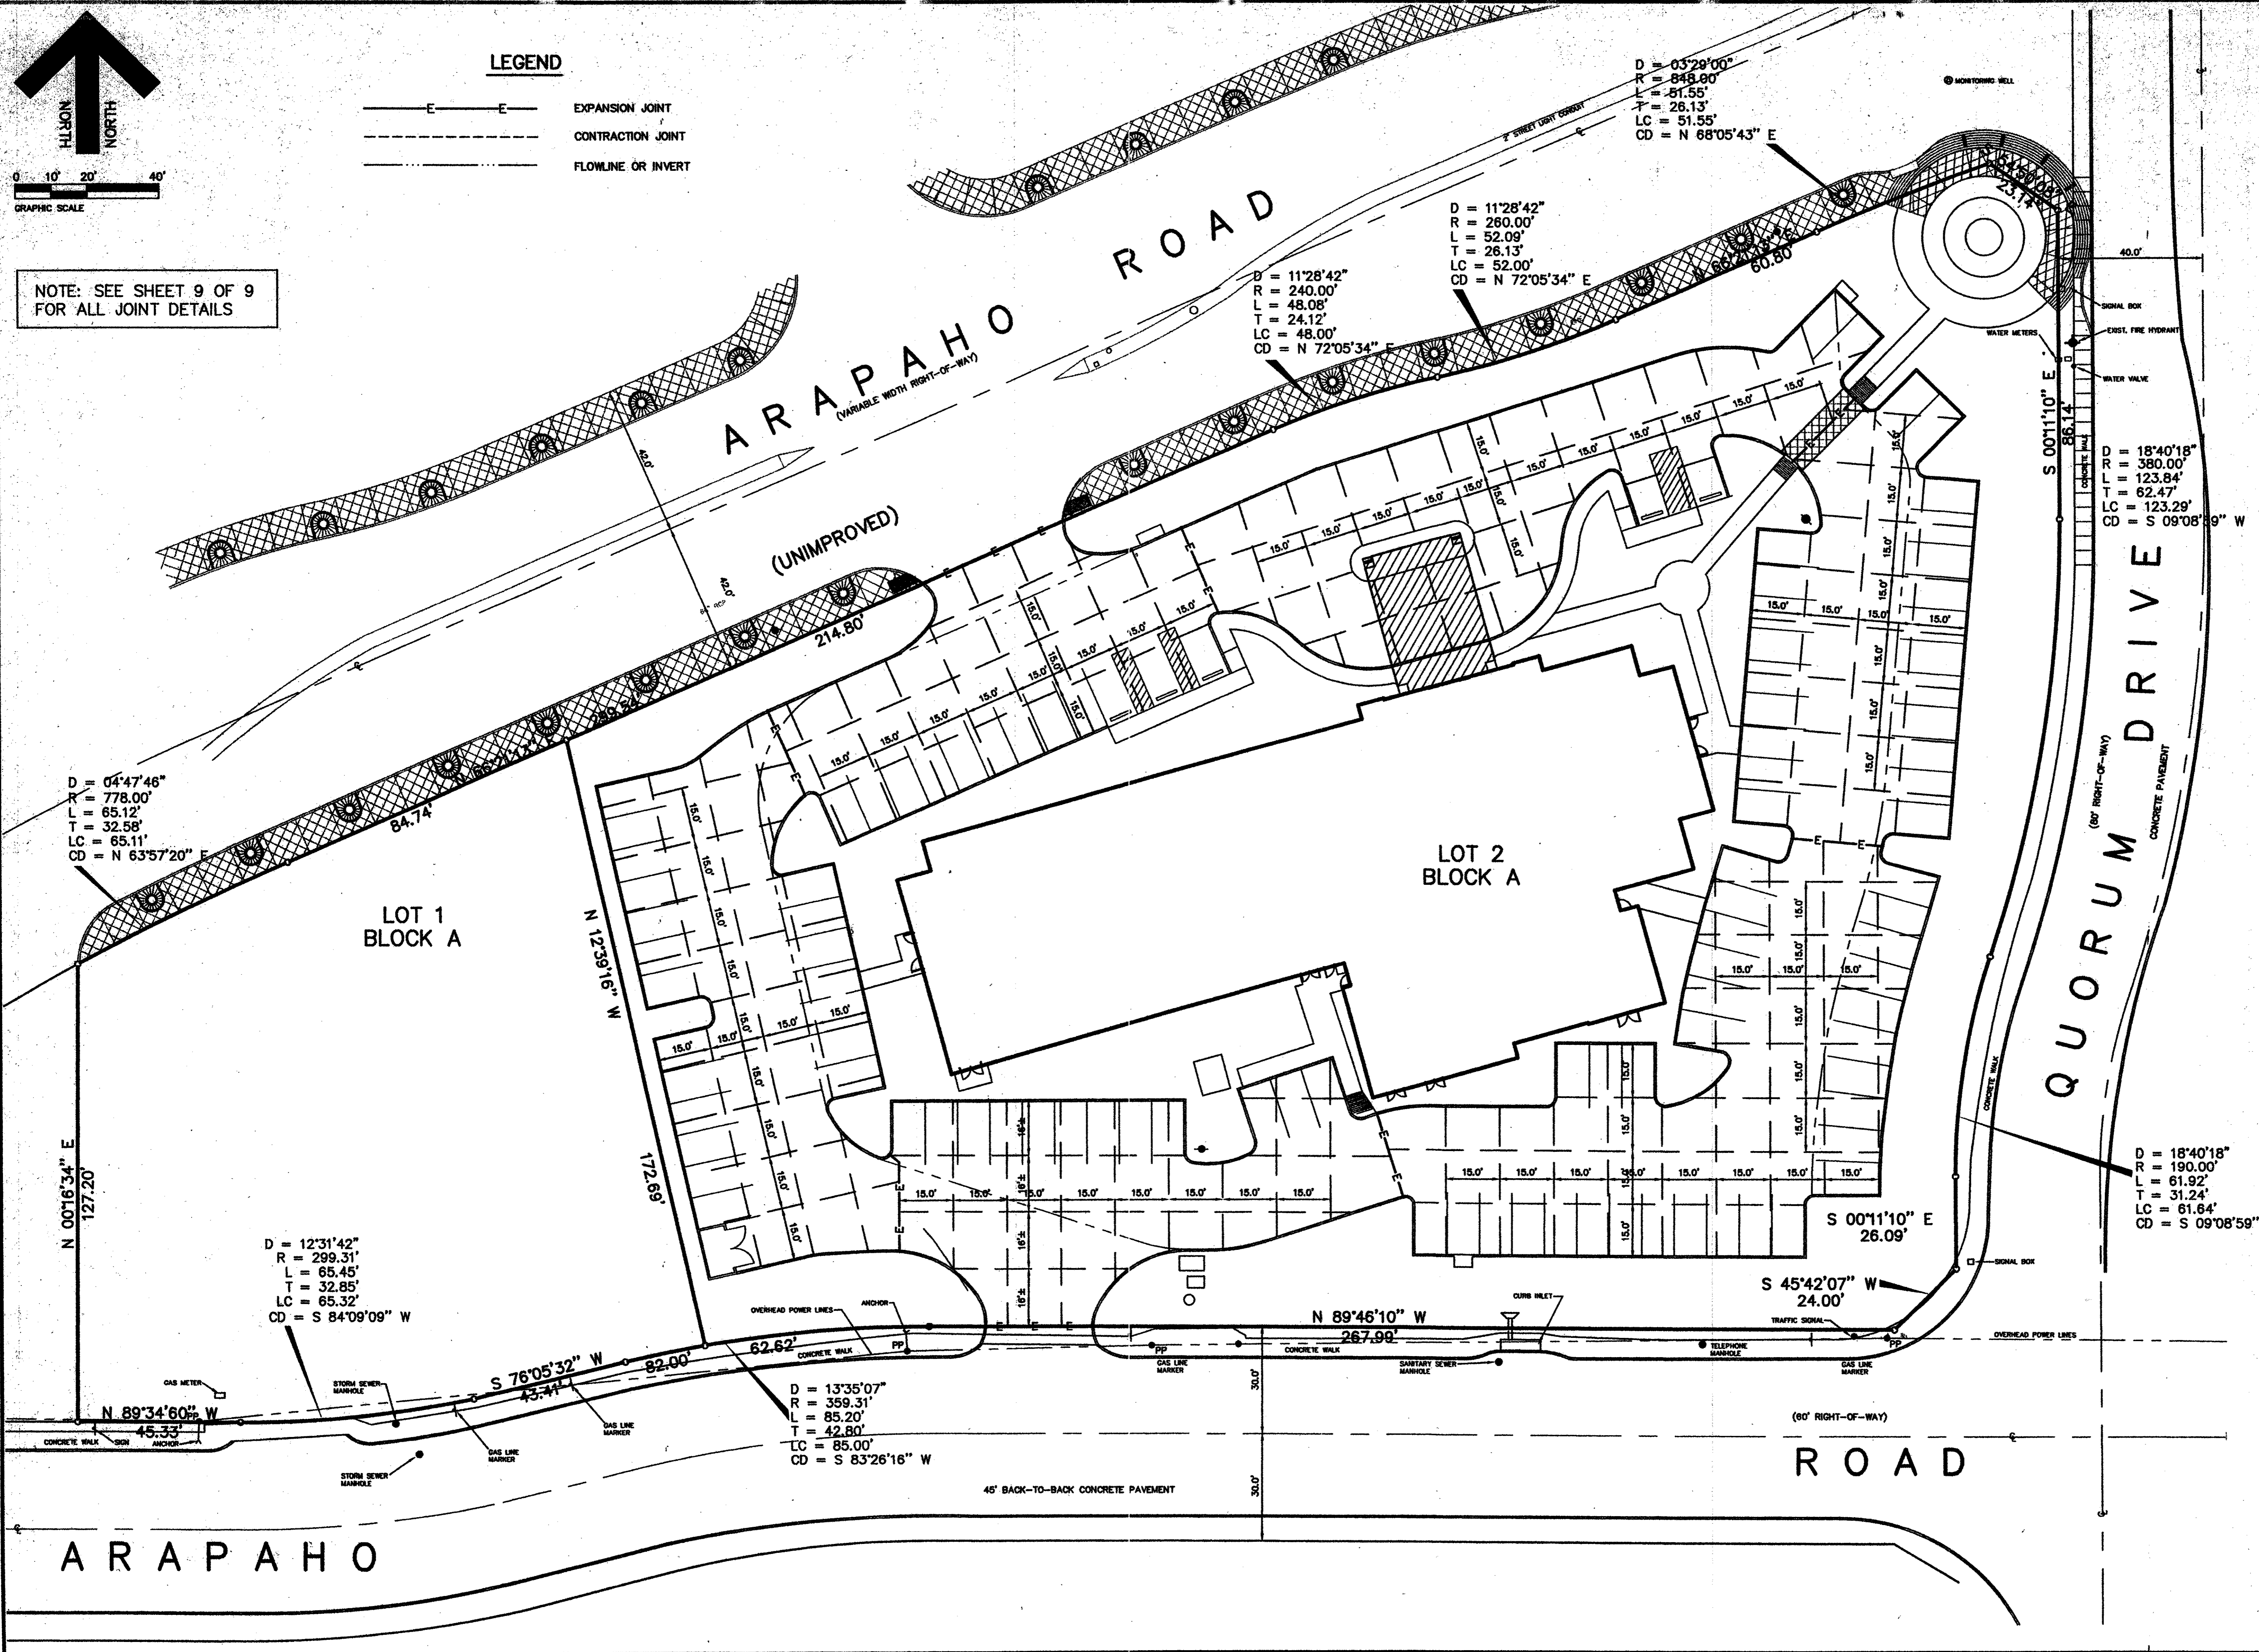

**JDJR ENGINEERS & CONSULTANTS, INC.**  
 ENGINEERS • LAND PLANNERS • CAD DESIGNS  
 2005 Texas Drive, Suite 900, Irving, Texas 75039  
 TEL: 972-262-0349 (FAX): 972-272-8991

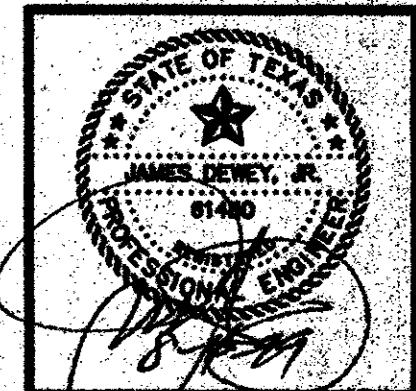

PROJECT: WINGATE INN  
 ARAPAHO ROAD AT QUORUM DRIVE  
 LOT 2 BLOCK "A"  
 WINGATE INN OF ADDISON ADDITION  
 ADDISON, TEXAS

**REVISIONS**

DATE	REVISION
6/22/98	CITY COMMENTS
7/06/98	CITY COMMENTS
7/20/98	REVISE LINE 'A'
8/3/98	UPDATE SET

**SHEET TITLE**  
 JOINT  
 PATTERN  
 PLAN

DATE: 5-22-98  
 SCALE: 1" = 20'  
 DRAWN BY: J.N.M.  
 CHECKED BY: J.D.R.  
 SHEET NO.  
**C6 of 9**  
 J.D.R. FILE NO. 98-022