


General Notes:

- 1) Contractor To Provide & Install 262 L.F. Of 8" PVC Sanitary Sewer Line, In Accordance W/ The City Of Addison, Texas Codes & Specifications.
- 2) Contractor To Field Verify All Existing Conditions & F.L. Elevations.
- 3) Refer To Detail For Backfill & Cut Information.
- 4) New Bldg. Line To Be Connected To S.S. Extension & Existing Lateral Lines At Building.
- 5) Cap and fill existing septic tank.
- 6) Contractor to comply with all O.S.H.A. requirements regarding trench safety.

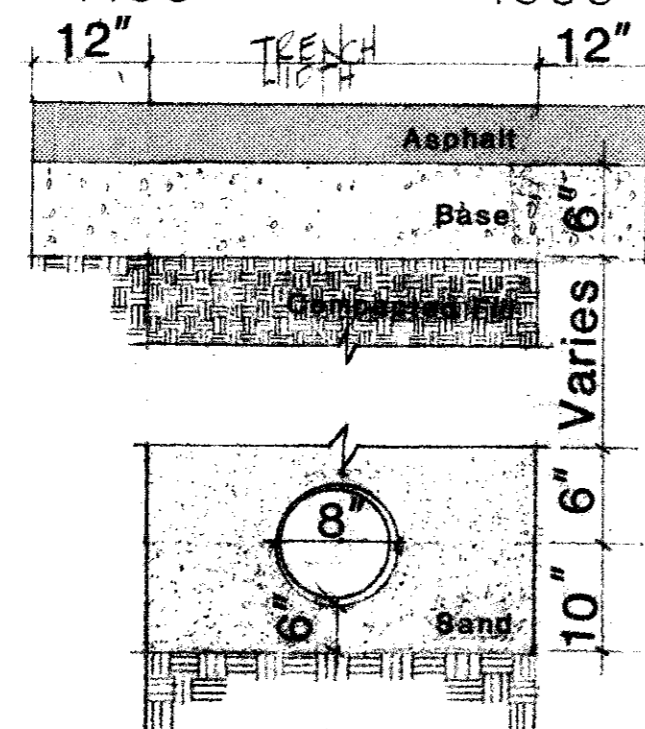

Trench Section

NOTE:
 1) SEAL OFF ASPHALT BEFORE REMOVING.
 2) ASPHALT CLEANER SHOULD BE USED FOR CLEANING.
 3) SELECT FILL MATERIAL ON LATERALS FREE OF DEBRIS & S.C. MATERIAL.
 4) FILL SHOULD BE COMPACTED TO 95% ATC PROCTOR DENSITY.
 5) SEWER LINE SHOULD BE COVERED WITH SAND AND 18" MIN. CONCRETE.

AS BUILT

BENCHMARK : R.R. Spike in second power pole north of Keller Springs Rd. (south) on east side of Addison Rd. Elevation: 640.18'

TBM Set : Brass cap in concrete inlet at south property line corner on Addison Rd. Elevation 638.65'




Michael Cummings
6/28/89

Proposed 8" Sanitary Sewer Line Extension

McKamy Air Terminal At Addison Airport

Addison, Texas
6/7/89
Revised 6/28/89


APPROVED FOR CONSTRUCTION
DATE: 6/23/89
BY: [Signature]

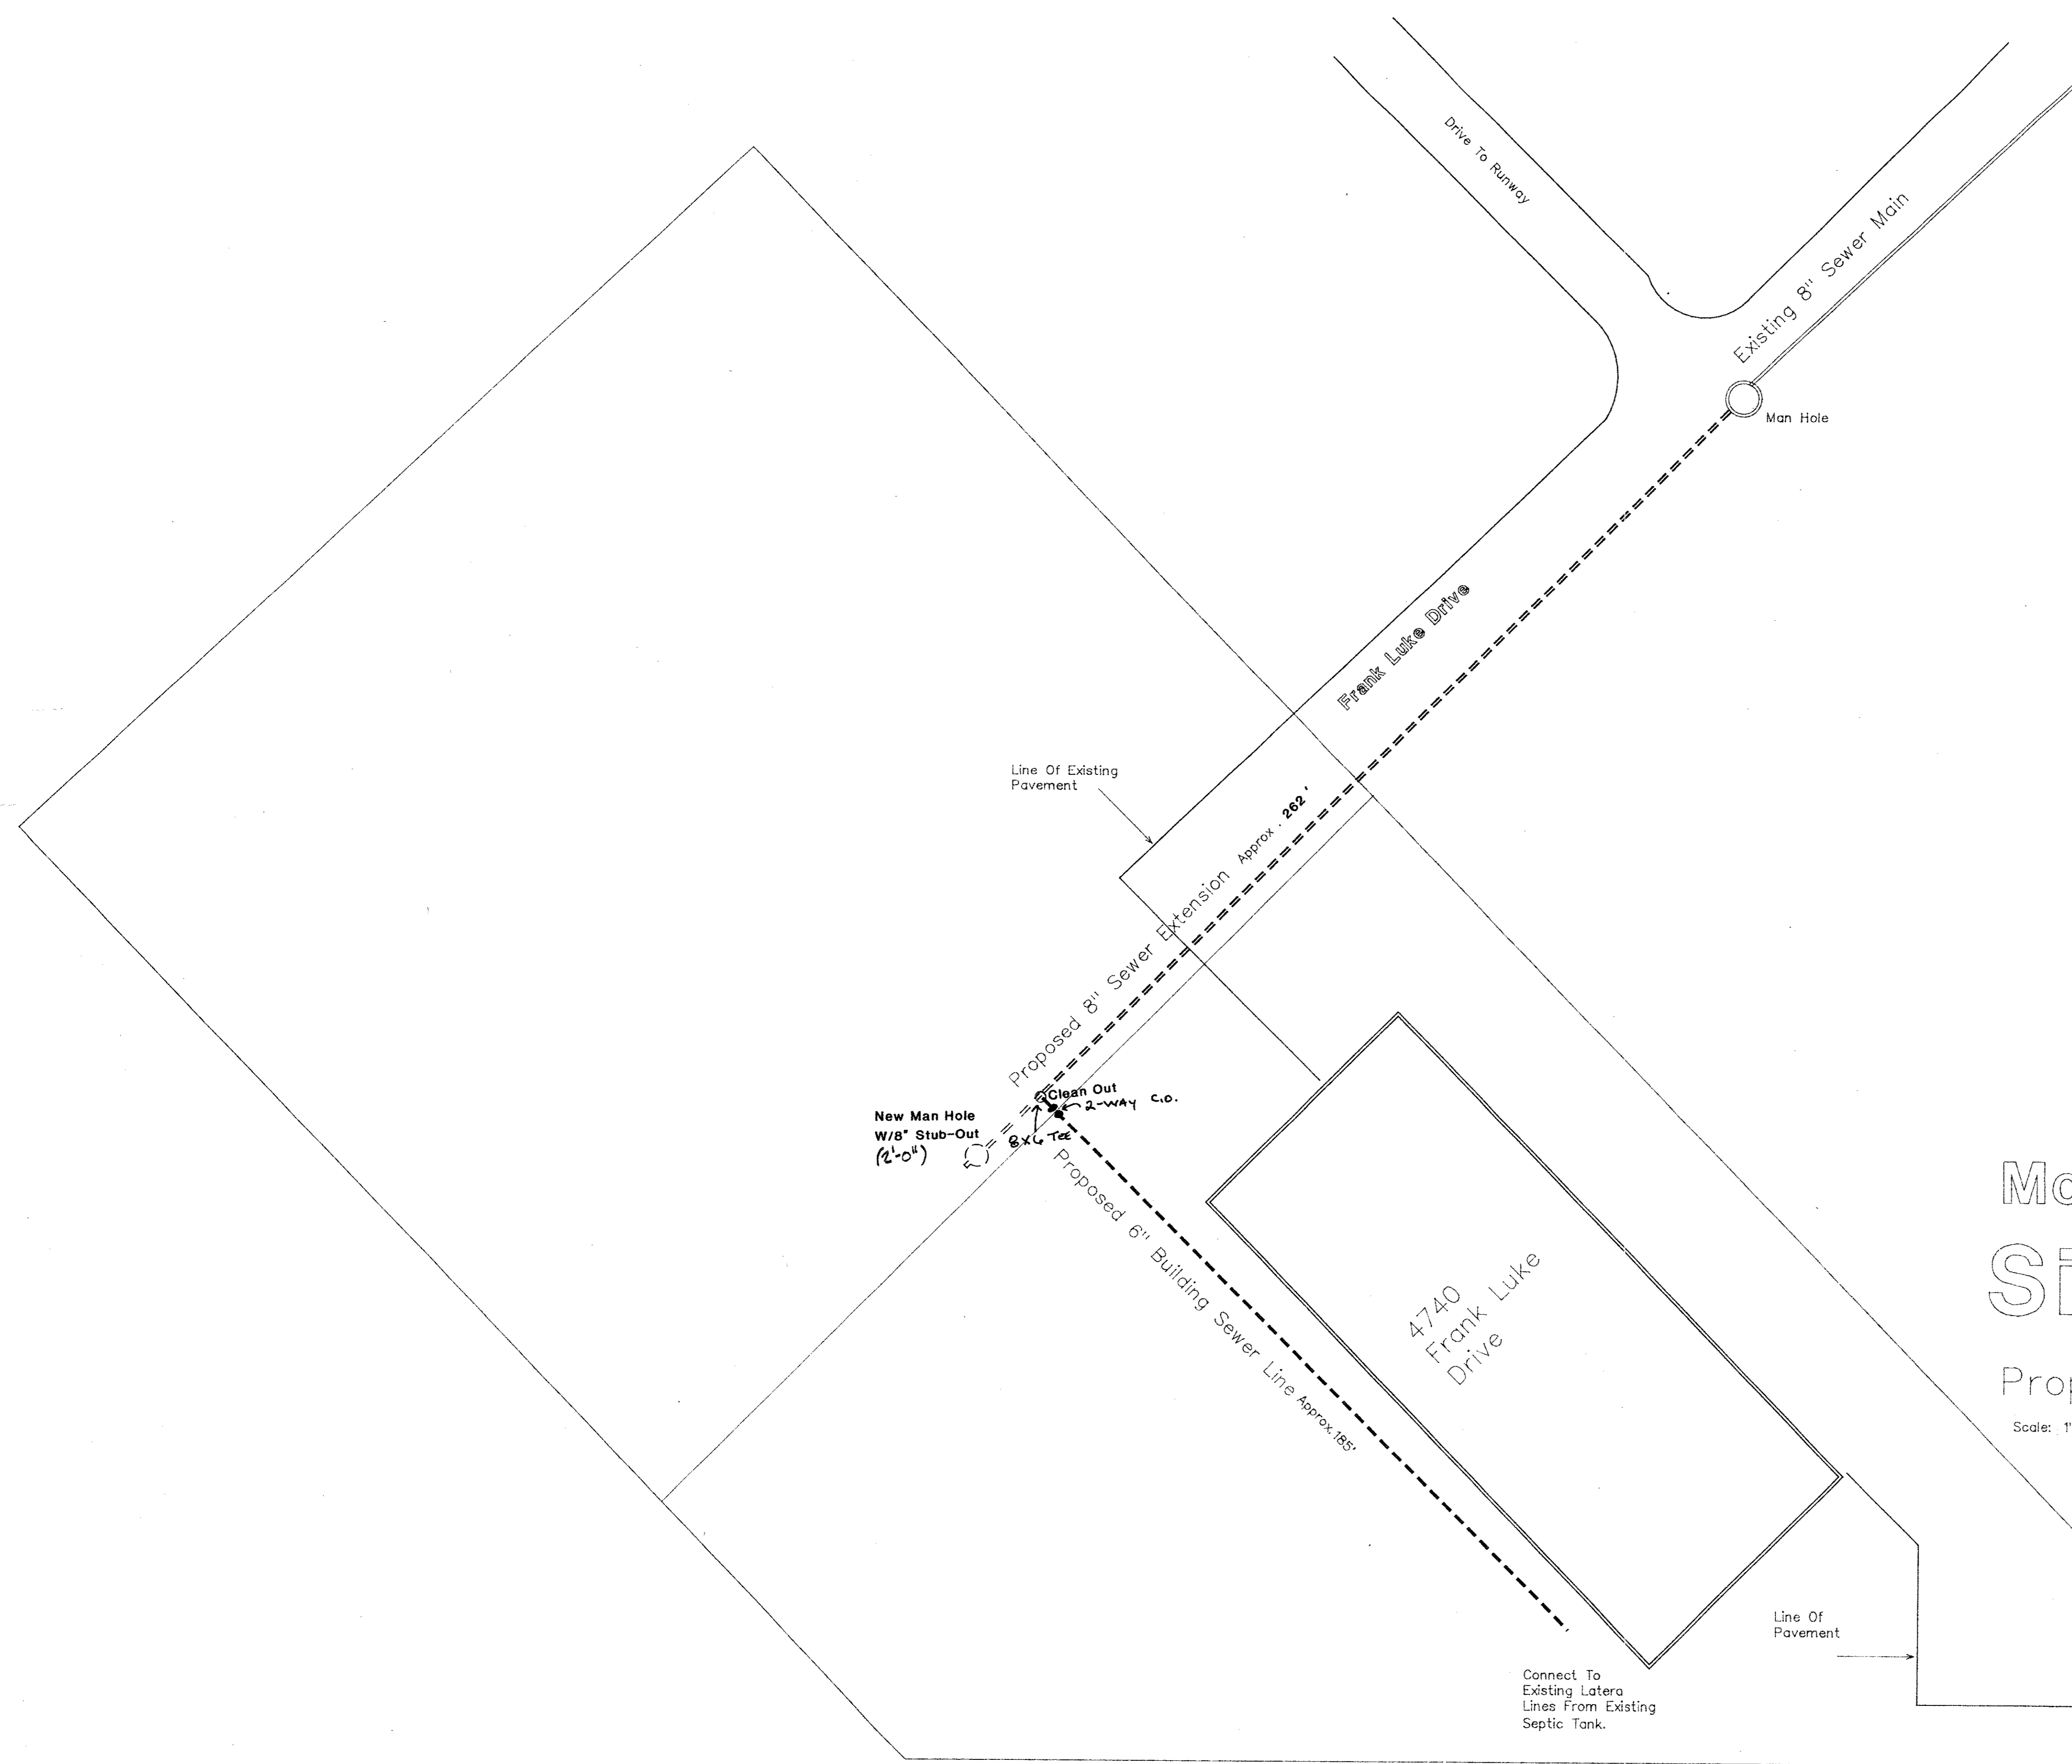

McKamy Air Site Plan

Proposed Sewer Line Extension

Scale: 1"=20'

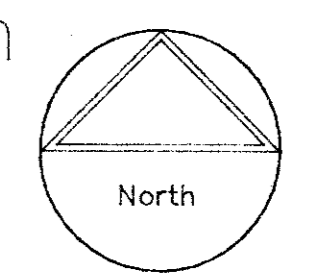

AS BUILT

Drawing Produced By

DH
DESIGNS
COMMERCIAL
SPACE PLANNING

214 985 0455
P.O. Box 86643
Plano, Texas 75086

Date: 6/1/89

Revised 6/23/89
Revised 6/28/89