


NOTE:
 CONTRACTOR TO VERIFY EXACT
 LOCATION OF ALL EXISTING UTILITIES
 BEFORE CONSTRUCTION BEGINS.

60 L.F. 8\"/>

- GENERAL NOTES
1. All construction will be as per City of Addison Specifications, on file with the Director of Utilities, Addison, Texas.
 2. Contractor is to provide 1 year maintenance bond for 10% of the completed construction amount.
 3. Encasement pipe shall have a minimum wall thickness of 3/8 inch, and conform to ASTM Spec. A.-34, Mild Steel or A-139, Grade A.
 4. Minimum cover shall be 48 inches.
 5. Fire hydrants w/valves will be furnished by City. Contractor is to provide all leads and connections necessary to place hydrants.
 6. All backfill shall be water jetted until water puddles appear on the surface and all settlement ceases.

AS-BUILT 5-5-82

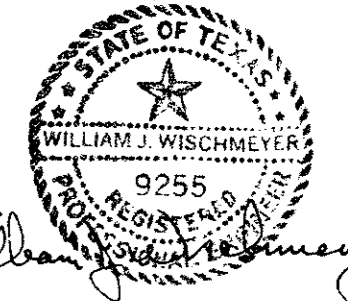

ADDISON MUNICIPAL AIRPORT			
PROPOSED 8" WATERLINE FOR CHAPARRAL AVIATION			
Riewe & Wischmeyer, Inc.		DESIGNED T.K.	
CONSULTING ENGINEERS		DRAWN S.M.	
DALLAS TEXAS		DATE NOV. 1981	
JOB NO. 81-6100	SCALE 1"=30'	SHEET NO 1 OF 1	

